




PLAT OF SURVEY

PART OF CARWELLS PARK

LOCATED IN PART OF THE NE 1/4 OF SECTION 35, TOWN 4 NORTH,
RANGE 16 EAST, TOWN OF LAGRANGE, WALWORTH COUNTY, WISCONSIN

Parcel 1: Commencing at an iron stake, said stake being 120 feet East of the Southwest corner of Block 1 of Carwells Park as platted and recorded in the Register of Deeds Office at Elkhorn, Wisconsin, and followed along the shore, thence Easterly 50 feet to an iron stake; thence Northerly 132 feet to an iron stake; thence Westerly 30 feet to an iron stake; thence Southerly 110 feet to place of beginning. Also the following described land lying Northerly and across a 20 foot roadway, commencing at an iron stake, said stake being 20 feet distant from the Northeast corner of the above described land and in line with the East side of same, thence Northerly 82 feet to an iron stake; thence Westerly 20 feet to an iron stake; thence Southerly 80 feet to an iron stake; thence Easterly 26 1/2 feet to the place of beginning. All of the above said lands being a portion of Section 35, T4N, R16E.

Parcel 2: A parcel of land which is a part of Lots 4 and 5, Block 1, Carwells Park Subdivision described as follows: Beginning at a point, which point is the intersection of the Northerly side of the 20 foot road running through said subdivision and the Northeastly line of said Lot 5 which point is the point of beginning. Thence North 41°15' West 72 feet to a stake; thence Westerly along the shore of the lake 41 feet more or less to the Northeast corner of land previously conveyed to B. A. Gilbertson; thence South 22°05' West 82 feet to the North line of said 20 foot road; thence Easterly along the North line of said Lot 68 feet to the place of beginning. (The above description is that shown in the Warranty Deed recorded in Volume 312 of Records, Page 243, Document No. 96040, Walworth County Records and was not changed to include the various differences between said description and the actual field survey).

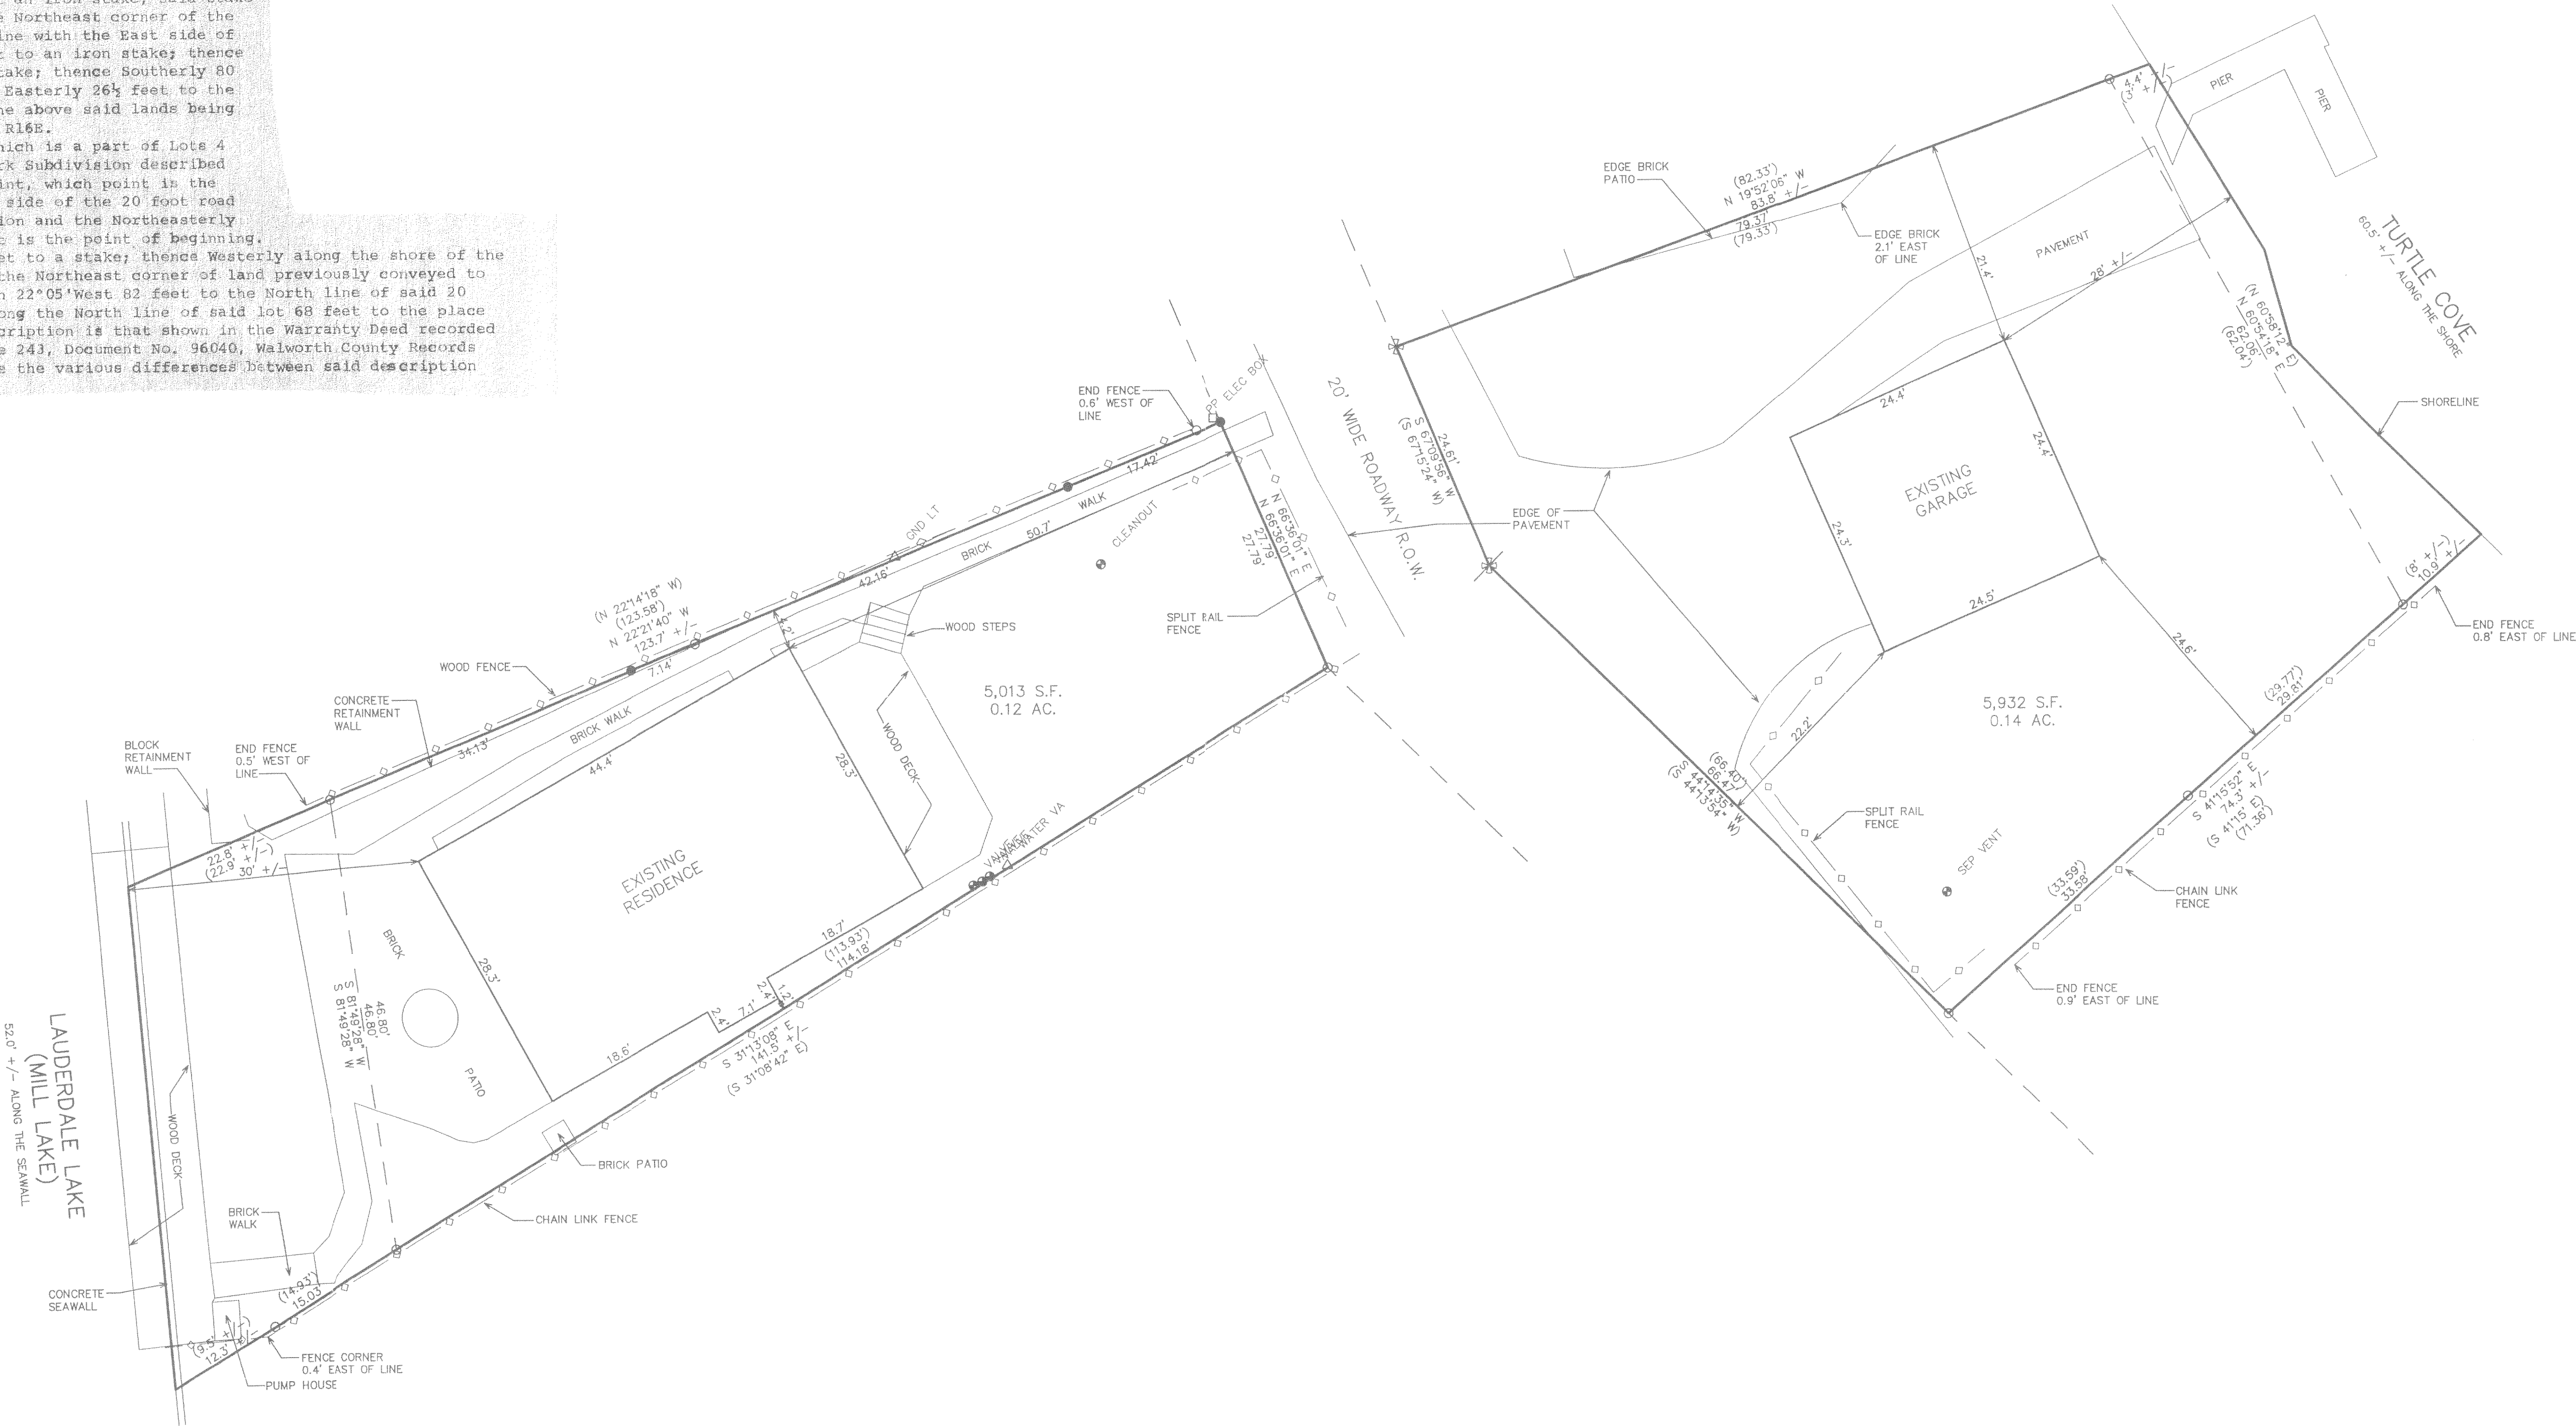


- LEGEND
- = FOUND IRON PIPE STAKE
 - = FOUND IRON REBAR STAKE
 - ⊗ = FOUND RAILROAD SPIKE IN PAVEMENT
 - ⊗ = SET RAILROAD SPIKE IN PAVEMENT
 - (XXX) = RECORDED AS

NOTE: COPIES OF THIS MAP TO WHICH THE FOLLOWING CERTIFICATE WILL APPLY SHOW THE SURVEYOR'S ORIGINAL SEAL AND SIGNATURE IN RED INK. COPIES BY ANY OTHER MEANS MAY HAVE ALTERATIONS WHICH DO NOT REPRESENT THE SURVEYOR'S WORK PRODUCT.

I HEREBY CERTIFY THAT THE ABOVE DESCRIBED PROPERTY HAS BEEN SURVEYED UNDER MY DIRECTION AND THAT THE ABOVE MAP IS A TRUE REPRESENTATION THEREOF AND SHOWS THE SIZE AND LOCATION OF THE PROPERTY AND ITS EXTERIOR BOUNDARIES. THIS SURVEY IS MADE FOR THE USE OF THE PRESENT OWNERS OF THE PROPERTY, AND ALSO THOSE WHO PURCHASE, MORTGAGE, OR GUARANTEE THE TITLE THERETO WITHIN ONE YEAR FROM THE DATE HEREOF.

DATED: APRIL 6, 2005

PETER S. GORDON R.L.S. 2101

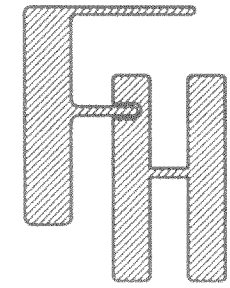

WORK ORDERED BY —
JOHN ZEDLER
624 N. SAND LANE
ELKHORN, WI 53121

FARRIS, HANSEN & ASSOCIATES, INC.
ENGINEERING — ARCHITECTURE — SURVEYING
7 RIDGWAY COURT P.O. BOX 437
ELKHORN, WISCONSIN 53121
OFFICE: (262) 723-2098 FAX: (262) 723-5886

REVISIONS

PROJECT NO.
6756
DATE
04/06/05
SHEET NO.
1 OF 1

46-803