


PREPARED FOR:
PAM MILLAR
HELP-U-SELL REAL ESTATE
PO. BOX 13 ELKHORN, WI.
53121

L.K. SURVEYING INC.
N3703 WILLOWBEND LANE
LAKE GENEVA, WI, 53147
262-248-3697

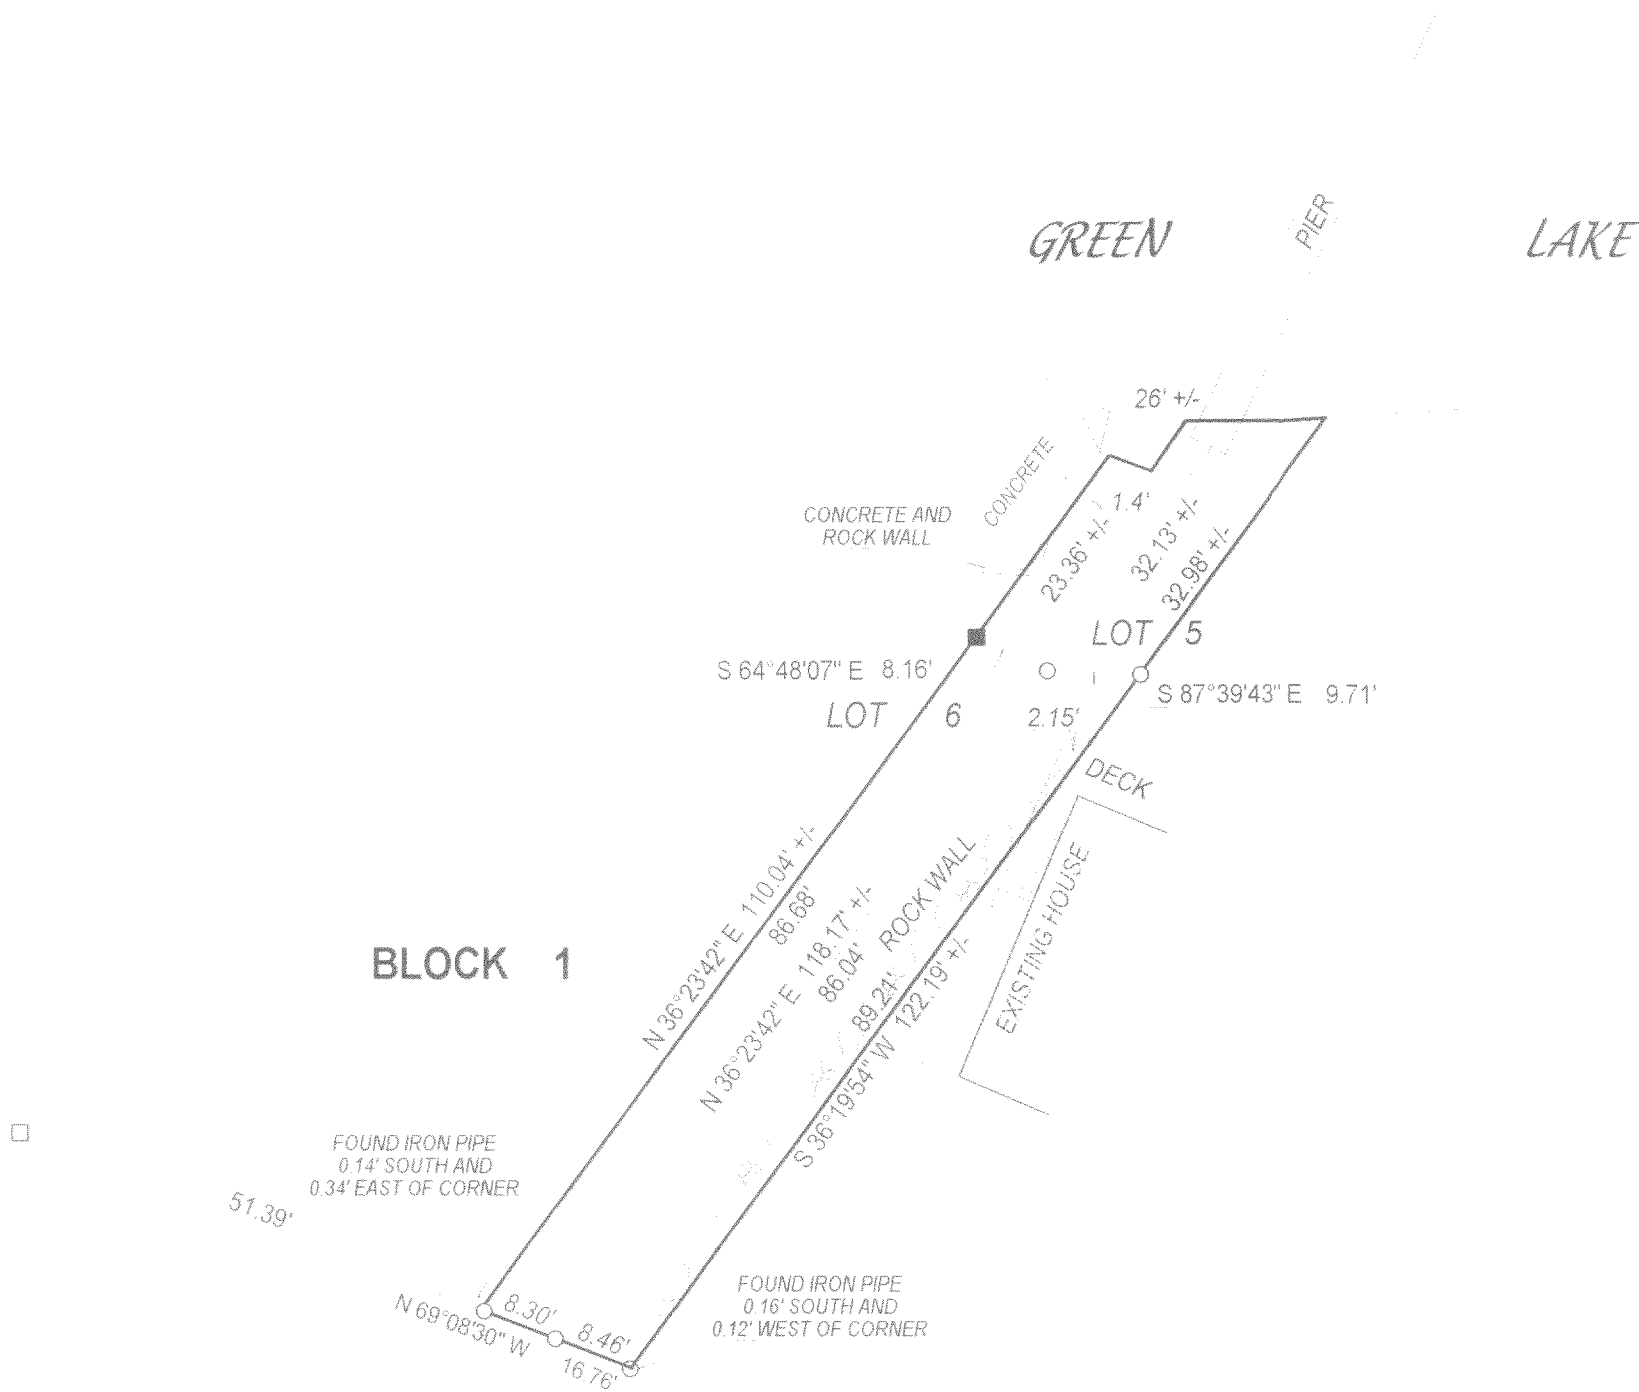


PLAT OF SURVEY

- OF -

A PARCEL OF LAND LOCATED IN BLOCK 4, GREEN LAKE PARK, TOWN 4 NORTH, RANGE 16 EAST, WALWORTH COUNTY, WISCONSIN AND DESCRIBED AS FOLLOWS: TO-WIT: COMMENCING AT THE INTERSECTION OF THE SOUTH LINE OF THE SOUTH SHORE DRIVE AND THE EAST LINE OF SAID BLOCK 4; THENCE NORTH 81°27' WEST, 120.10 FEET ALONG THE SOUTH LINE OF SOUTH SHORE DRIVE, TO THE PLACE OF BEGINNING; THENCE CONTINUE NORTH 81°27' WEST 109.55 FEET; THENCE SOUTH 11°17' WEST 129.52 FEET; THENCE SOUTH 83°34' EAST 120.10 FEET; THENCE NORTH 6°33' EAST 123.75 FEET TO THE PLACE OF BEGINNING.

TOGETHER WITH THE RIGHT TO USE IN COMMON WITH OTHER OWNERS OF THE PROPERTY IN GREEN LAKE PARK A RIGHT-OF-WAY 16 FEET IN WIDTH TO THE LAKE BETWEEN LOTS 5 AND 6 IN BLOCK 1 OF SAID GREEN LAKE PARK.

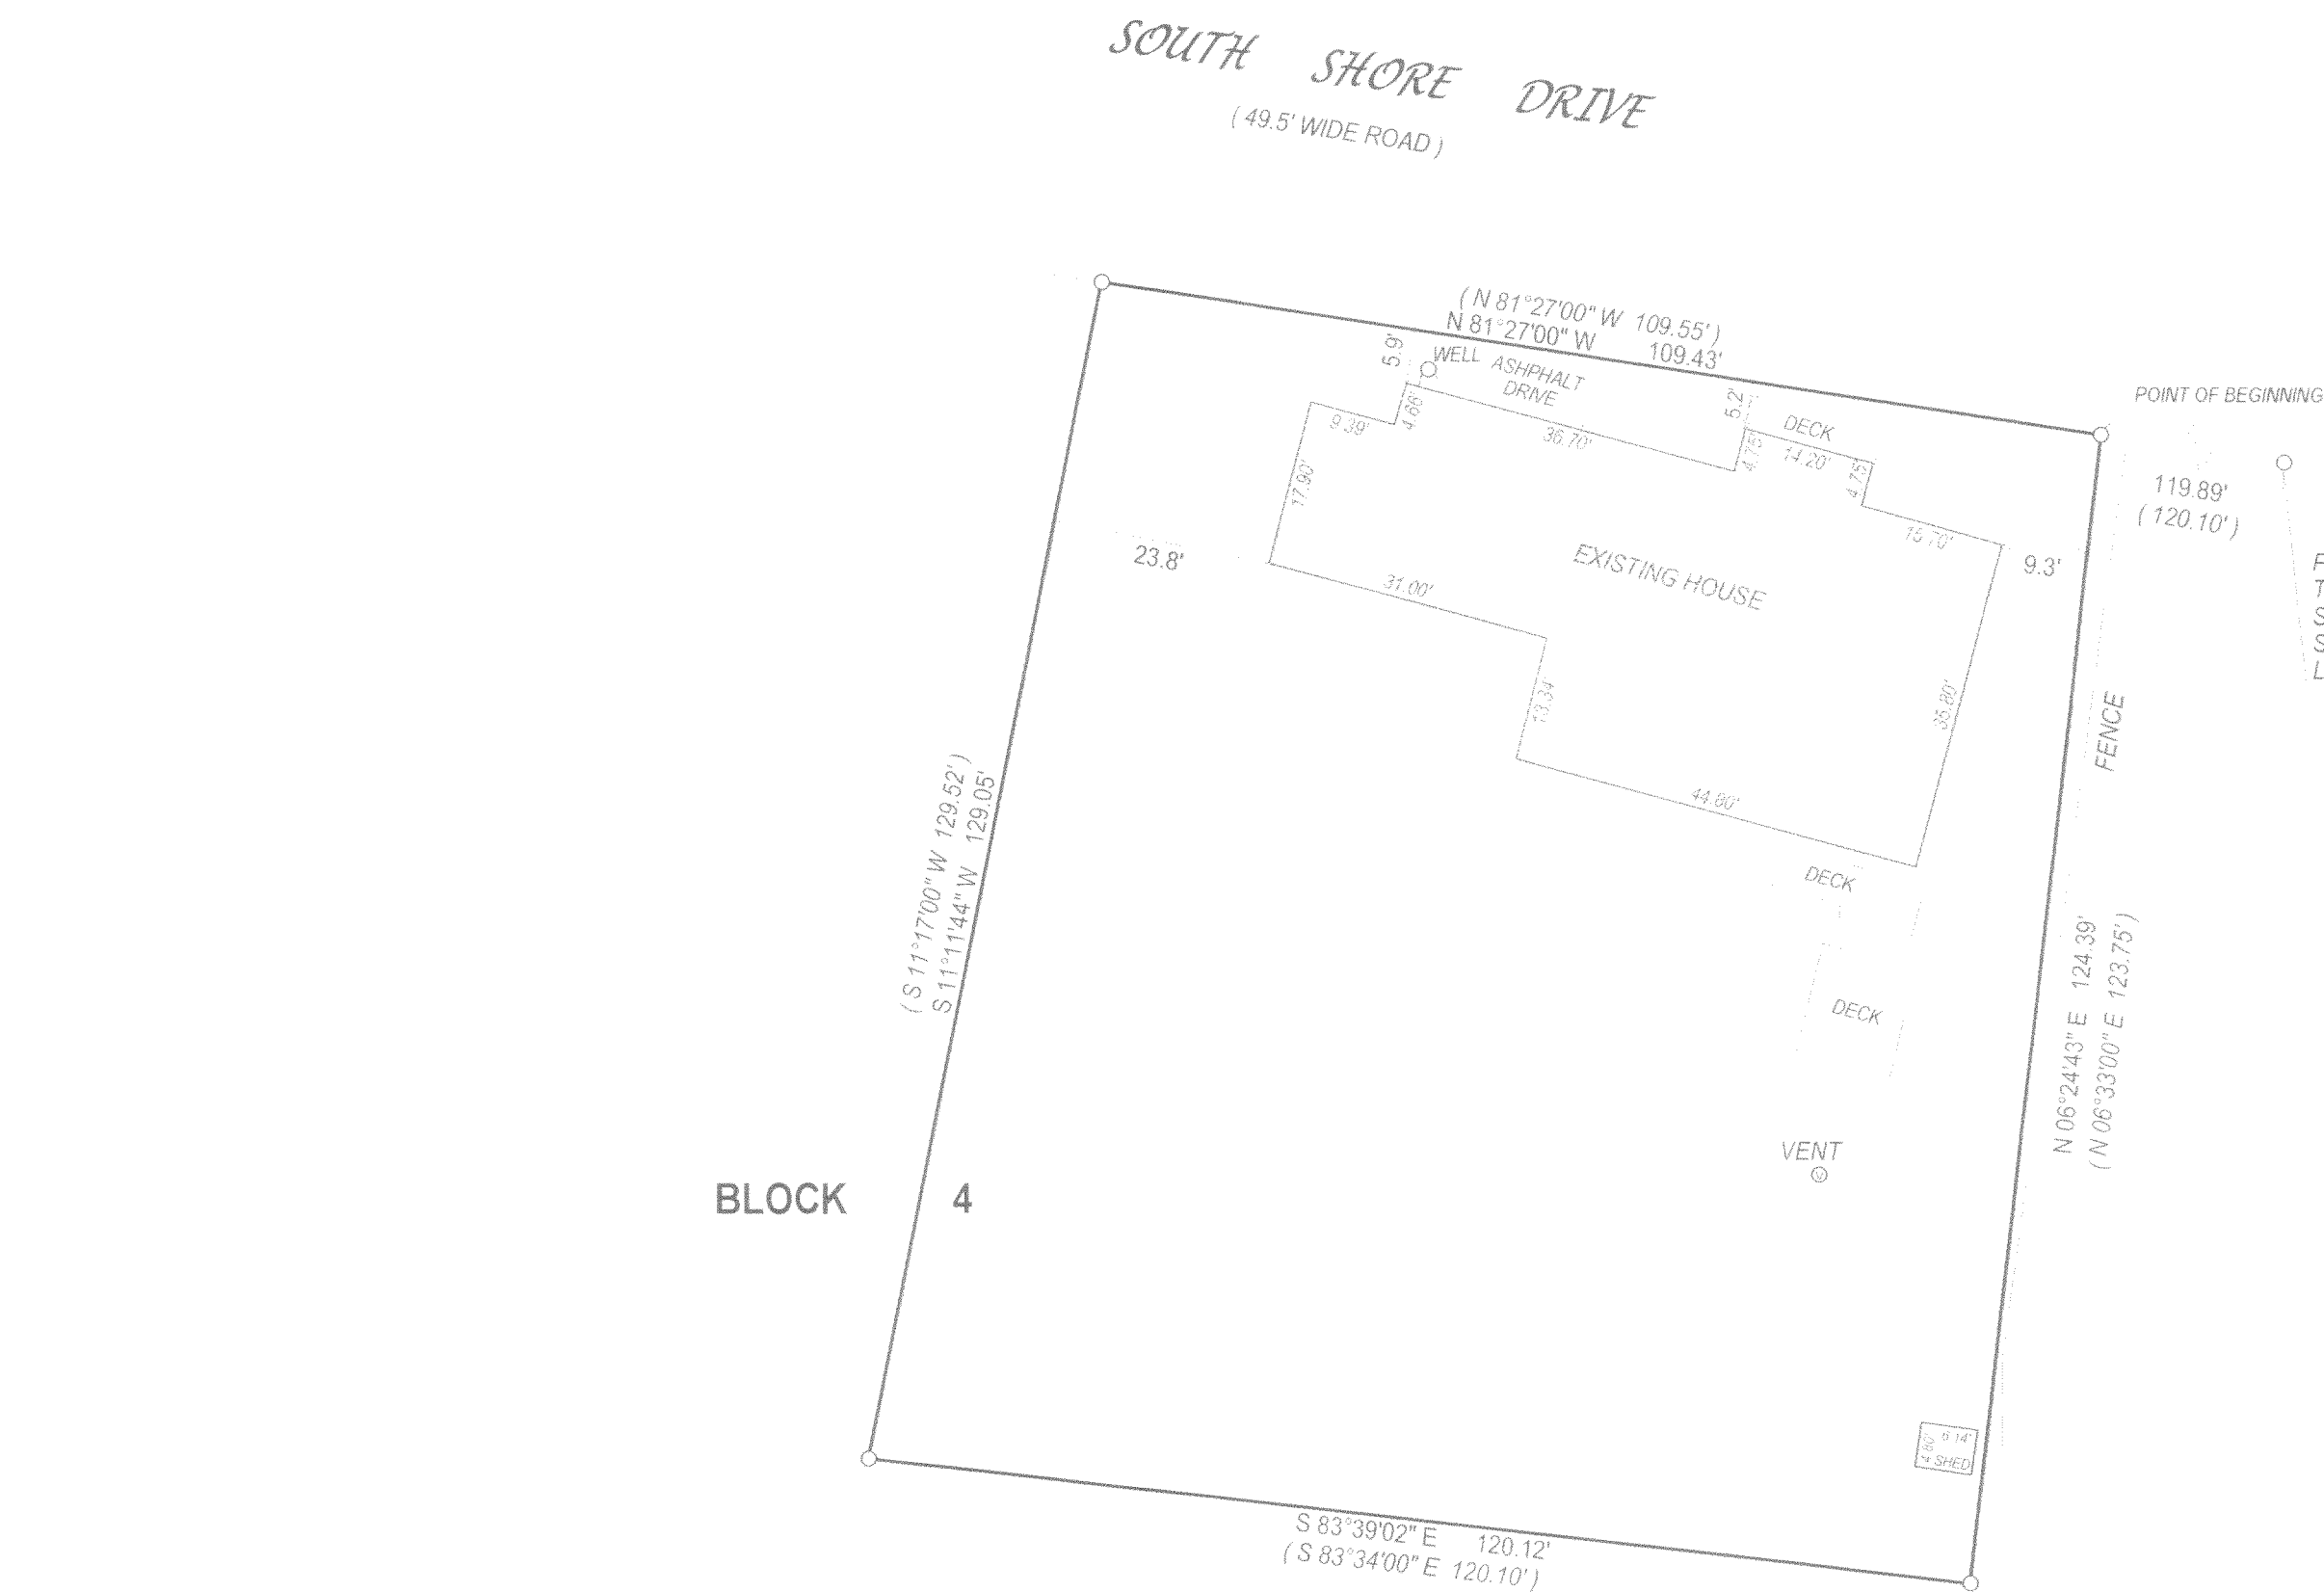


POINT DESCRIBED AS BEING THE INTERSECTION OF THE SOUTH LINE OF THE SOUTH SHORE DR. AND THE EAST LINE OF BLOCK 4.

- () = recorded as
- = found iron bar
- = found iron pipe
- = set iron pipe
- = set iron bar

SCALE 1" = 20'

JOB # 05-112


TAX ID # HGP00020

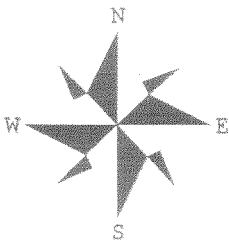

COMPARE LEGAL DESCRIPTION ABOVE AND DRAWING WITH DEED, FOR BUILDING RESTRICTIONS AND EASEMENTS NOT SHOWN REFER TO DEED, ABSTRACT SOURCES AND LOCAL MUNICIPAL CODES. NOTIFY THE SURVEYOR IMMEDIATELY OF ANY DISCREPANCY.

"I hereby certify that I have surveyed the above described property and that the above map, to the best of my knowledge and belief, is a true representation thereof and shows the size and location of all visible structures, apparent easements and encroachments if any."

This survey is made for the present owners of the property, and those who purchase, mortgage, or guarantee the title thereto, within one year from the date hereof.

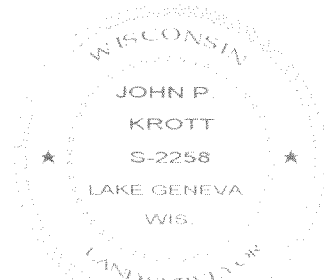

JOHN KROTT S - 2258
Wisconsin Registered Land Surveyor
(original if signed in red)

DATED THIS THE 24th DAY OF MARCH 2005.

10-2117