

of
Lots 1 and 2 of La Selva,
a subdivision located in the Fractional Southeast 1/4 of
Section 26, Town 4 North, Range 16 East, Town of LaGrange,
Walworth County, Wisconsin.

Bearings reference to
the plot of La Selva

Lake

100 year flood boundary elevation
of 886 as shown on Flood Insurance
Rate Map Community-Panel 550462
0020 B dated August 15, 1983.
Falls within 1' of shoreline

Lot 15	Lot 14
Maywoods	
Subdivision	

Tax Parcel
HLG 2600029
Forest Preserve

Tax Parcel
HLG 2600028
1.248 Acres
54,383 Sq.Ft.

Copyright © 2005 by Jensen & Olson Land Surveying, LLC.
All rights reserved. No part of this survey plat may be reproduced or transmitted in any form by any means - graphic, electronic, or mechanical, including photocopying, tracing, or information storage and retrieval systems - without permission in writing from Douglas G. Olson, Jensen & Olson Land Surveying, LLC.

I hereby certify that I have surveyed the above described property and the map hereon is correct to the best of my professional knowledge and belief and shows the size and location of the property, its exterior boundaries, the location and dimensions of all visible structures thereon, boundary fences, apparent easements and roadways and visible encroachments, if any.

This survey is made for the exclusive use of the present owners of property and also those who purchase mortgage or guarantee title thereto, within one year from the date hereof.

Notes: 1) This survey plat is not certified unless signed and sealed in red ink.

2) This survey is subject to Wisconsin lien laws. This Plat of Survey is the notice of intent to file lien. Lien waiver required.

Douglas G. Olson
Wisconsin Registered Land Surveyor - 2093

Sheet. 1 of 1 Sheets.

Job Reference Number

2005.094

Legend

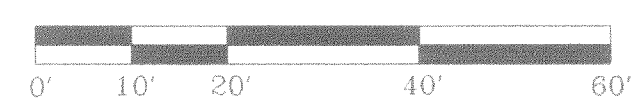
- ✕ Found Iron Pipe
 ● Found Iron Rod
 ● Found Railroad Spike
 □ Set Iron Rod, 3/4" dia. unless noted
 () Recorded Information
 ○ Concrete Cover
 ○ Septic Vent
 ✕ Utility Pole
 Asphalt Surface
 Concrete Surface
 ☒ Storm Drain
 ● Deciduous Tree
 ● Coniferous Tree
 * Gravel Surface



Jensen & Olson Land Surveying, LLC

45 South Wisconsin Street P.O. Box 322
Elkhorn, Wisconsin. 53121
Telephone: (262) 723-3434
Facsimile: (262) 723-8044

Scale in Feet

$$1'' = 20'$$


Survey date: June 17, 2005.

Revisions: No. 1 - Trees and Topo

2005.094