


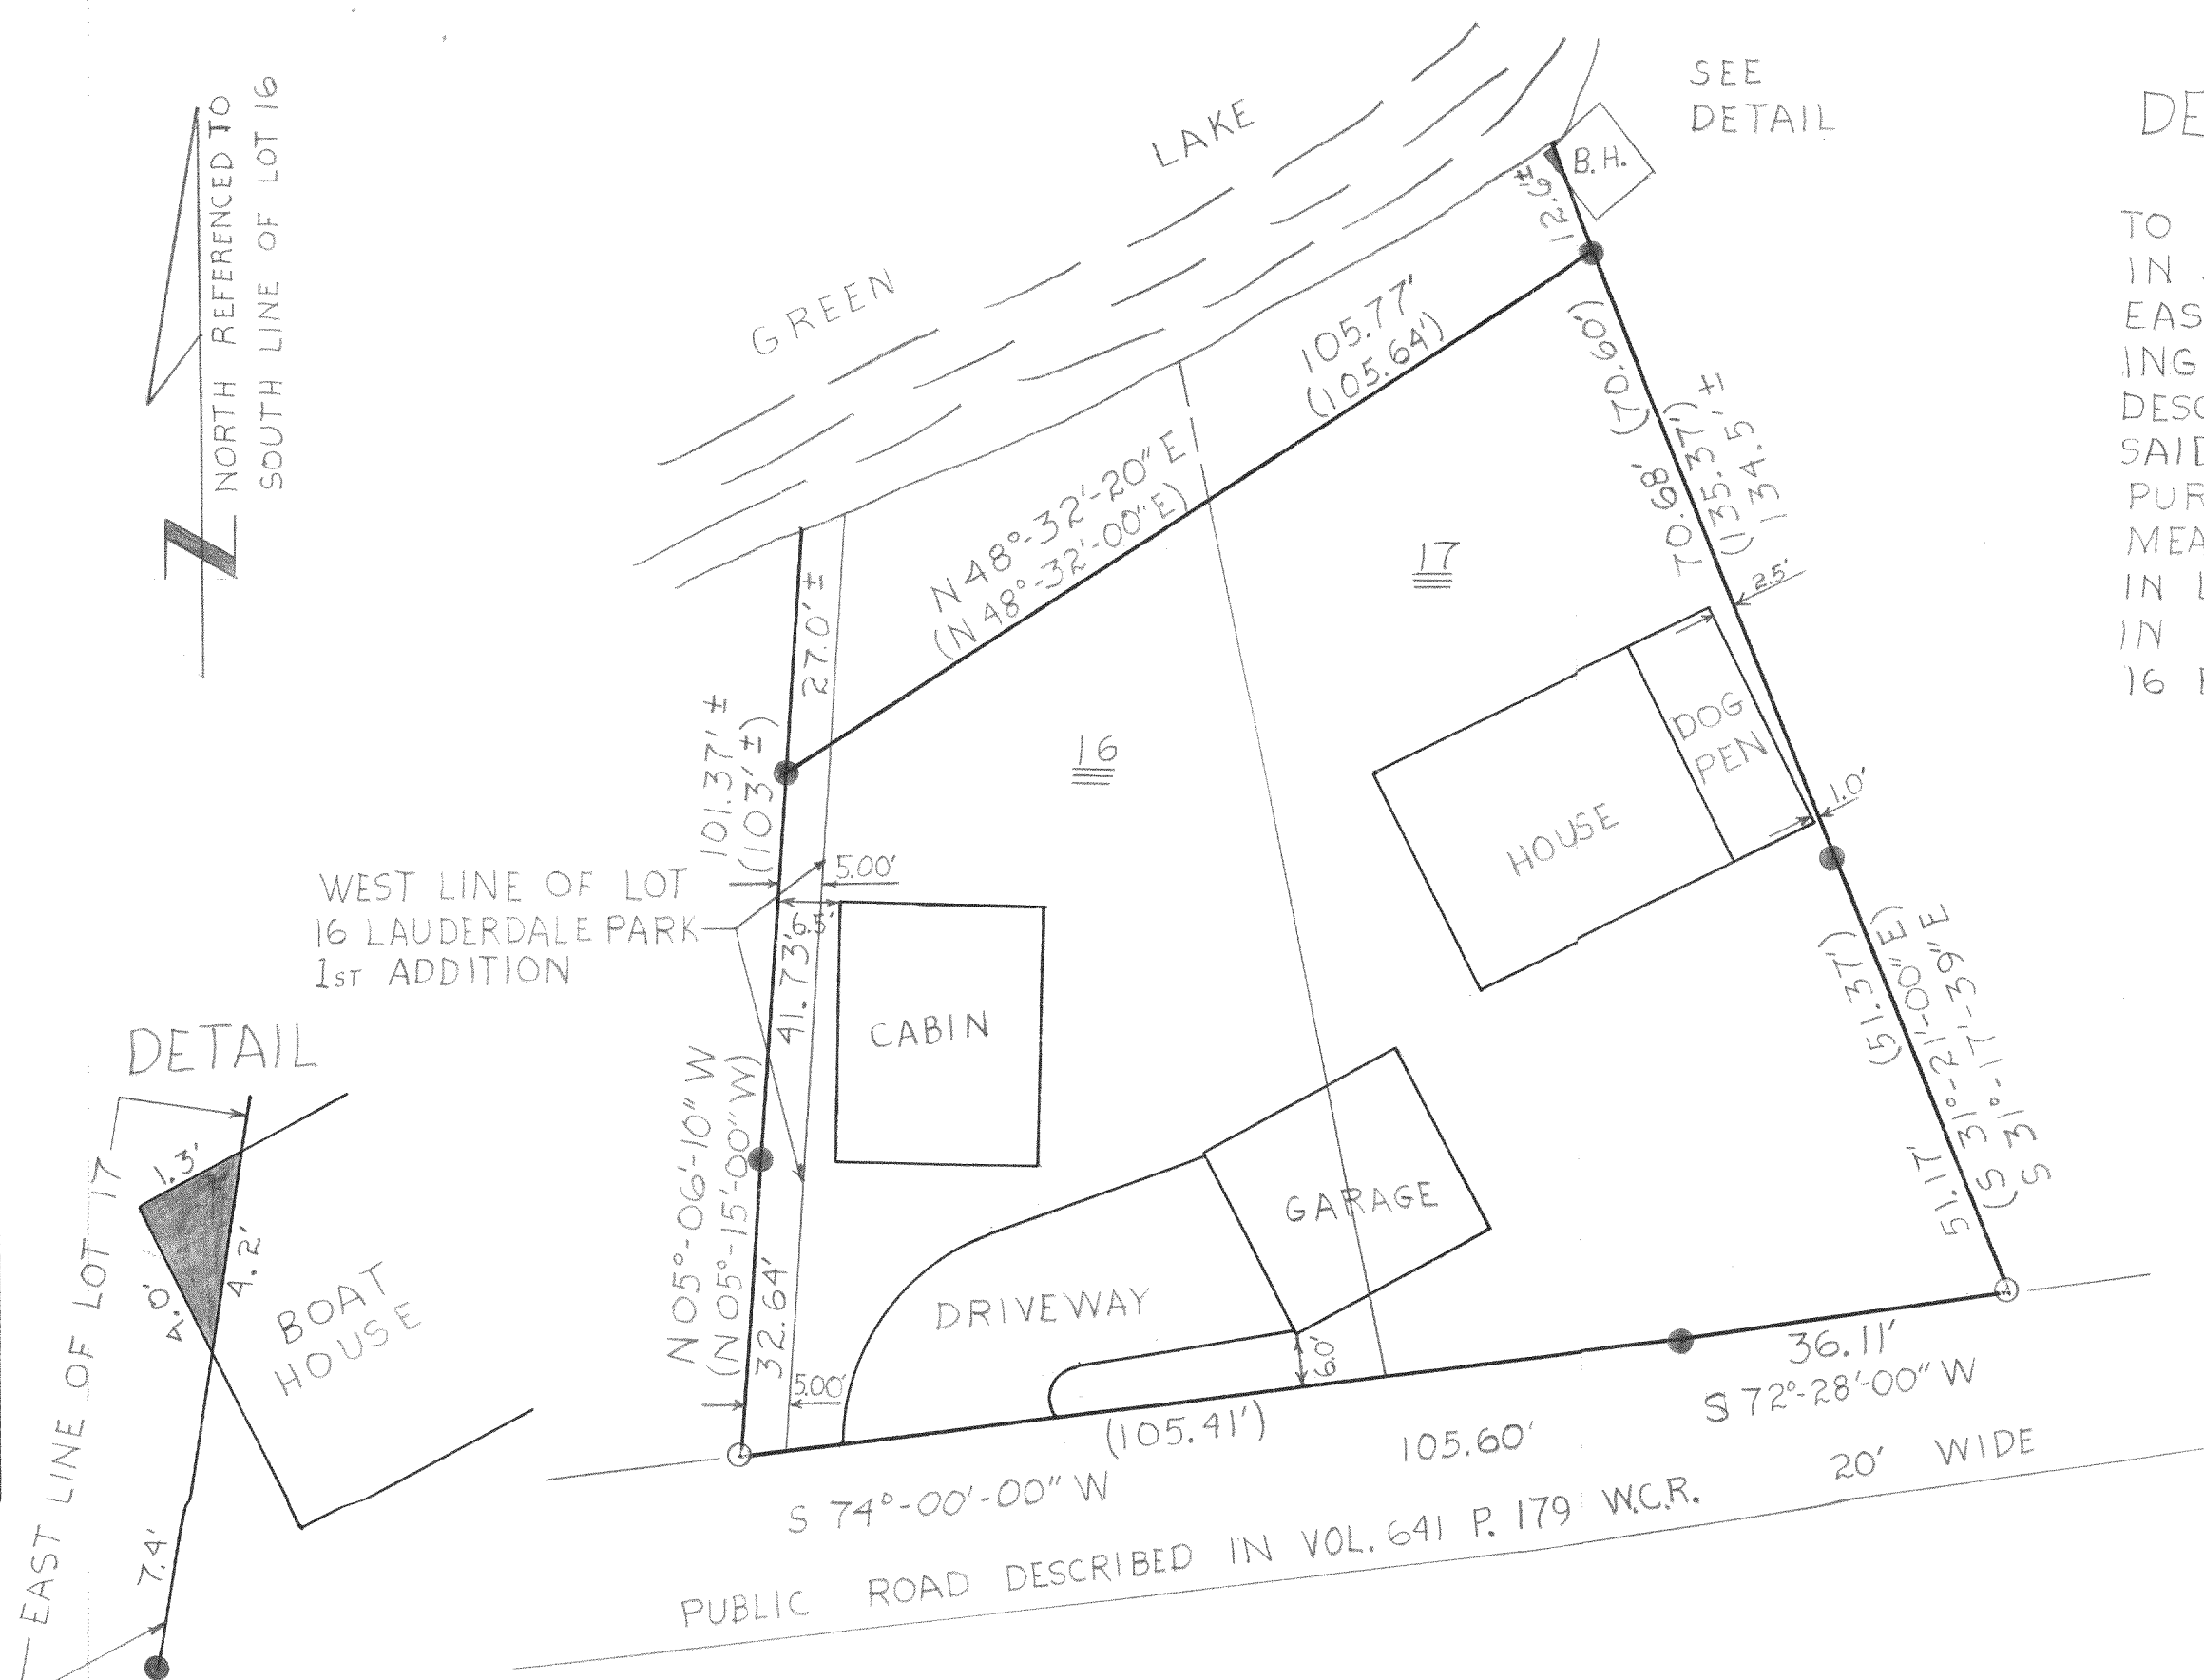


DESCRIPTION:
 LOTS 16 AND 17, IN THE 1ST ADDITION TO LAUDERDALE PARK SUBDIVISION, LOCATED IN SECTION 25, TOWN 4 NORTH, RANGE 16 EAST, WALWORTH COUNTY, WISCONSIN, EXCEPTING THEREFROM A PARCEL OF LAND DESCRIBED IN VOL. 641, P. 179 OF THE W.C.R, SAID PARCEL TO BE USED FOR ROAD PURPOSES. ALSO THE EAST 5.00' FEET, AS MEASURED AT RIGHT ANGLES TO EAST LINE, LOT 6 IN LAUDERDALE PARK SUBDIVISION, LOCATED IN SECTION 25, TOWN 4 NORTH, RANGE 16 EAST, WALWORTH COUNTY, WISCONSIN.

- LEGEND
- IRON PIPE FOUND
 - IRON PIPE SET
 - () RECORDED AS
 - ENCROACHMENT


DATE: DECEMBER 10, 1975

CERTIFICATE:
 I, JOSEPH M. BIAGI, SURVEYOR, DO HEREBY CERTIFY THAT I HAVE SURVEYED THE LANDS HEREON DESCRIBED.

Joseph M. Biagi
 JOSEPH M. BIAGI R.L.S. # 12

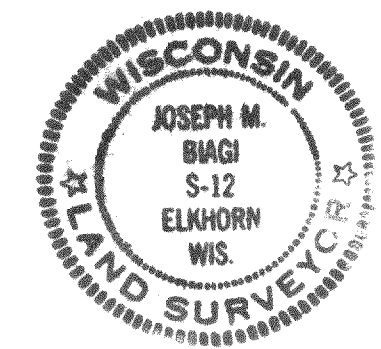

REVISIONS			WALTER BUSH JR.		
NO.	DATE	BY			
1			LOTS 16+17 LAUDERDALE PARK 1 ST		
2			ADD. AND EAST 5' LOT 6 LAUDERDALE PARK		
3			DRAWN BY	SCALE 1"=20'	MATERIAL
4			CHK'D	DATE 12-10-75	DRAWING NO.
5			TRACED	APP'D	#124-75

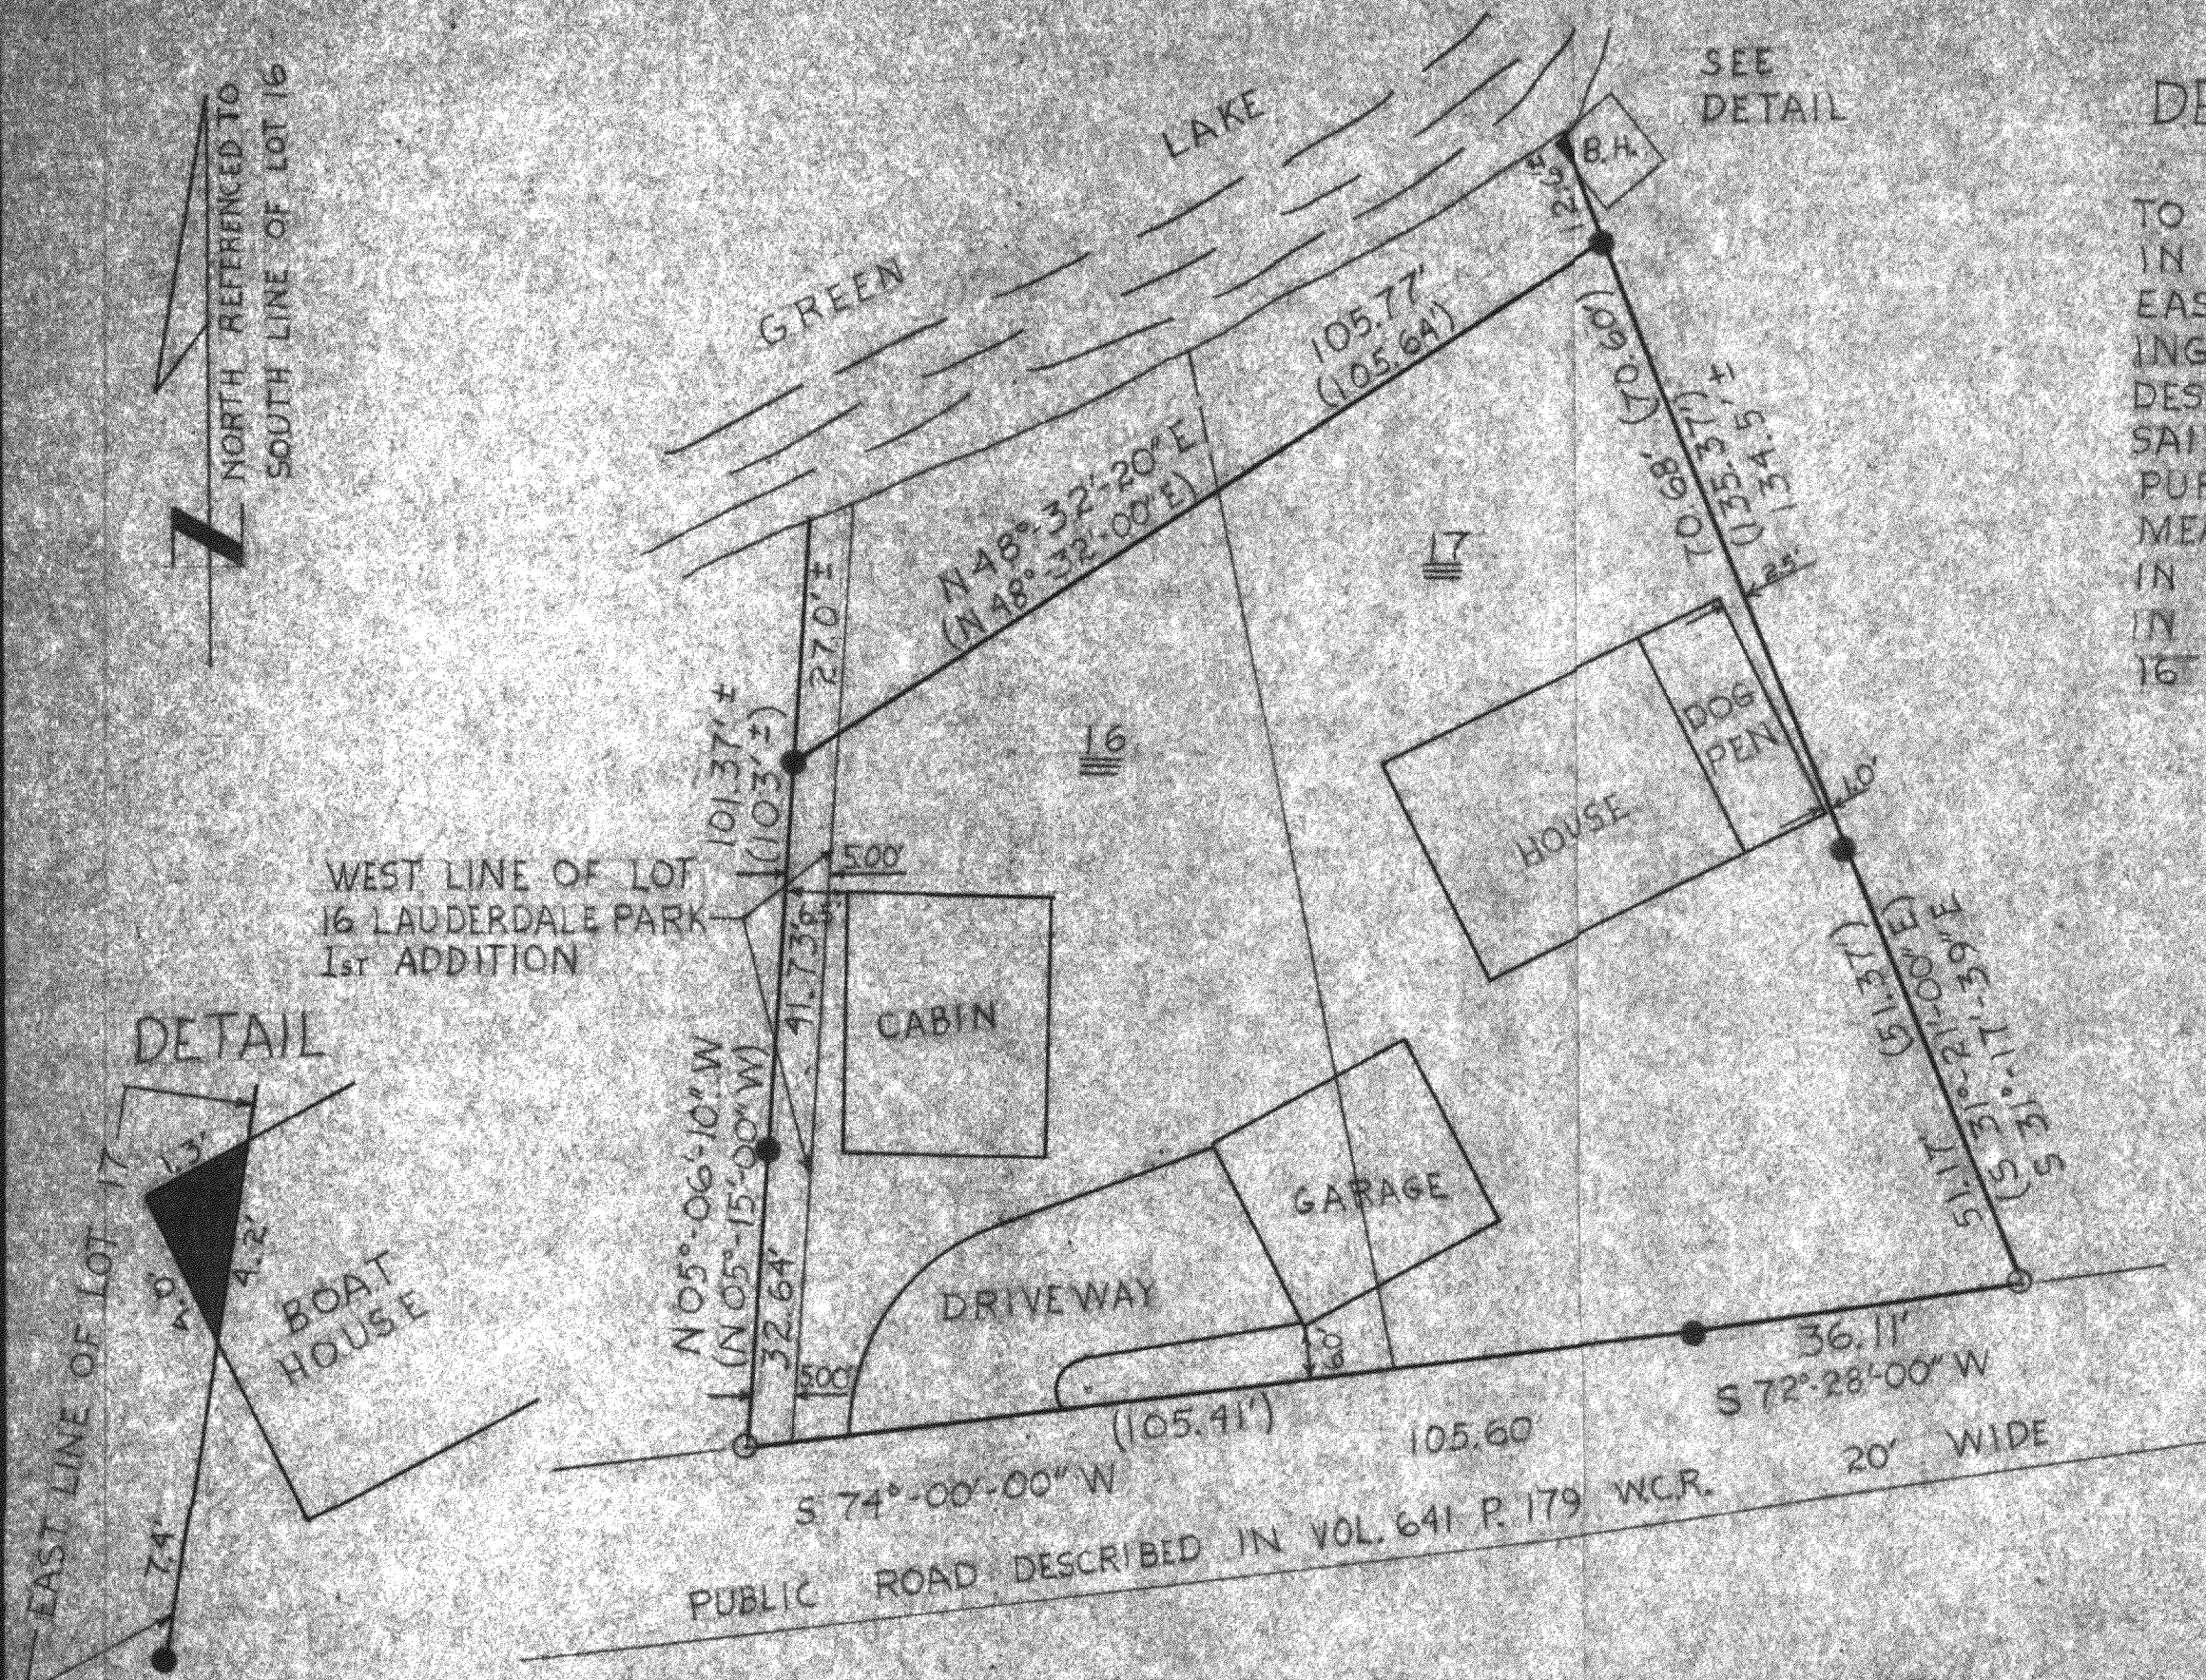

DESCRIPTION:

LOTS 16 AND 17, IN THE 1ST ADDITION TO LAUDERDALE PARK SUBDIVISION, LOCATED IN SECTION 25, TOWN 4 NORTH, RANGE 16 EAST, WALWORTH COUNTY, WISCONSIN. EXCEPTING THEREFROM A PARCEL OF LAND DESCRIBED IN VOL. 641, P. 179 OF THE W.C.R., SAID PARCEL TO BE USED FOR ROAD PURPOSES. ALSO THE EAST 5.00 FEET, AS MEASURED AT RIGHT ANGLES TO EAST LINE, LOT 6 IN LAUDERDALE PARK SUBDIVISION, LOCATED IN SECTION 25, TOWN 4 NORTH, RANGE 16 EAST, WALWORTH COUNTY, WISCONSIN.

- LEGEND**
- IRON PIPE FOUND
 - IRON PIPE SET
 - () RECORDED AS
 - ENCROACHMENT

DATE: DECEMBER 10, 1975

CERTIFICATE:

I, JOSEPH M. BIAGI, SURVEYOR, DO HEREBY CERTIFY THAT I HAVE SURVEYED THE LANDS HEREON DESCRIBED.

Joseph M. Biagi
 JOSEPH M. BIAGI R.L.S. # 12



REVISIONS			WALTER BUSH JR.		
NO.	DATE	BY	LOTS 16+17 LAUDERDALE PARK 1ST ADD. AND EAST 5' LOT 6 LAUDERDALE PARK		
1			DRAWN BY	SCALE	MATERIAL
2			HWG	1"=20'	
3			CHK'D	DATE	DRAWING NO.
4				12-10-75	#124-75
5			TRACED	APPRO	