


ENGINEERING — ARCHITECTURE — SURVEYING
7 RIDGWAY COURT — P.O. BOX 437 — ELKHORN, WISCONSIN 53121
PHONE: (262) 723-2098 FAX: (262) 723-5886

LOT 1 AND PART OF LOT 15 OF PLEASANT POINT, A SUBDIVISION
LOCATED IN PART OF SECTION 36, TOWN 4 NORTH,
RANGE 16 EAST, TOWN OF LA GRANGE,
WALWORTH COUNTY, WISCONSIN

RECEIVED
FEB 24 1964
8m~

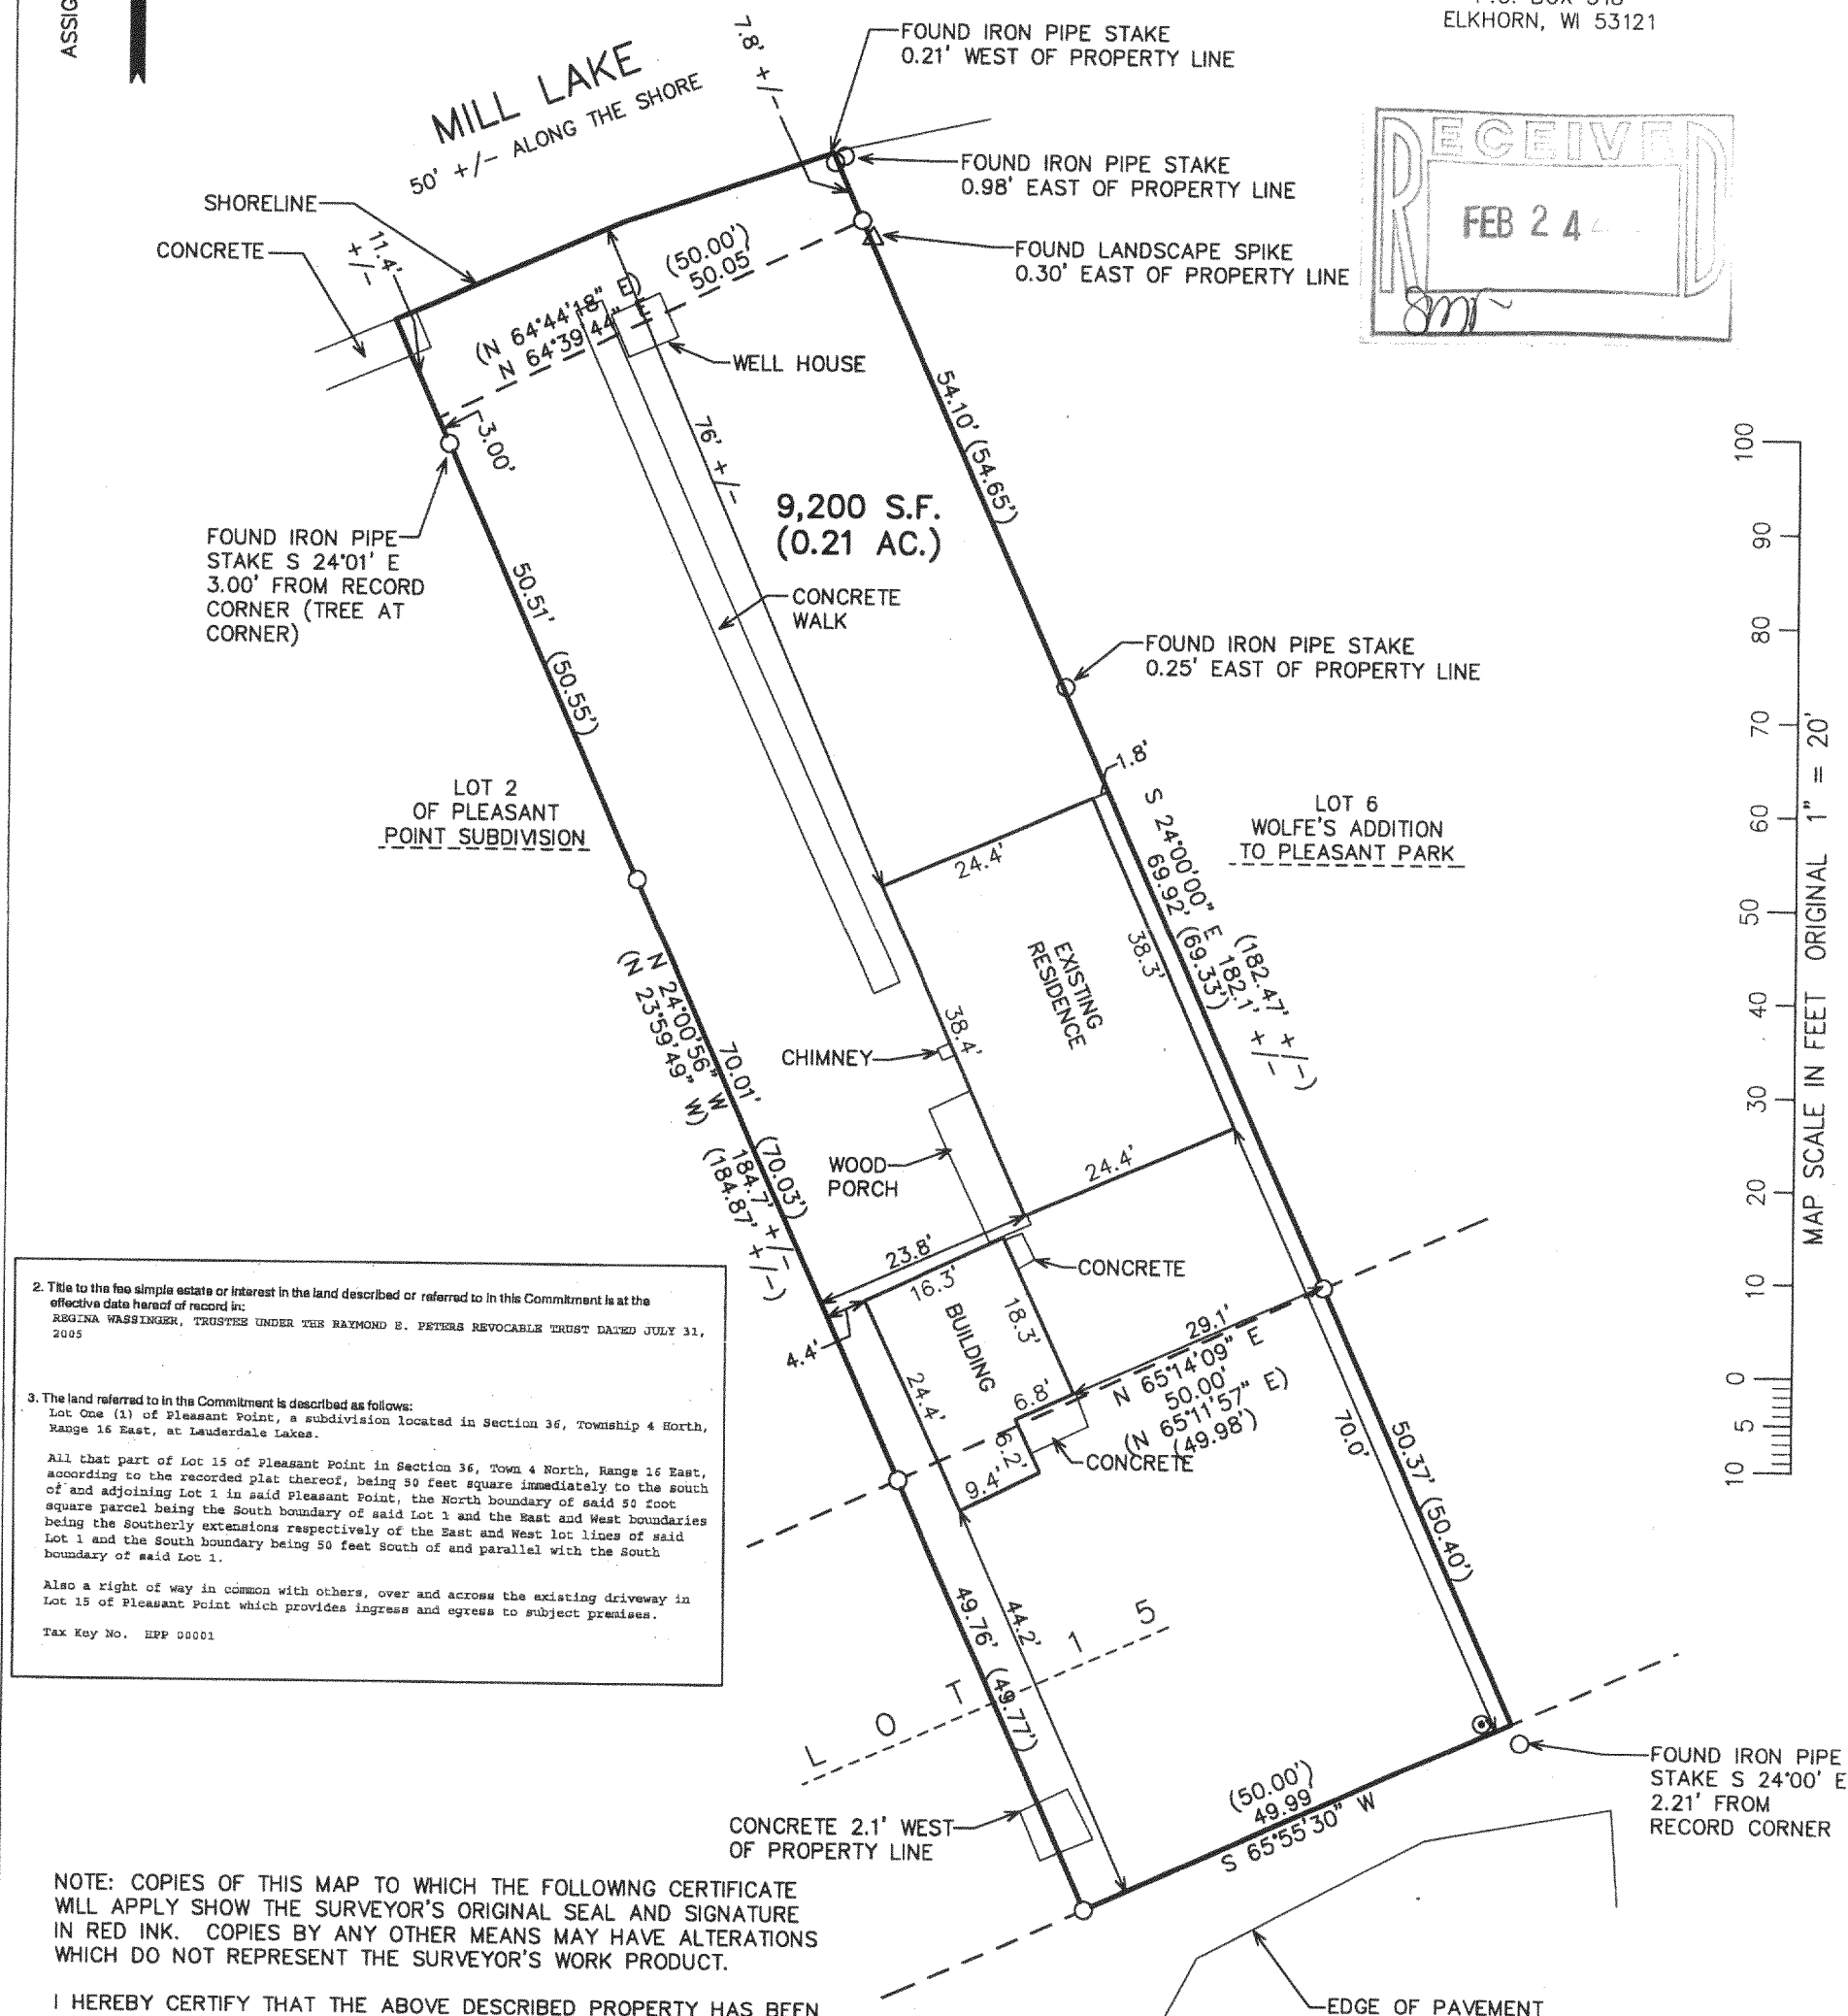

NOTE: COPIES OF THIS MAP TO WHICH THE FOLLOWING CERTIFICATE
WILL APPLY SHOW THE SURVEYOR'S ORIGINAL SEAL AND SIGNATURE
IN RED INK. COPIES BY ANY OTHER MEANS MAY HAVE ALTERATIONS
WHICH DO NOT REPRESENT THE SURVEYOR'S WORK PRODUCT.

I HEREBY CERTIFY THAT THE ABOVE DESCRIBED PROPERTY HAS BEEN SURVEYED UNDER MY DIRECTION AND THAT THE ABOVE MAP IS A TRUE REPRESENTATION THEREOF AND SHOWS THE SIZE AND LOCATION OF THE PROPERTY AND ITS EXTERIOR BOUNDARIES. THIS SURVEY IS MADE FOR THE USE OF THE PRESENT OWNERS OF THE PROPERTY, AND ALSO THOSE WHO PURCHASE, MORTGAGE, OR GUARANTEE THE TITLE THERETO WITHIN ONE YEAR FROM THE DATE HEREOF.

DATED: FEBRUARY 2, 2006

PETER S. GORDON R.L.S. 2101

LEGEND

○ = FOUND IRON PIPE STAKE

△ = FOUND LANDSCAPE SPIKE

(XXX) = RECORDED AS

PROJECT: 6977
DATE: 02/02/2006
SHEET 1 OF 1

2/13/2006 X:\Projects\6977\Dcad\SURVEY

14 PP -

416-2175