



Plat of Survey

of

Lot 18 of Block 2 of Pebble Beach,

a subdivision located in the Northwest 1/4 of Section 25,
Town 4 North, Range 16 East, Town of LaGrange, Walworth
County, Wisconsin.

Surveyed for: **Ken Kaleta**
12265 Arlington Drive
Huntley, Illinois 60142

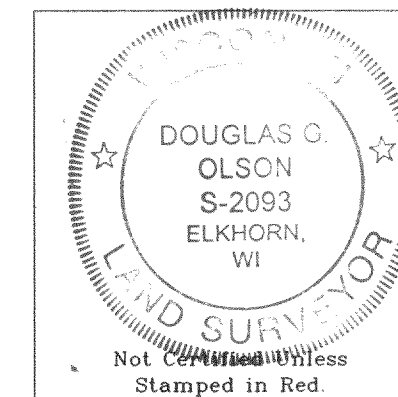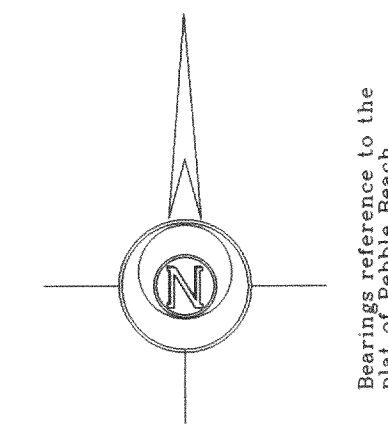

Redd
MAY 11 2006
SMF

Notes: 1) This survey plat is not
certified unless signed
and sealed in red ink.

2) This survey is subject to Wisconsin lien laws.
This Plat of Survey is the notice of intent
to file lien. Lien waiver required.


Copyright © 2006 by Jensen & Olson Land Surveying, LLC.

All rights reserved. No part of this survey plat may be reproduced
or transmitted in any form by any means - graphic, electronic, or
mechanical, including photocopying, tracing, or information storage
and retrieval systems - without permission in writing from Douglas
G. Olson, Jensen & Olson Land Surveying, LLC.

I, Douglas G. Olson, Wisconsin Registered Land Surveyor,
do hereby certify that this survey was performed by me or under my
direction in full compliance with the owner's/agent's instructions
and Chapter A-E 7 of the Wisconsin Administrative Code "Minimum
Standards for Property Surveys"; and that this map is an accurate
representation thereof to the best of my knowledge and belief.

Douglas G. Olson
Wisconsin Registered Land Surveyor - 2093

Survey Date: Sept. 15, 2005.
Revisions: No. 1 - House Addition
No. 2 - As-Built

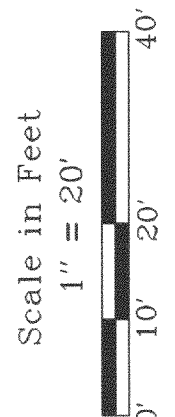

Jensen & Olson Land Surveying, LLC

45 South Wisconsin Street P.O. Box 322
Elkhorn, Wisconsin 53121
Telephone (262) 723-3434
Facsimile (262) 723-8044

Legend
Found Iron Pipe
Recorded Information
Utility Box or Pedestal
Asphalt Surface
Concrete Surface

Sheet 1 of 1 Sheets

Job Reference Number

2005.123

2005.123

Pebble Beach Drive (66' Wide)

99.84'
(100.00')

S88°06'36"E 99.94'
(100.00')

55.27'
(55.00')

N1°25'40"E 212.46'
(N1°27'32"E 212.67')

S1°22'51"W 209.32'
(S1°27'56"W 209.56')

Lot 19

Lot 17

Lot 18
0.484 Acre
21,094 Sq.Ft.

Septic
Vent

Concrete
Cover

12' Wide Utility Easement
As shown on the plat of Pebble Beach

Found second pipe
1.04' N6°29'54"E of
found pipe at corner.

N89°54'09"W 100.13'
(N89°53'24"W 100.00')

Outlot 1

Block

Lot 10

HPE -41

416-2200