

Plat of Survey

~of~

Lot 2 of Certified Survey Map # 1430 Located in the NW 1/4 of the NE 1/4 and part of Government Lot 2 of Section 25, T4N, R16E, Town of LaGrange, Walworth County, Wisconsin.

Surveyed By: Jensen Surveying & Mapping S.C.




45 S Wis. St P.O. Box 322

Elkhorn, WI. 53121

Surveyed For: Mike Baker

417 E 1st Ave.

Elkhorn, WI 53121

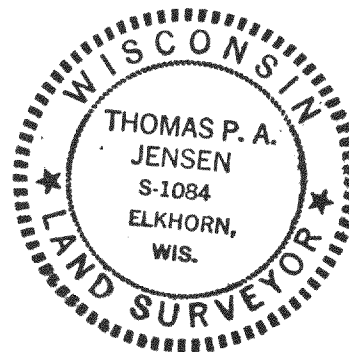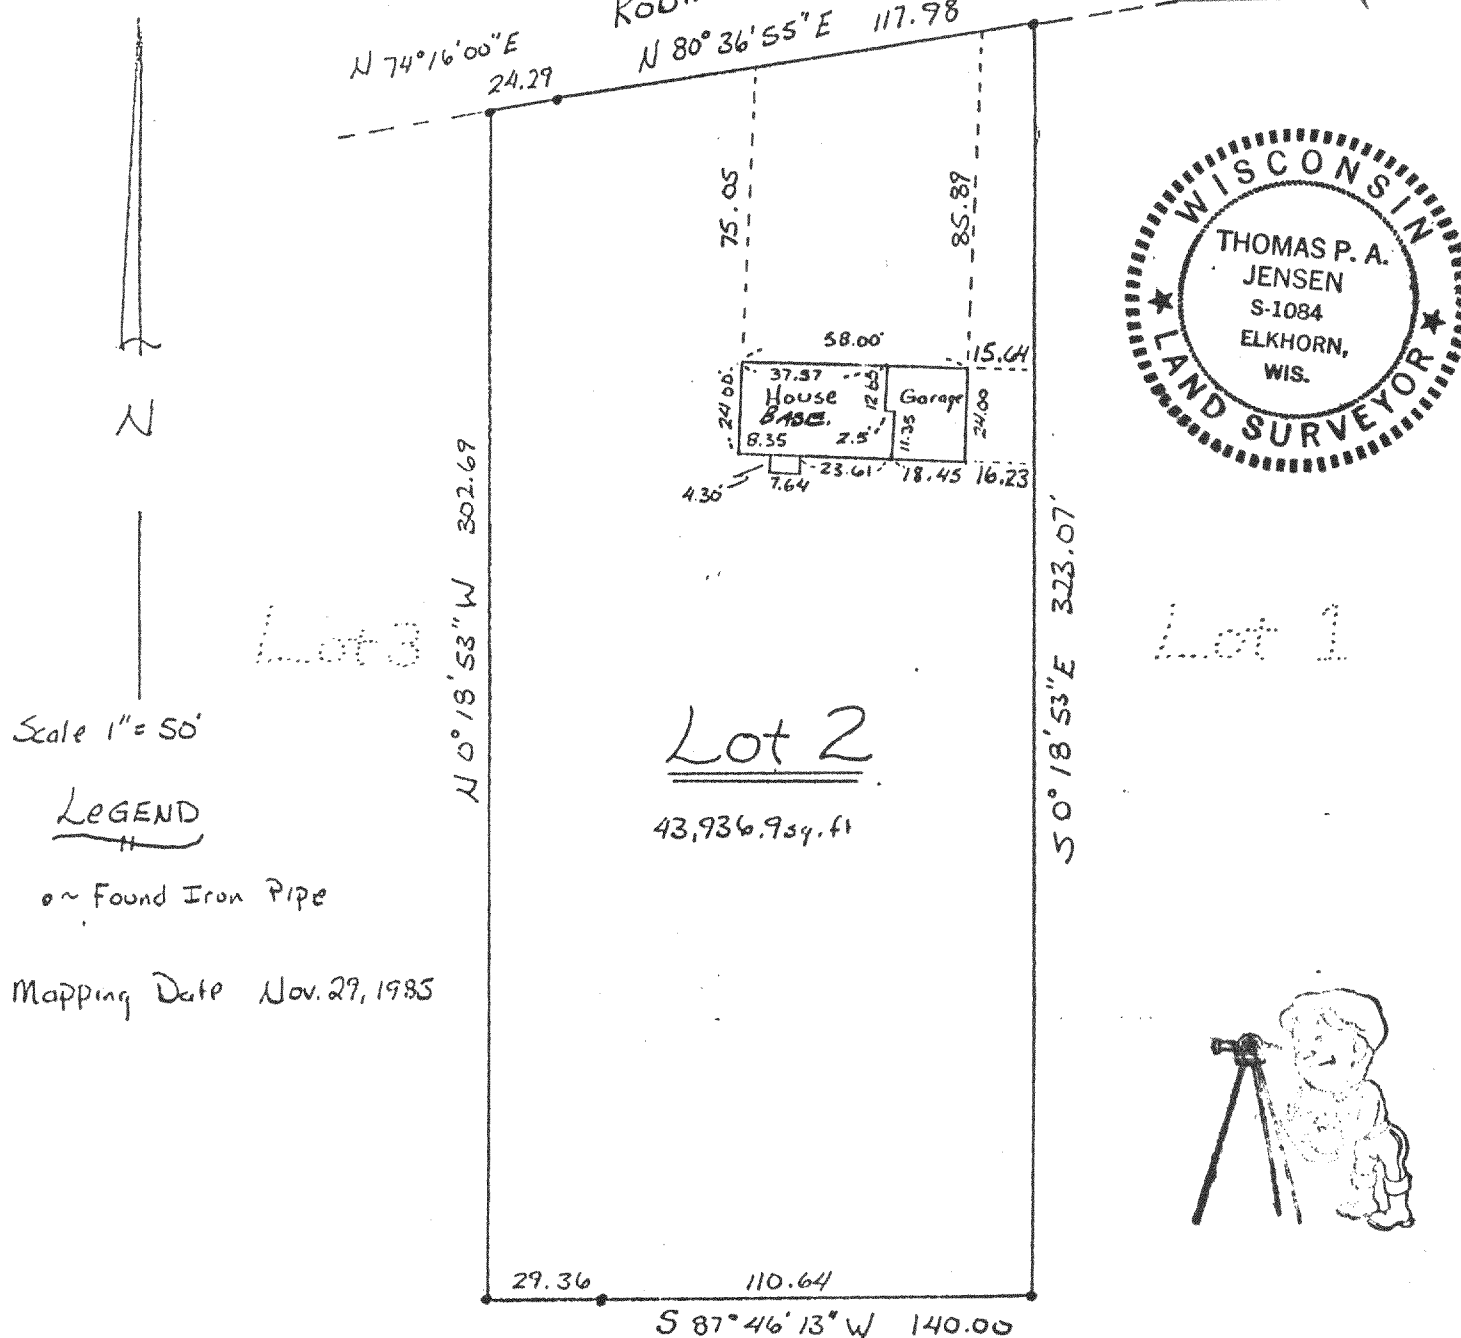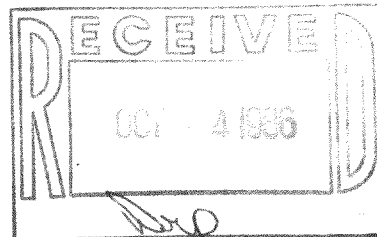

I, Thomas P.A. Jensen, Wisconsin Registered Land Surveyor, do hereby certify that this survey was performed by me, or under my direction, in full compliance with the owner's/agent's instructions and chapter A-E 5 of the Wisconsin Administrative Code "Minimum Standards For Property Surveys"; and that this map is an accurate representation thereof to the best of my knowledge and belief.

Thomas P.A. Jensen
Thomas P.A. Jensen S-1084
Jensen Surveying & Mapping S.C.
45 S. Wisconsin St.
Elkhorn, Wisconsin. 53121
(414) 723-3434

416-392
1985.105 X