


ABELL
SURVEYING & MAPPING
DELAVER, WISCONSIN 53115
414-728-6737

PLAT OF SURVEY OF


LOT 25 OF MARINER HILLS SUBDIVISION, LOCATED IN
TOWN 4 NORTH, RANGE 16 EAST, WALWORTH COUNTY, WI.

NOTE: LOCATION OF DRIVEWAY IS APPROX-
IMATE DUE TO SNOW COVER.

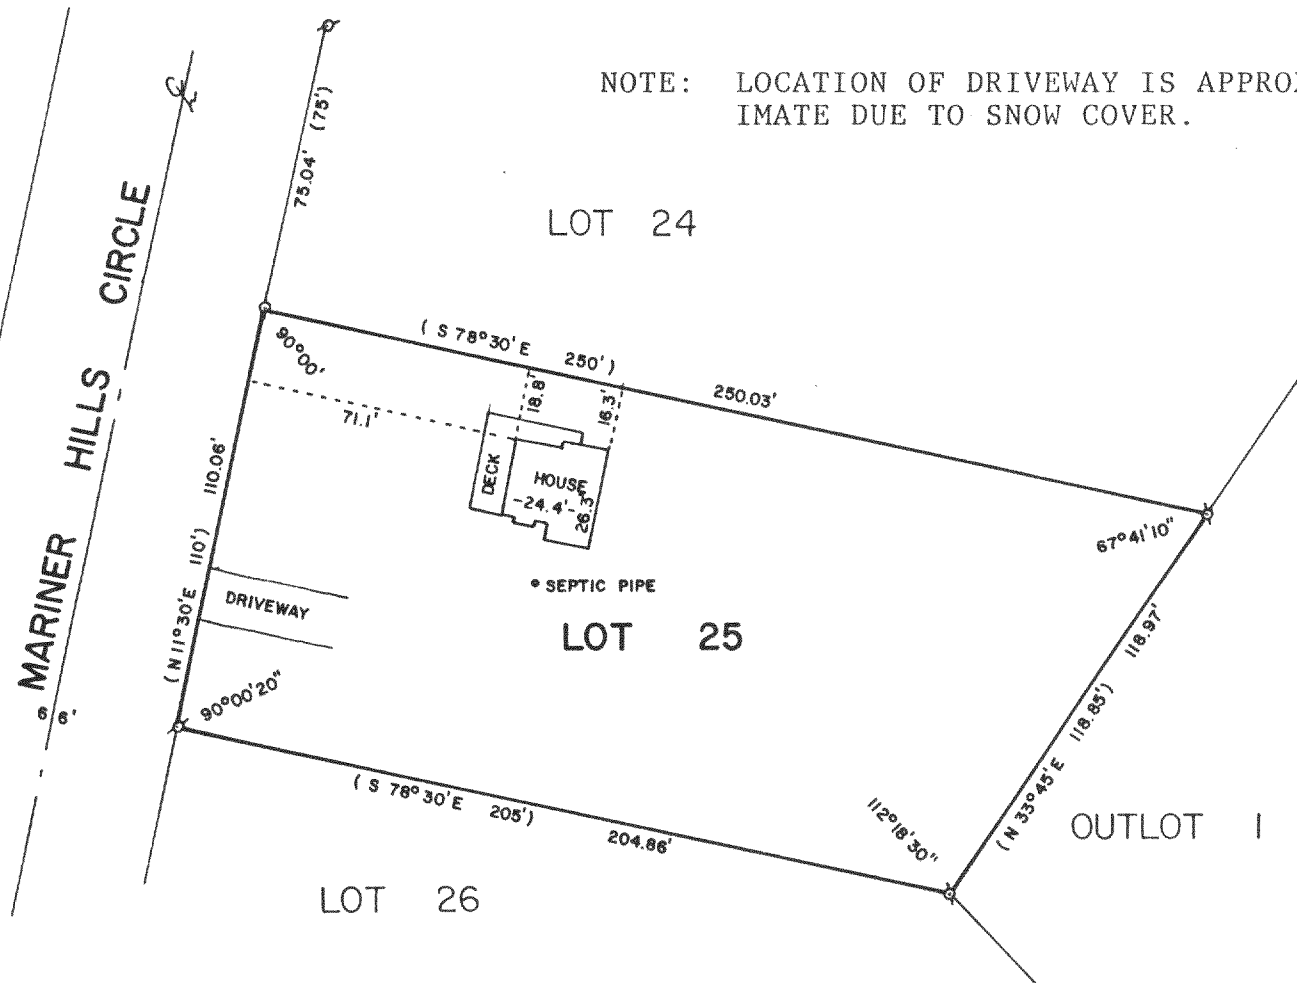

ORDERED BY: ANCHOR SAVINGS & LOAN
500 E. WALWORTH
DELAVER, WI. 53115

OWNER: GERALD W. KRAFT

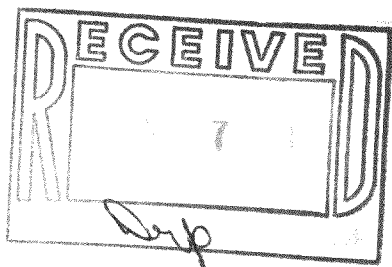

SCALE - 1"=50'

LEGEND

- ∘ - IRON ROD FOUND
- - IRON ROD SET
- () - RECORDED AS

I, DAVID F. ABELL, DO HEREBY CERTIFY
THAT I HAVE SURVEYED THE PROPERTY
HEREON DESCRIBED ACCORDING TO THE
OFFICIAL RECORDS AND THAT THE PLAT
HEREON IS A CORRECT REPRESENTATION
OF THE PROPERTY LINES TO THE BEST OF
MY KNOWLEDGE AND BELIEF.

David F. Abell
DAVID F. ABELL
WISCONSIN REGISTERED LAND SURVEYOR, S-1596

January 16, 1988
DATE JOB NUMBER - 88005

NOTE: THIS IS NOT A CERTIFIED COPY UNLESS SEALED.