

PREPARED FOR: ANDREW GIBBS  
N 7313 MARINER HILLS CIRCLE  
ELKHORN WI. 53121

PATHFINDER SURVEYING INC.  
N3705 WILLOW BEND LANE  
LAKE GENEVA WI. 53147

C.L. BUBBLING SPRINGS DRIVE

(66' WIDE ROAD)

# PLAT OF SURVEY

- OF -

LOT 20 MARINER HILLS SUBDIVISION, LOCATED IN THE NW 1/4 OF THE SW 1/4, AND THE SW 1/4 OF THE SW 1/4, AND THE SE 1/4 OF THE SW 1/4, AND THE SW 1/4 OF THE SE 1/4, OF SECTION 34, T4N, R16E, TOWN OF LAGRANGE, WALWORTH COUNTY, WISCONSIN.

LOT 19

LOT 20

LOT 21

VENT

VENT

CONCRETE LID

4" PLUG

SHED

DECK

EXISTING HOUSE

DECK


EXISTING GARAGE

PROPOSED DRIVE

EXISTING GRAVEL DRIVE

WELL

FENCE IS 0.4' WEST OF LINE

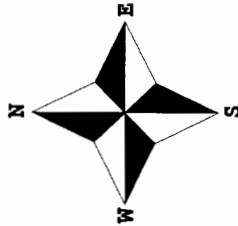

( ) = recorded as

□ = found iron bar

○ = found iron pipe

● = set iron pipe

■ = set iron bar

SCALE 1" = 30'

JOB # 06-108AB


TAXID # HMH000020

COMPARE LEGAL DESCRIPTION ABOVE AND DRAWING WITH DEED. FOR BUILDING RESTRICTIONS AND EASEMENTS NOT SHOWN, REFER TO DEED. ABSTRACT SOURCES AND LOCAL MUNICIPAL CODES. NOTIFY THE SURVEYOR IMMEDIATELY OF ANY DISCREPANCY.

"I hereby certify that I have surveyed the above described property and that the above map, to the best of my knowledge and belief, is a true representation thereof and shows the size and location of all visible structures, apparent easements and encroachments if any."

This survey is made for the present owners of the property, and those who purchase, mortgage, or guarantee the title thereto, within one year from the date hereof.

JUL 28 2006  
SMF

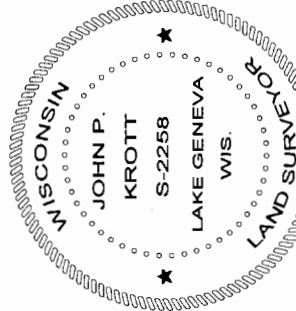

DATE OF LAST REVISION: 7 / 10 / 2006

*John P. Krott*

JOHN KROTT S - 2258  
Wisconsin Registered Land Surveyor  
(original if signed in red)

DATED THIS THE 27th DAY OF MARCH 2006.

416-2217