

LAND-MARK SURVEYING

Mark L. Miritz

Wisconsin Registered Land Surveyor S-2582

N9330 Knuteson Drive
Whitewater, WI 53190
Phone: (262) 495-3284
FAX : (262) 495-8421
LAND-MARKSURVEYING.COM

100 YEAR FLOOD ELEVATION 886.0' FALLS
ON THE SIDE OF THE RIP RAP ON THE SHORE


REFERENCE LEGAL: VOL. 674 P. 4876 DOC. NO. 0454508
RECORDED OCT. 23, 2000

OWNER: JUDITH K. BAUMAN, TRUSTEE
JUDITH K. BAUMAN TRUST
534 PROVIDENCE RD.
PALATINE, IL. 60074

PLAT OF SURVEY

PART OF LOT 6 OF LAUDERDALE'S PARK
SUBDIVISION, LOCATED IN SECTION 25
TOWN 4 NORTH, RANGE 16 EAST, LAGRANGE
TOWNSHIP, WALWORTH COUNTY, WISCONSIN.


GREEN LAKE

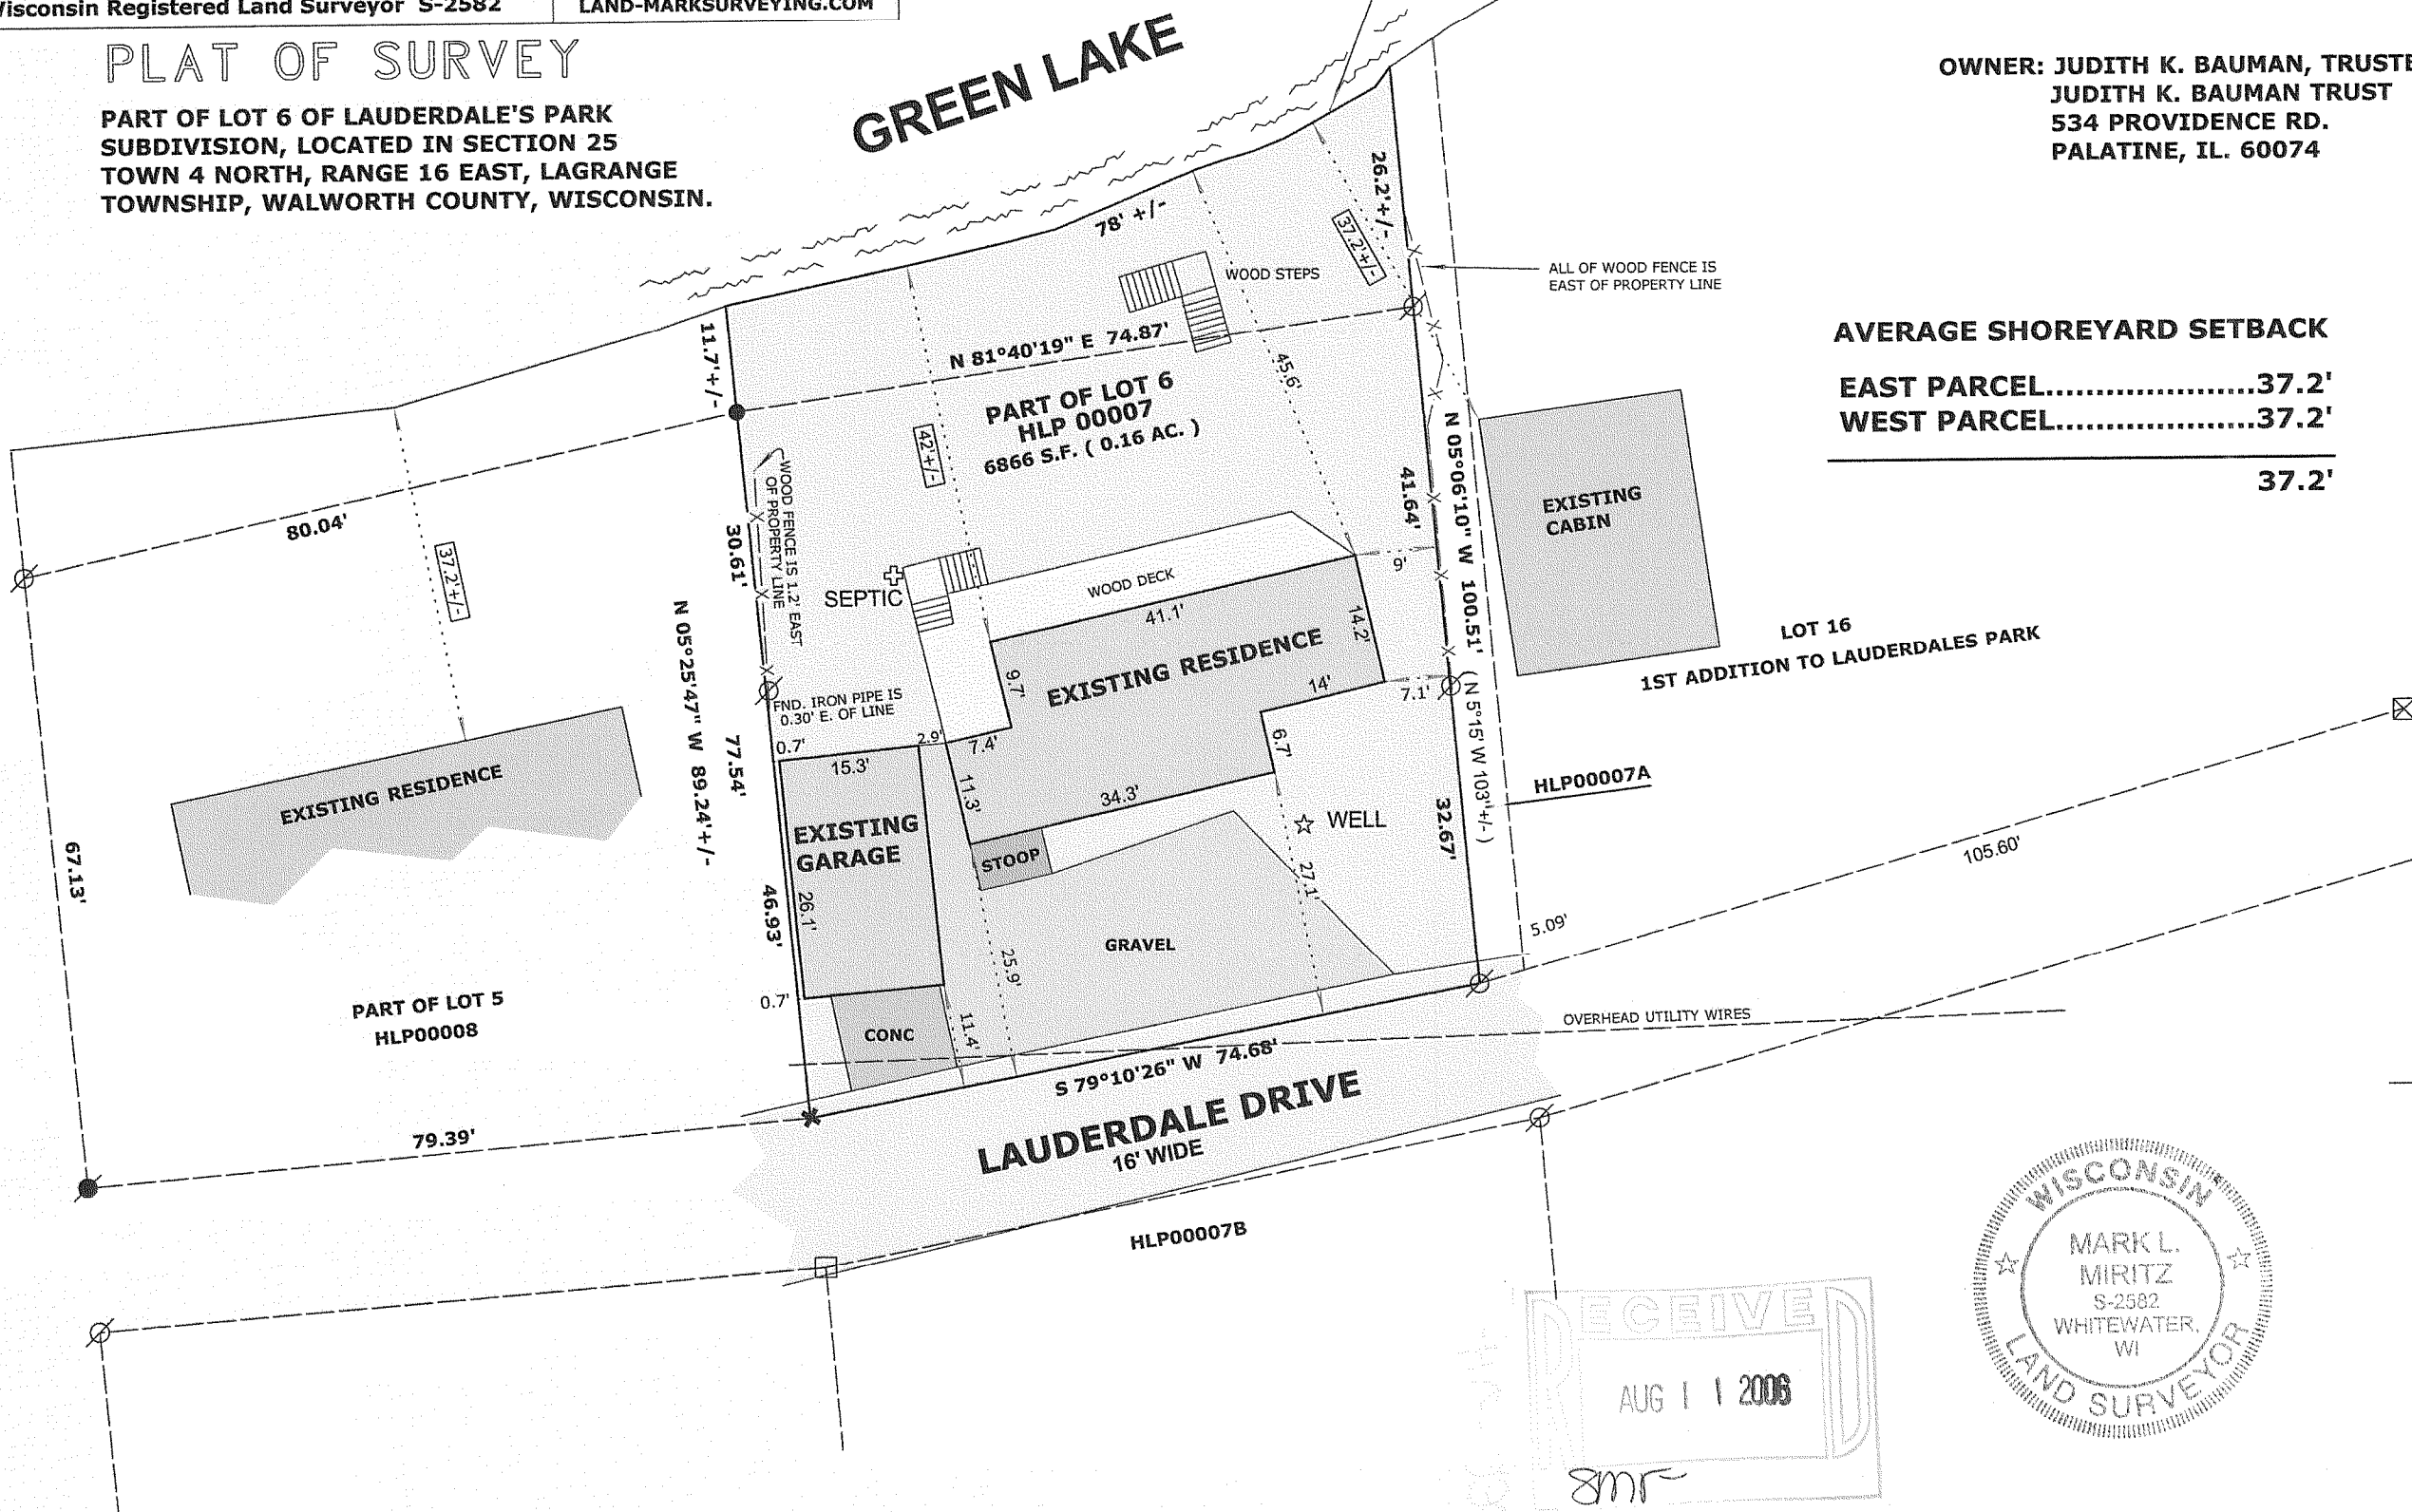

AVERAGE SHOREYARD SETBACK

EAST PARCEL.....37.2'
WEST PARCEL.....37.2'

37.2'

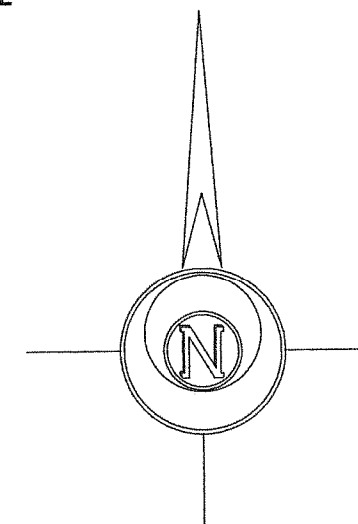

LEGEND


- FOUND IRON PIPE
- FOUND IRON ROD
- FOUND P.K. NAIL
- FOUND RAIL ROAD SPIKE
- SET GIN SCREW
- SET IRON ROD, 24" LONG, WEIGHING 1.5 LBS./LINEAL FT., 3/4" DIA.
- RECORDED AS DIMENSION
- EXISTING FENCE

SCALE: 1" = 20 FEET

"I hereby certify that the above described property has been surveyed by me or under my direction and that the above map is a true representation thereof and shows the size and location of the property, its exterior boundaries, the location of all visible structures and dimensions of all principal buildings thereon, boundary fences, apparent easements, roadways and visible encroachments, if any."
"This survey is made for the use of the present owners of the property, and also those who purchase, mortgage, or guarantee the title thereto within one year from date hereof."

Mark L. Miritz
MARK L. MIRITZ
WISCONSIN REGISTERED
LAND SURVEYOR S-2582

DATE: JULY 15, 2006 JOB NO. 06.702

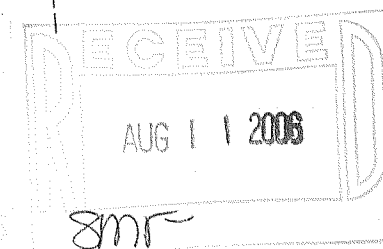

HLP-7

416-2226