
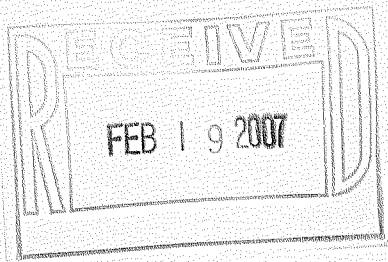


PLAT OF SURVEY OF

Lot 12 of ARROWHEAD PARK ADDITION NO. 1, located in Government Lot 3 in the Southeast Quarter of Section 35, Township 4 North, Range 16 East of the 4th Principal Meridian, Town of LaGrange, Walworth County, Wisconsin

PARCEL IDENTIFICATION NO.: HAPA 00002

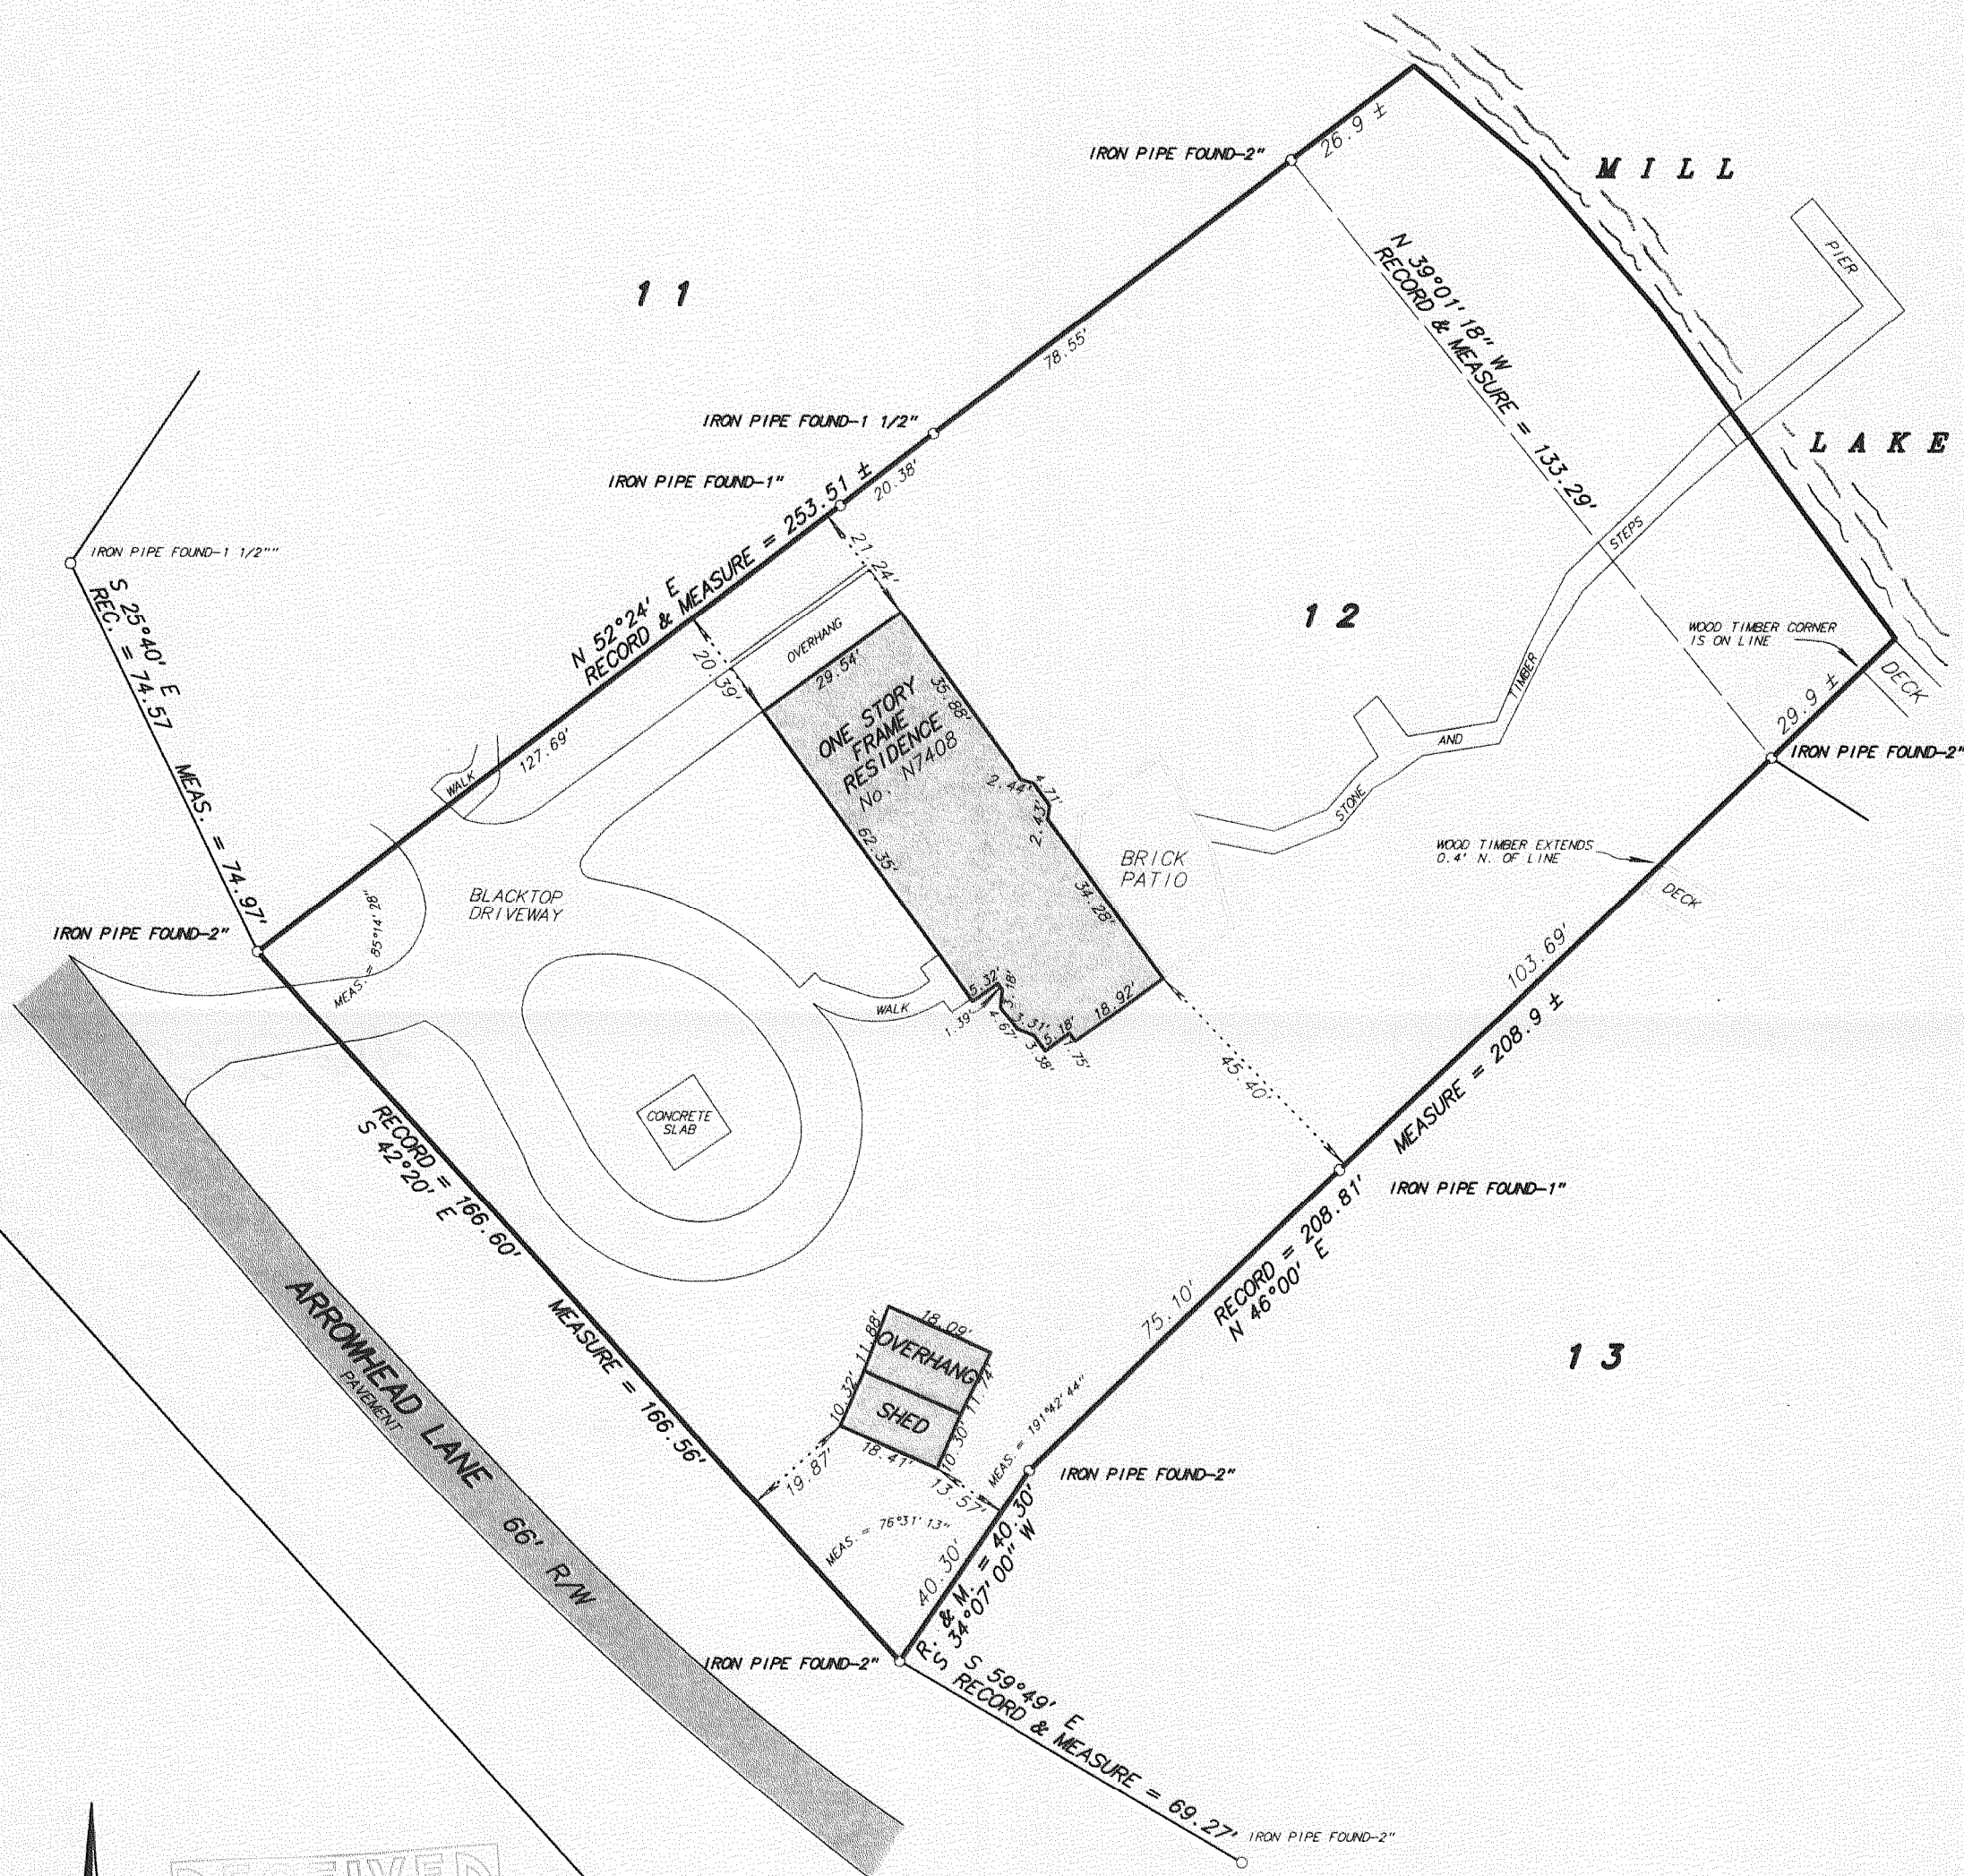

SCALE: 1 inch = 30 feet
ORDERED BY: R. Madro / Timberline
JOB NO. 06081

I hereby certify that I have surveyed the above described property and the above plat is a true representation thereof and shows the size and location of the property, its exterior boundaries, the location and dimensions of all visible structures thereon, boundary fences, apparent easements and roadways and visible encroachments, if any.

This survey is made for the exclusive use of the present owners of the property, and also those who purchase, mortgage or guarantee the title thereto within ONE YEAR from the date hereof.

Dated at Bassett, Wisconsin this _____ day of _____ 2006.

Mark A. Bolender
Wisconsin Registered Land Surveyor S - 1784

HAPA-2

416-2257