
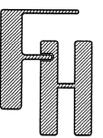


PLAT OF SURVEY

LOTS 73 AND 74 OF BUBBLING SPRINGS 1st ADDITION

LOCATED IN PART OF SECTION 35, TOWN 4 NORTH,
RANGE 16 EAST, WALWORTH COUNTY, WISCONSIN

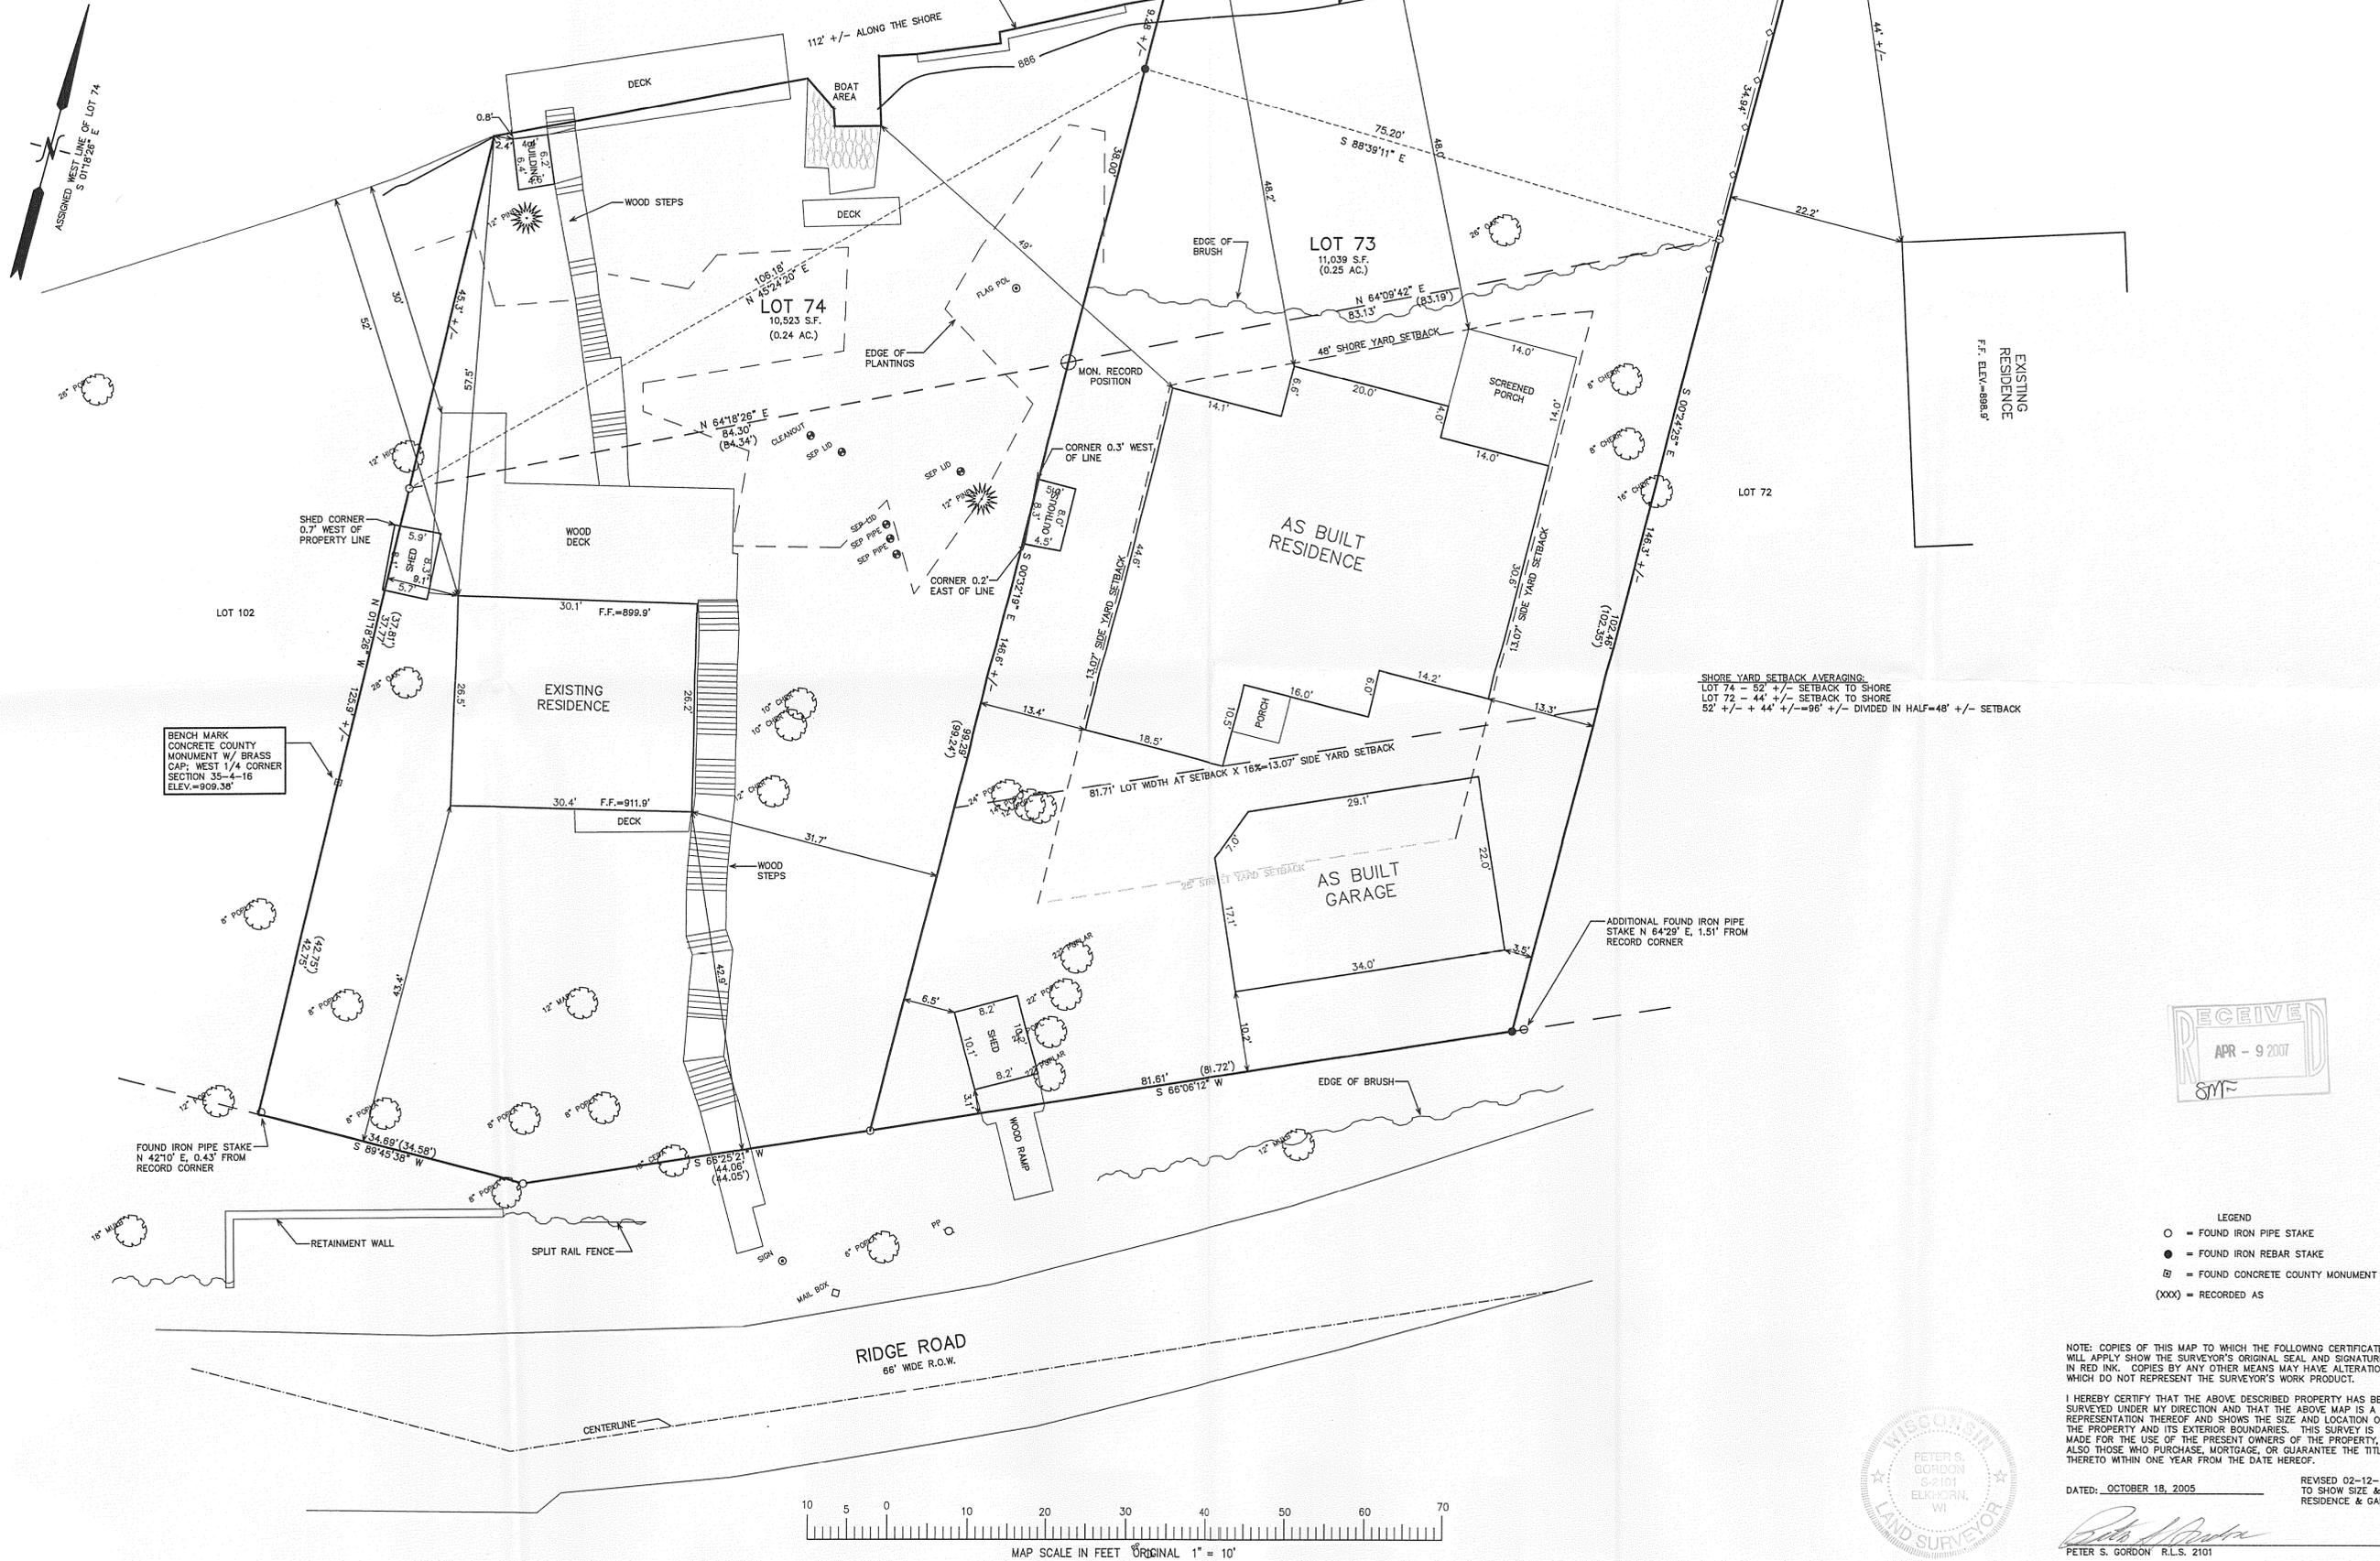

WORK ORDERED BY -
RANDY THELEN - THELEN TOTAL CONSTRUCTION
P.O. BOX 17
ELKHORN, WI 53121

FARRIS, HANSEN & ASSOCIATES, INC.
ENGINEERING - ARCHITECTURE - SURVEYING
7 RIDGWAY COURT P.O. BOX 437
ELKHORN, WISCONSIN 53121
OFFICE: (262) 723-2098 FAX: (262) 723-5686



REVISIONS
03/08/2006 TO SHOW SIZE AND LOCATION OF PROPOSED RESIDENCE AND GARAGE
03/13/2006 REVISED SIZE AND LOCATION OF PROPOSED RESIDENCE AND GARAGE
06/09/2006 MISC. REVISIONS
06/12/2006 ADD 100-YEAR FLOOD ELEVATION LINE

PROJECT NO.
6899
DATE
10/18/05
SHEET NO.
1 OF 1

HBSI-42 HBSI-43

416-2266