


PREPARED FOR:
DEMARI HOMES
28835 N HERKY DR #215
LAKE BLUFF, IL 60044

PLAT OF SURVEY


-OF-

LOTS 18 AND 19 IN FIRST ADDITION TO LAUDERDALE PARK, BEING A SUBDIVISION
IN THE SOUTHWEST 1/4 OF SECTION 25, TOWNSHIP 4 NORTH, RANGE 16 EAST,
WALWORTH COUNTY, WISCONSIN.

PATHFINDER SURVEYING INC.
W2888 KRUEGER ROAD, UNIT "D"
LAKE GENEVA, WI, 53147
262-248-3697

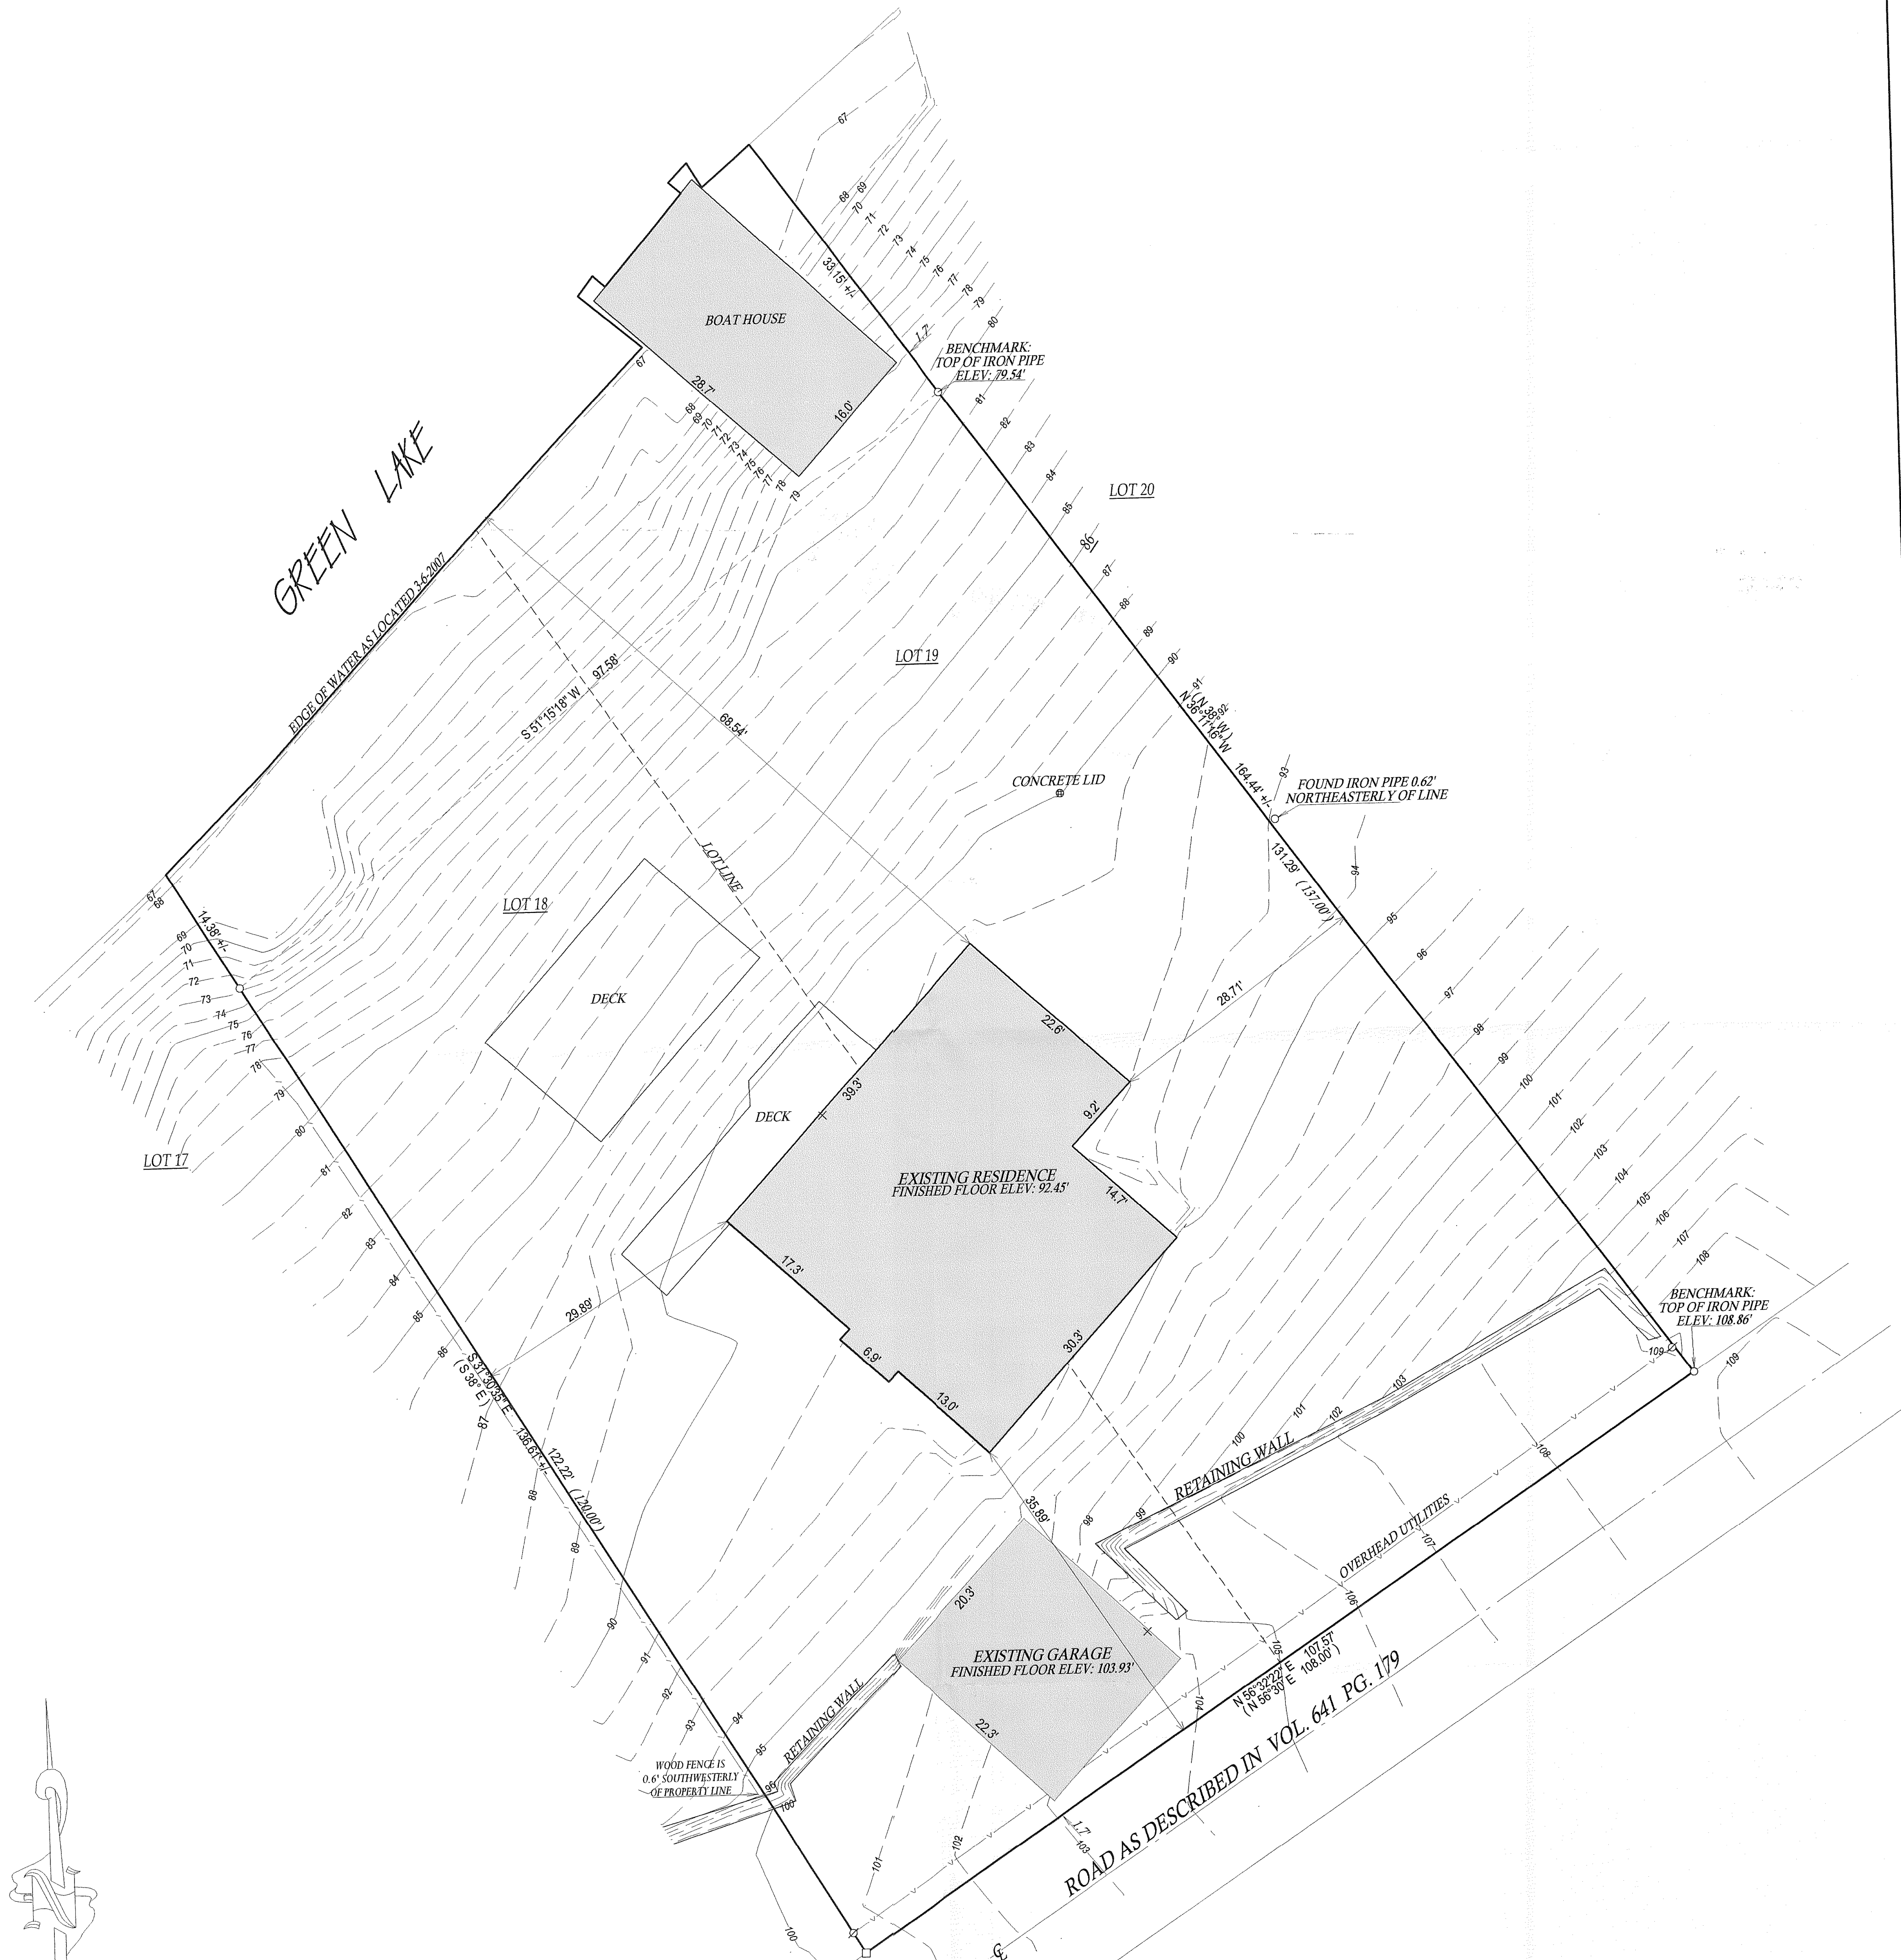


() = RECORDED AS
□ = FOUND IRON BAR
○ = FOUND IRON PIPE
■ = SET IRON BAR
⊙ = UTILITY POLE
× = FINISHED FLOOR
SCALE: 1" = 10'
JOB #: 07-067
TAXID #: HLPAA00007

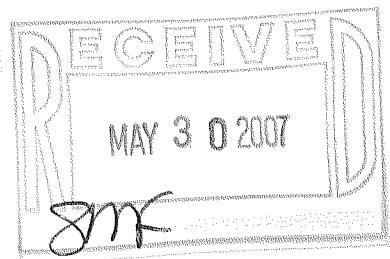

COMPARE LEGAL DESCRIPTION ABOVE AND DRAWING WITH DEED. FOR BUILDING RESTRICTIONS AND EASEMENTS NOT SHOWN REFER TO DEED, ABSTRACT SOURCES AND LOCAL MUNICIPAL CODES. NOTIFY THE SURVEYOR IMMEDIATELY OF ANY DISCREPANCY.

"I hereby certify that I have surveyed the above described property and that, to the best of my knowledge and belief the above map is a true representation thereof and shows the size and location of all visible structures, apparent easements and encroachments if any. This survey is made for the present owners of the property, and those who purchase, mortgage, or guarantee the title thereto, within one year from the date hereof.

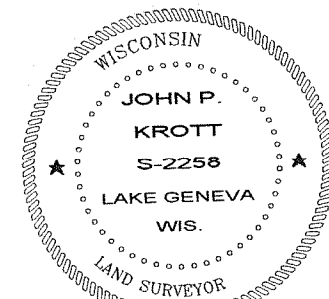

JOHN KROTT S-2258
Wisconsin Registered Land Surveyor
(original if signed in red)

DATED THIS 7th DAY OF MARCH, 2007.

416-2268