

— WORK ORDERED BY —  
SCOTT LOWELL  
LOWELL MANAGEMENT SERVICES  
P.O. BOX 926  
LAKE GENEVA, WI 53147


FARRIS, HANSEN & ASSOCIATES, INC.  
ENGINEERING — ARCHITECTURE — SURVEYING  
7 RIDGWAY COURT P.O. BOX 437  
ELKHORN, WISCONSIN 53121  
OFFICE: (262) 723-2098 FAX: (262) 723-5886

REVISIONS  
5/3/2007-KB  
TO SHOW SIZE  
AND LOCATION  
OF AS-BUILT  
RESIDENCE


PROJECT NO.  
7106  
DATE:  
12/26/06  
SHEET NO.  
1 OF 1

# AS-BUILT MAPPING PLAT OF SURVEY

LOCATED IN PART OF SECTION 35, TOWN 4 NORTH,  
RANGE 16 EAST, TOWN OF LAGRANGE,  
WALWORTH COUNTY, WISCONSIN

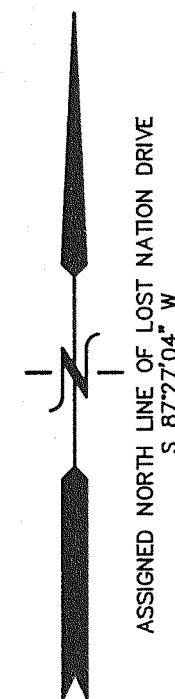

MAP SCALE IN FEET ORIGINAL 1" = 10'

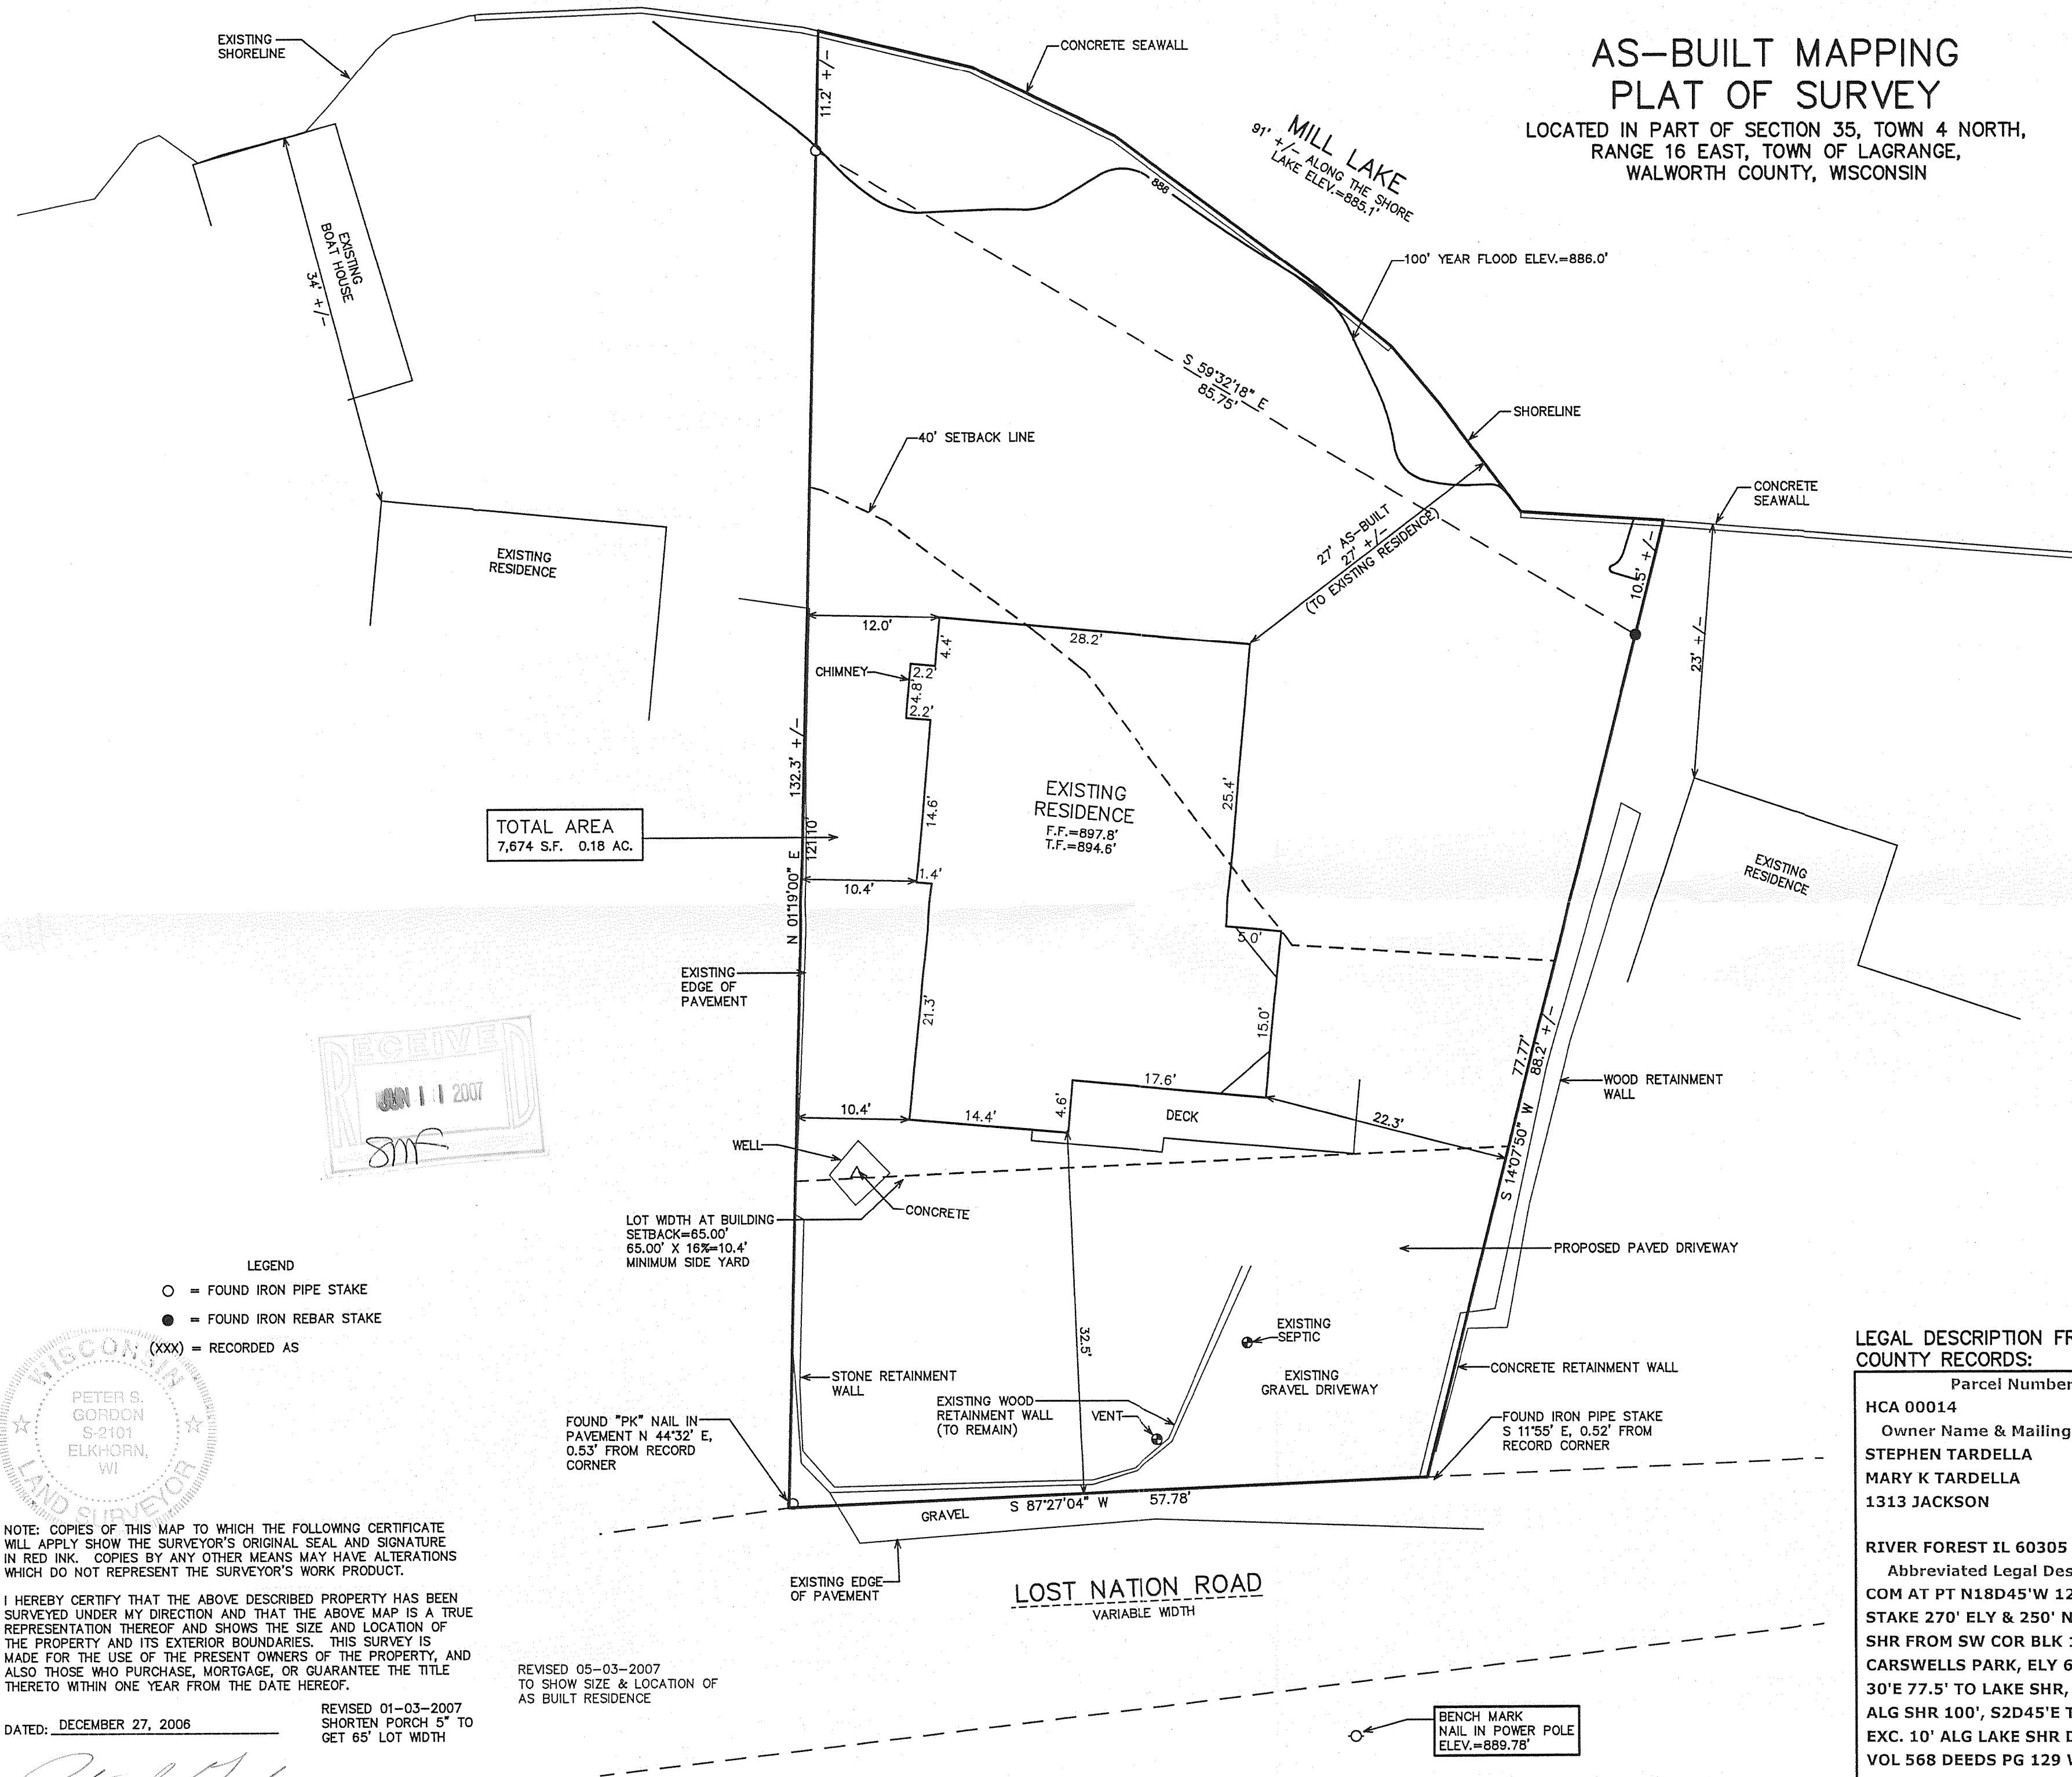


TOTAL AREA  
7,674 S.F. 0.18 AC.


## LEGAL DESCRIPTION FROM COUNTY RECORDS:

Parcel Number  
HCA 00014  
Owner Name & Mailing Address  
STEPHEN TARDELLA  
MARY K TARDELLA  
1313 JACKSON

RIVER FOREST IL 60305  
Abbreviated Legal Description  
COM AT PT N18D45'W 121.5' FROM  
STAKE 270' ELY & 250' NLY ALG  
SHR FROM SW COR BLK 1  
CARSWELLS PARK, ELY 60', N13D  
30'E 77.5' TO LAKE SHR, NWLY  
ALG SHR 100', S2D45'E TO POB.  
EXC. 10' ALG LAKE SHR DESC IN  
VOL 568 DEEDS PG 129 WCR.  
SEC 35 T4N R16E

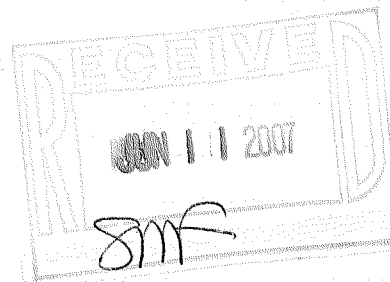

- LEGEND
- = FOUND IRON PIPE STAKE
  - = FOUND IRON REBAR STAKE
  - (XXX) = RECORDED AS

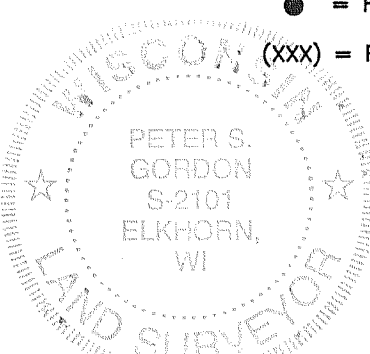

NOTE: COPIES OF THIS MAP TO WHICH THE FOLLOWING CERTIFICATE  
WILL APPLY SHOW THE SURVEYOR'S ORIGINAL SEAL AND SIGNATURE  
IN RED INK. COPIES BY ANY OTHER MEANS MAY HAVE ALTERATIONS  
WHICH DO NOT REPRESENT THE SURVEYOR'S WORK PRODUCT.

I HEREBY CERTIFY THAT THE ABOVE DESCRIBED PROPERTY HAS BEEN  
SURVEYED UNDER MY DIRECTION AND THAT THE ABOVE MAP IS A TRUE  
REPRESENTATION THEREOF AND SHOWS THE SIZE AND LOCATION OF  
THE PROPERTY AND ITS EXTERIOR BOUNDARIES. THIS SURVEY IS  
MADE FOR THE USE OF THE PRESENT OWNERS OF THE PROPERTY, AND  
ALSO THOSE WHO PURCHASE, MORTGAGE, OR GUARANTEE THE TITLE  
THERE TO WITHIN ONE YEAR FROM THE DATE HEREOF.

DATED: DECEMBER 27, 2006  
REVISED 01-03-2007  
SHORTEN PORCH 5' TO  
GET 65' LOT WIDTH

PETER S. GORDON R.L.S. 2101

REVISED 05-03-2007  
TO SHOW SIZE & LOCATION OF  
AS BUILT RESIDENCE

BENCH MARK  
NAIL IN POWER POLE  
ELEV.=889.78'

HCA-14

416-2271