



ABELL  
SURVEYING & MAPPING

1140 SEQUOIA STREET • DELAVAN, WISCONSIN 53115  
262-728-6737

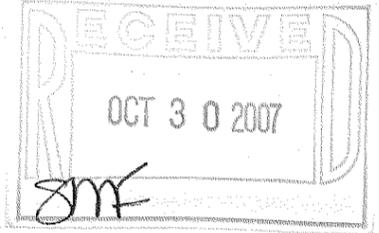

BAY SHORE DRIVE

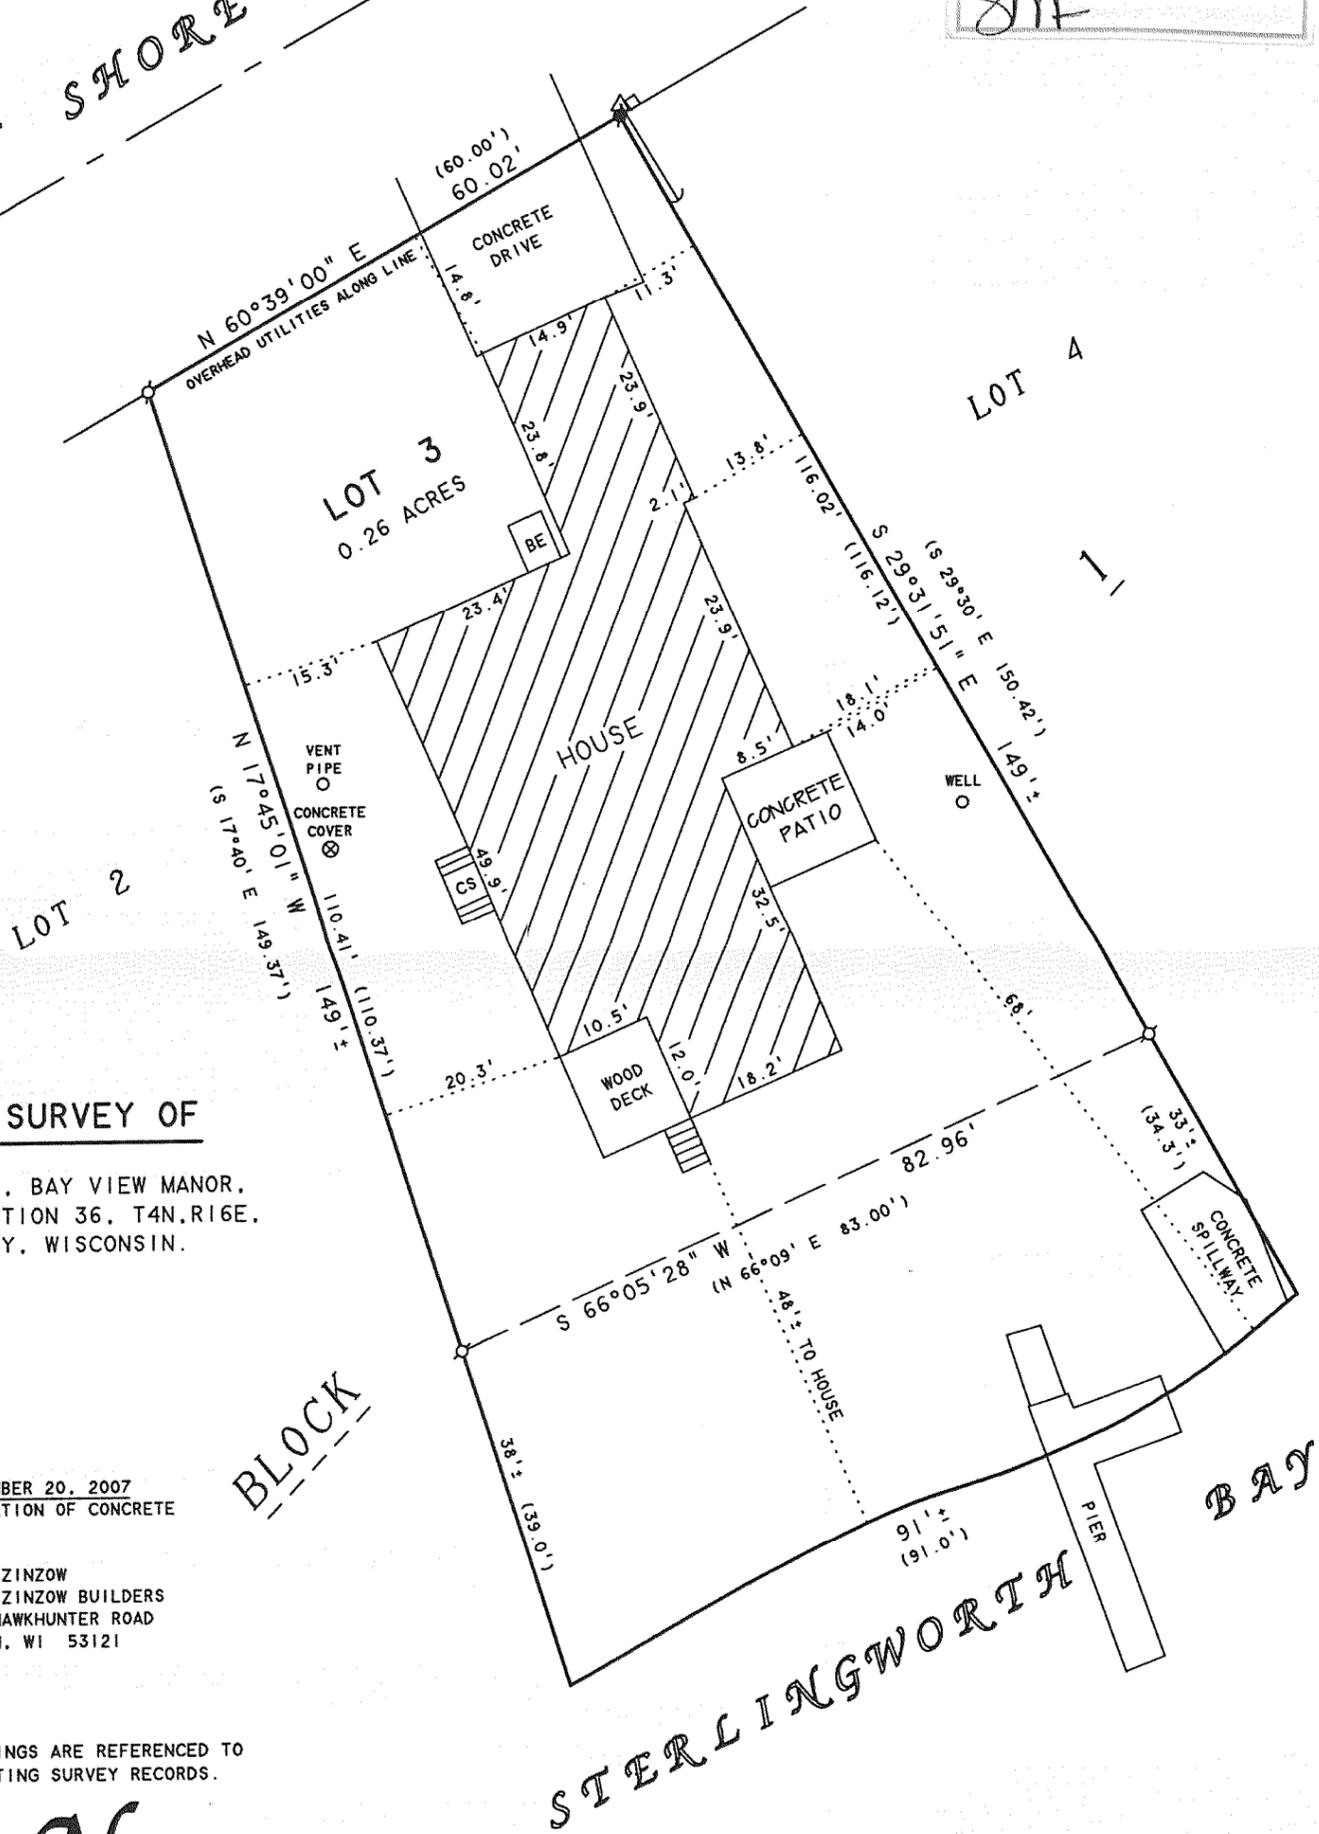

PLAT OF SURVEY OF

LOT 3, BLOCK 1, BAY VIEW MANOR,  
LOCATED IN SECTION 36, T4N, R16E,  
WALWORTH COUNTY, WISCONSIN.

REVISED DATE: SEPTEMBER 20, 2007  
REVISED TO SHOW LOCATION OF CONCRETE  
PATIO.

ORDERED BY: MARVIN ZINZOW  
MARVIN ZINZOW BUILDERS  
W5140 HAWKHUNTER ROAD  
ELKHORN, WI 53121

BEARINGS ARE REFERENCED TO  
EXISTING SURVEY RECORDS.



SCALE 1" = 20'

LEGEND

- ⊙ - IRON PIPE FOUND
- ⊛ - IRON ROD FOUND
- △ - UTILITY POLE
- GUYWIRE
- - UTILITY PED
- BE - BASEMENT ENTRY
- ( ) - RECORDED AS

I HEREBY CERTIFY THAT I HAVE SURVEYED THE ABOVE DESCRIBED PROPERTY AND THAT THE ABOVE MAP IS A TRUE REPRESENTATION THEREOF AND SHOWS THE SIZE AND LOCATION OF THE PROPERTY, ITS EXTERIOR BOUNDARIES, THE LOCATION OF ALL VISIBLE STRUCTURES AND DIMENSIONS OF ALL PRINCIPAL BUILDINGS THEREON, BOUNDARY FENCES, APPARENT EASEMENTS, ROADWAYS AND VISIBLE ENCROACHMENTS, IF ANY, TO THE BEST OF MY KNOWLEDGE AND BELIEF.

THIS SURVEY IS MADE FOR THE USE OF THE PRESENT OWNERS OF THE PROPERTY, AND ALSO THOSE WHO PURCHASE, MORTGAGE, OR GUARANTEE THE TITLE THERETO WITHIN ONE (1) YEAR FROM DATE HEREON.

*David F. Abell*  
DAVID F. ABELL  
WISCONSIN REGISTERED LAND SURVEYOR, S-1596

June 29, 2007

DATE: June 29, 2007 JOB NUMBER - 88052B  
NOTE: THIS IS NOT A CERTIFIED COPY UNLESS SEALED.