

PLAT OF SURVEY
TOPOGRAPHIC MAPPING



— WORK ORDERED BY —
THELEN TOTAL CONSTRUCTION
P.O. BOX 17
ELKHORN, WI. 53121

FARRIS, HANSEN & ASSOCIATES, INC.
ENGINEERING — ARCHITECTURE — SURVEYING
7 RIDGWAY COURT P.O. BOX 437
ELKHORN, WISCONSIN 53121
OFFICE: (262) 723-2098 FAX: (262) 723-5886

REVISIONS
09/17/2005 INITIAL
09-13-2005
ADD REVISED SHORELINE
10-13-2005
ADD REVISED TOPO AT
SHORE AND 100-YEAR
FLOOD SHORELINE
12-16-2007-40
TO SHOW SIZE AND
LOCATION OF PROPOSED
RESIDENCE

PROJECT NO.
6383
DATE
09/25/2003
SHEET NO.
1 OF 1

PLAT OF SURVEY
& TOPOGRAPHIC MAPPING
THE WESTERLY 1/2 OF LOT 8 AND ALL OF LOT 9 IN THE PLAT OF
MORRIS PARK, A SUBDIVISION LOCATED IN THE SW 1/4 OF SECTION
26, TOWN 4 NORTH, RANGE 16 EAST, WALWORTH COUNTY, WISCONSIN

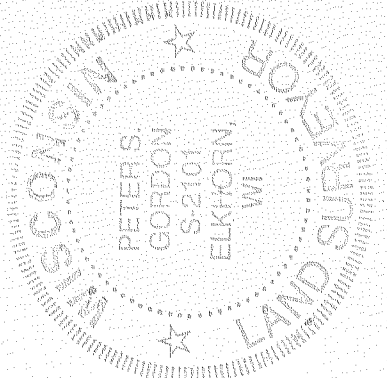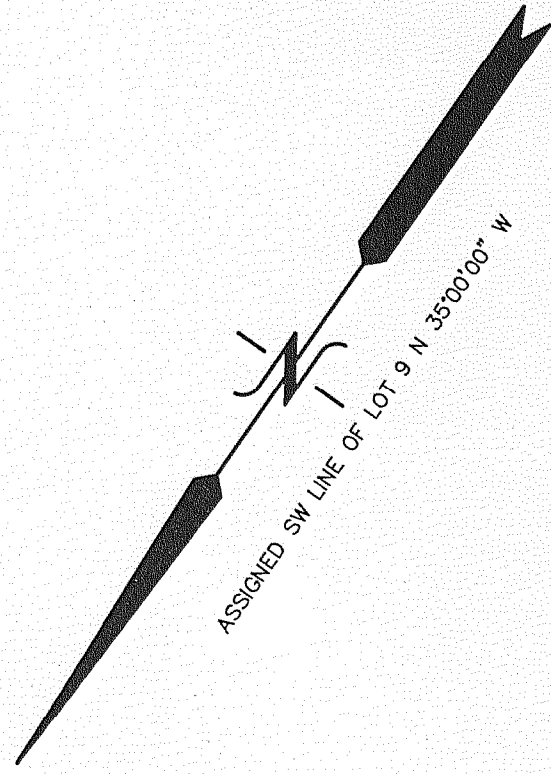

NOTE: COPIES OF THIS MAP TO WHICH THE FOLLOWING CERTIFICATE
WILL APPLY SHALL BE THE SURVEYOR'S ORIGINAL SEAL AND SIGNATURE
WHICH DO NOT REPRESENT THE SURVEYOR'S WORK PRODUCT.
I HEREBY CERTIFY THAT THE ABOVE DESCRIBED PROPERTY HAS BEEN
SURVEYED UNDER MY DIRECTION AND THAT THE ABOVE MAP IS A TRUE
REPRESENTATION THEREOF AND SHOWS THE SIZE AND LOCATION OF
THE PROPERTY AND THE LOCATION OF THE SURVEY STAKES AND
MADE FOR THE USE OF THE PRESENT OWNERS OF THE PROPERTY, AND
THAT I HAVE NOT BEEN ADVISED OF ANY INTERESTS IN THE TITLE
THEREIN WITHIN ONE YEAR FROM THE DATE HEREOF.

DATED: 9-25-2003
REVISED 09-10-2007
TO AND AS BUILT FOUNDATION, WALLS, AND SLAB ON SHORE
PETER S. GORDON R.L.S. 2101

