



PLAT OF SURVEY
LOT 2 CERTIFIED SURVEY MAP NO. 3783
LOCATED IN PART OF THE NW 1/4 & NE 1/4 OF SECTION 35,
TOWN 4 NORTH, RANGE 16 EAST, WALWORTH COUNTY, WISCONSIN

MIDDLE LAKE
W.S. ELEV.=885.1

FLOOD INSURANCE RATE MAP
COMMUNITY-PANEL NUMBER
550462 0020 B SHOWS
100-YEAR FLOOD ELEVATION
AT 886

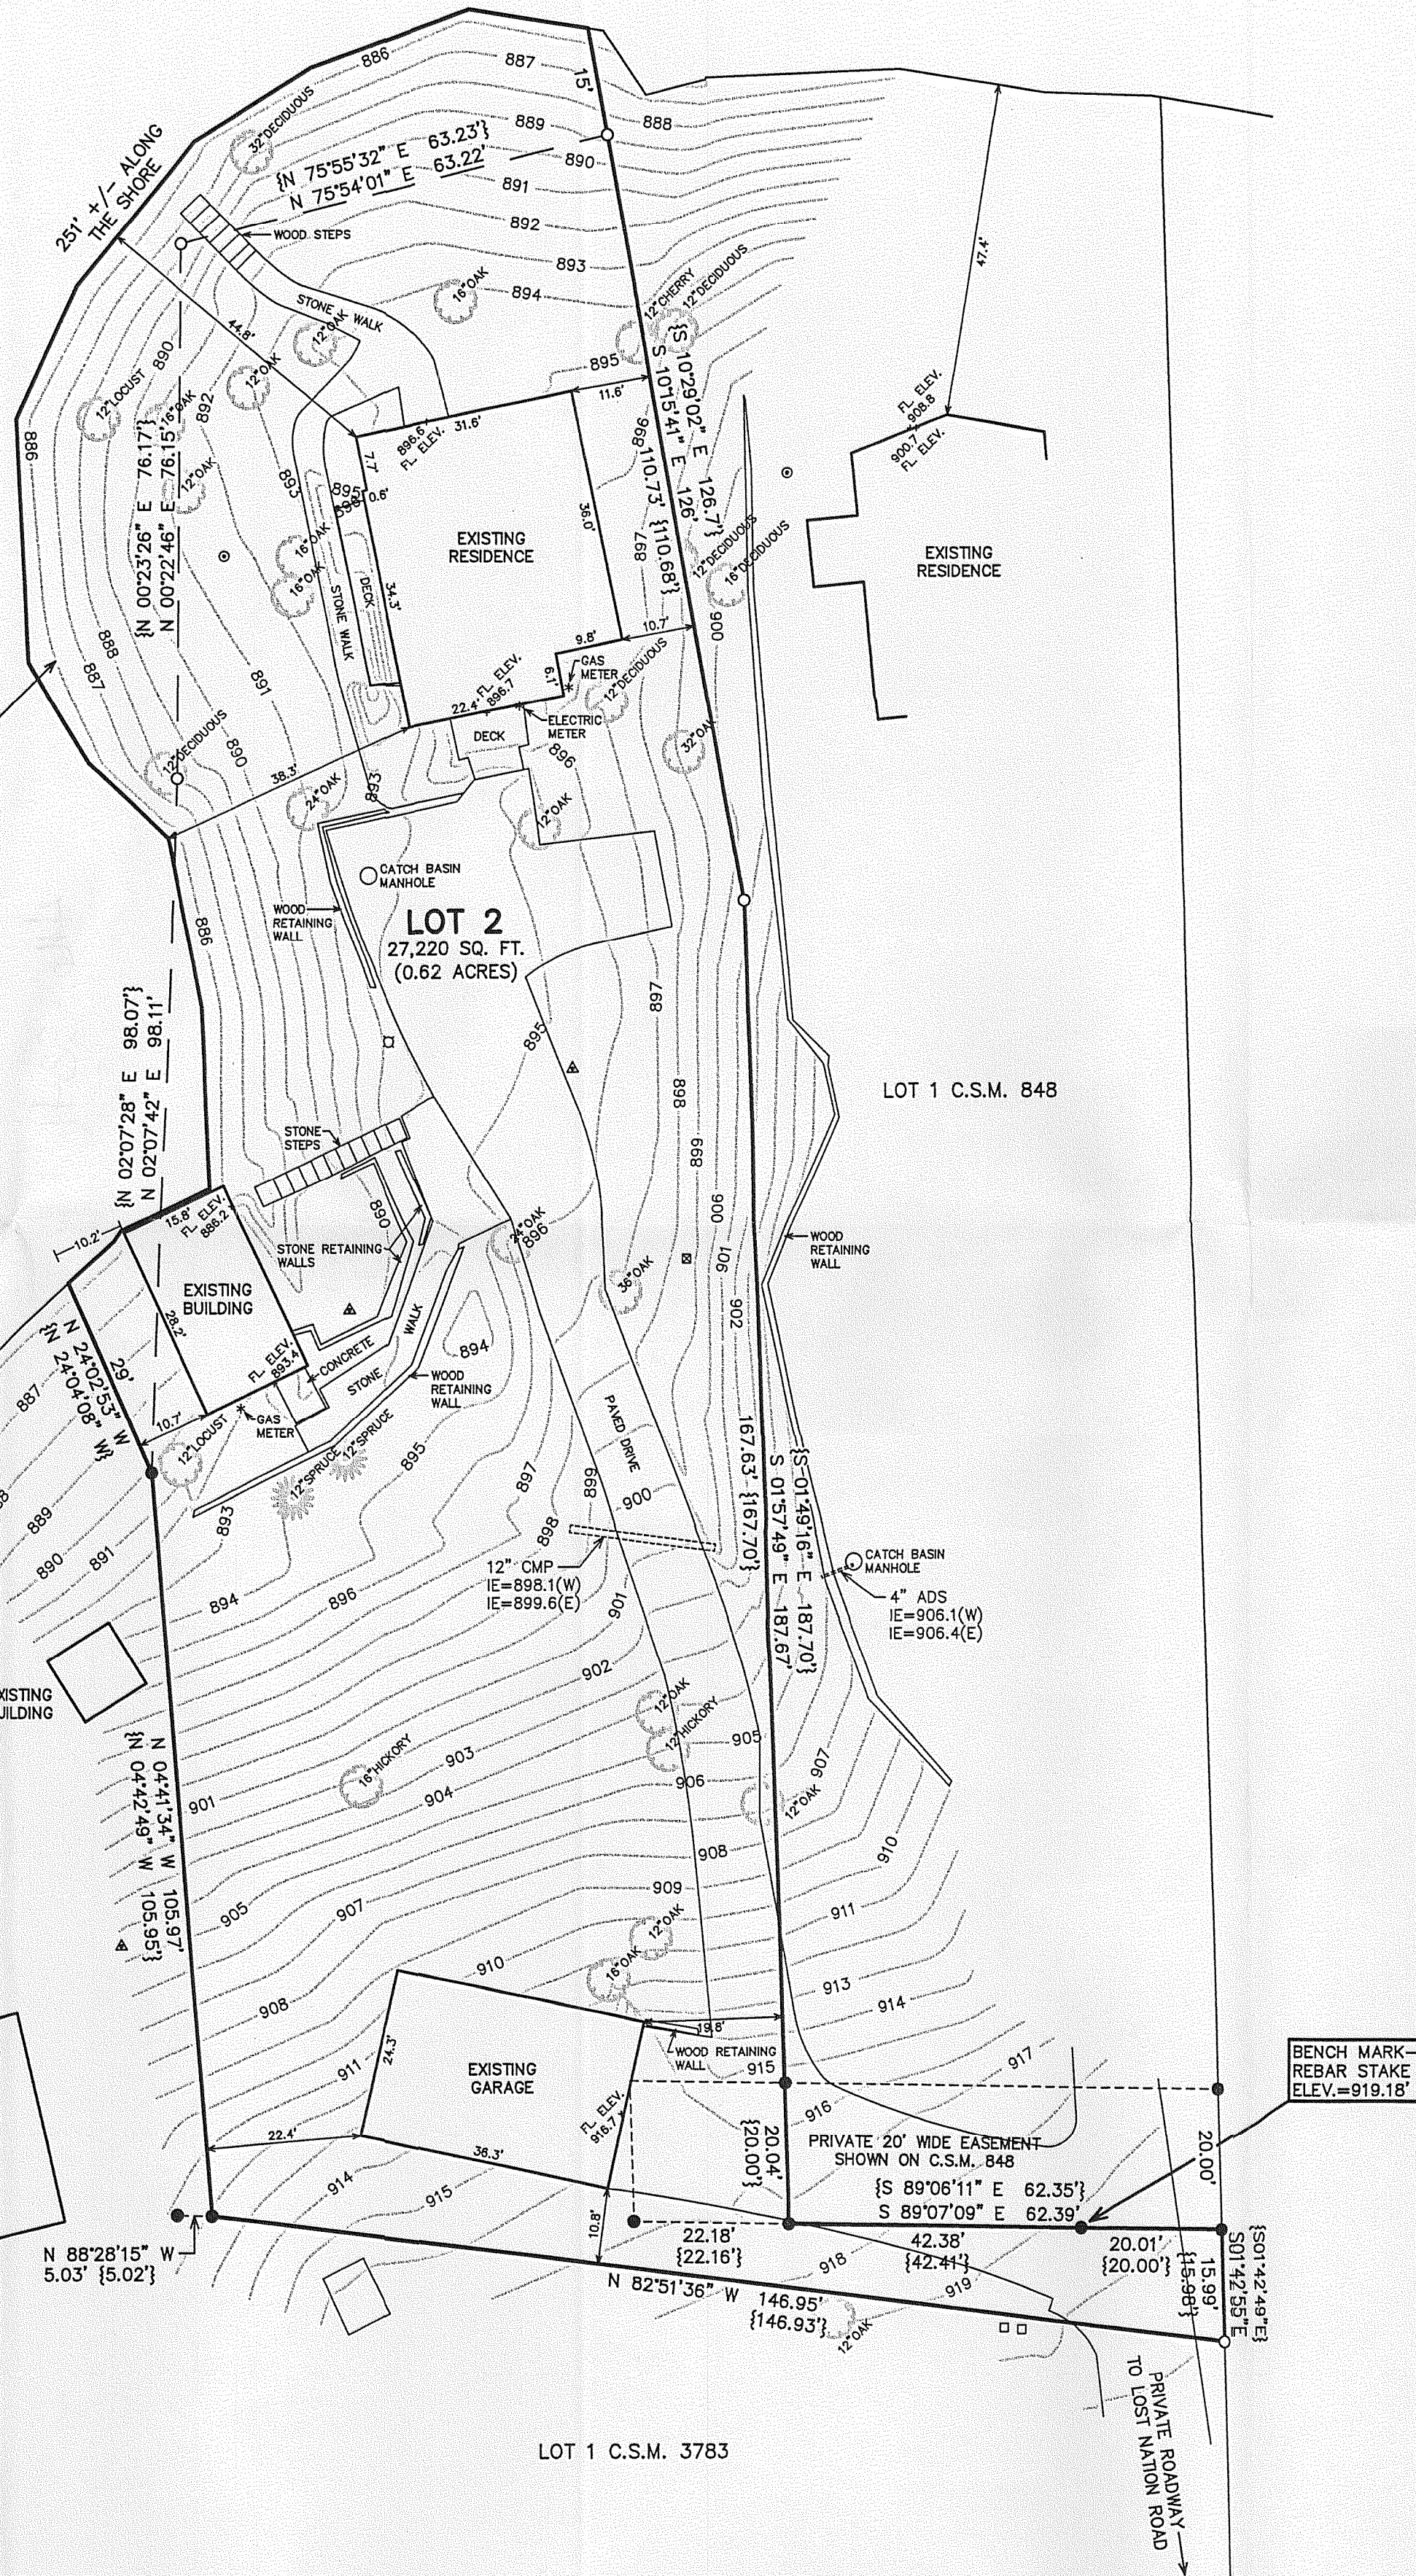

- LEGEND
- = FOUND IRON PIPE STAKE
 - = FOUND IRON REBAR STAKE
 - ⊙ = WELL LOCATED
 - ▲ = SEPTIC LID LOCATED
 - = TRANSFORMER LOCATED
 - = UTILITY BOX LOCATED
 - = LIGHT POLE LOCATED
 - {XXX} = RECORDED AS

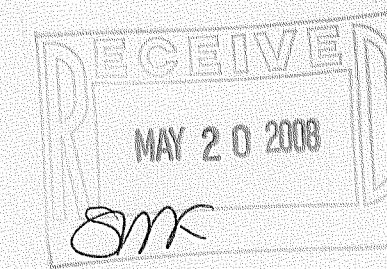


NOTE: COPIES OF THIS MAP TO WHICH THE FOLLOWING CERTIFICATE
WILL APPLY SHOW THE SURVEYOR'S ORIGINAL SEAL AND SIGNATURE
IN RED INK. COPIES BY ANY OTHER MEANS MAY HAVE ALTERATIONS
WHICH DO NOT REPRESENT THE SURVEYOR'S WORK PRODUCT.

I HEREBY CERTIFY THAT THE ABOVE DESCRIBED PROPERTY HAS BEEN
SURVEYED UNDER MY DIRECTION AND THAT THE ABOVE MAP IS A TRUE
REPRESENTATION THEREOF AND SHOWS THE SIZE AND LOCATION OF
THE PROPERTY AND ITS EXTERIOR BOUNDARIES. THIS SURVEY IS
MADE FOR THE USE OF THE PRESENT OWNERS OF THE PROPERTY, AND
ALSO THOSE WHO PURCHASE, MORTGAGE, OR GUARANTEE THE TITLE
THERE TO WITHIN ONE YEAR FROM THE DATE HEREOF.

DATED: 4/17/2008

PETER S. GORDON
S-2101
ELKHORN,
WI

PETER S. GORDON R.L.S. 2101

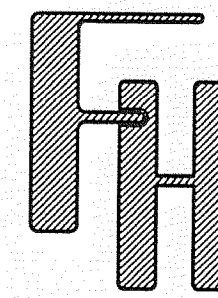

PLAT OF SURVEY


TOWN OF LA GRANGE, WALWORTH COUNTY, WISCONSIN

WORK ORDERED BY -
JEFF MATHIS
615 GREGORY AVENUE
WILMETTE, IL 60091

FARRIS, HANSEN & ASSOCIATES, INC.
ENGINEERING - ARCHITECTURE - SURVEYING
7 RIDGWAY COURT P.O. BOX 437
ELKHORN, WISCONSIN 53121
OFFICE: (262) 723-2098 FAX: (262) 723-5886

REVISIONS

PROJECT NO.
7596
DATE
04/17/2008
SHEET NO.
1 OF 1

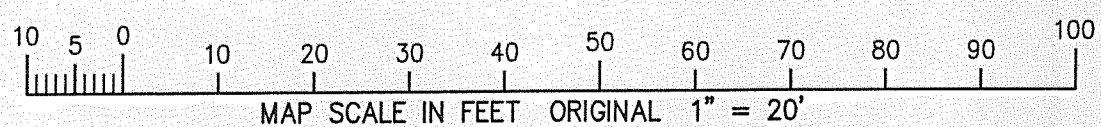

HA3783-2

416-2841