


LAND-MARK SURVEYING

Mark L. Miritz

Wisconsin Registered Land Surveyor S-2582


N9330 Knuteson Drive
Whitewater, WI 53190
Phone: (262) 495-3284
FAX : (262) 495-8421
LAND-MARKSURVEYING.COM

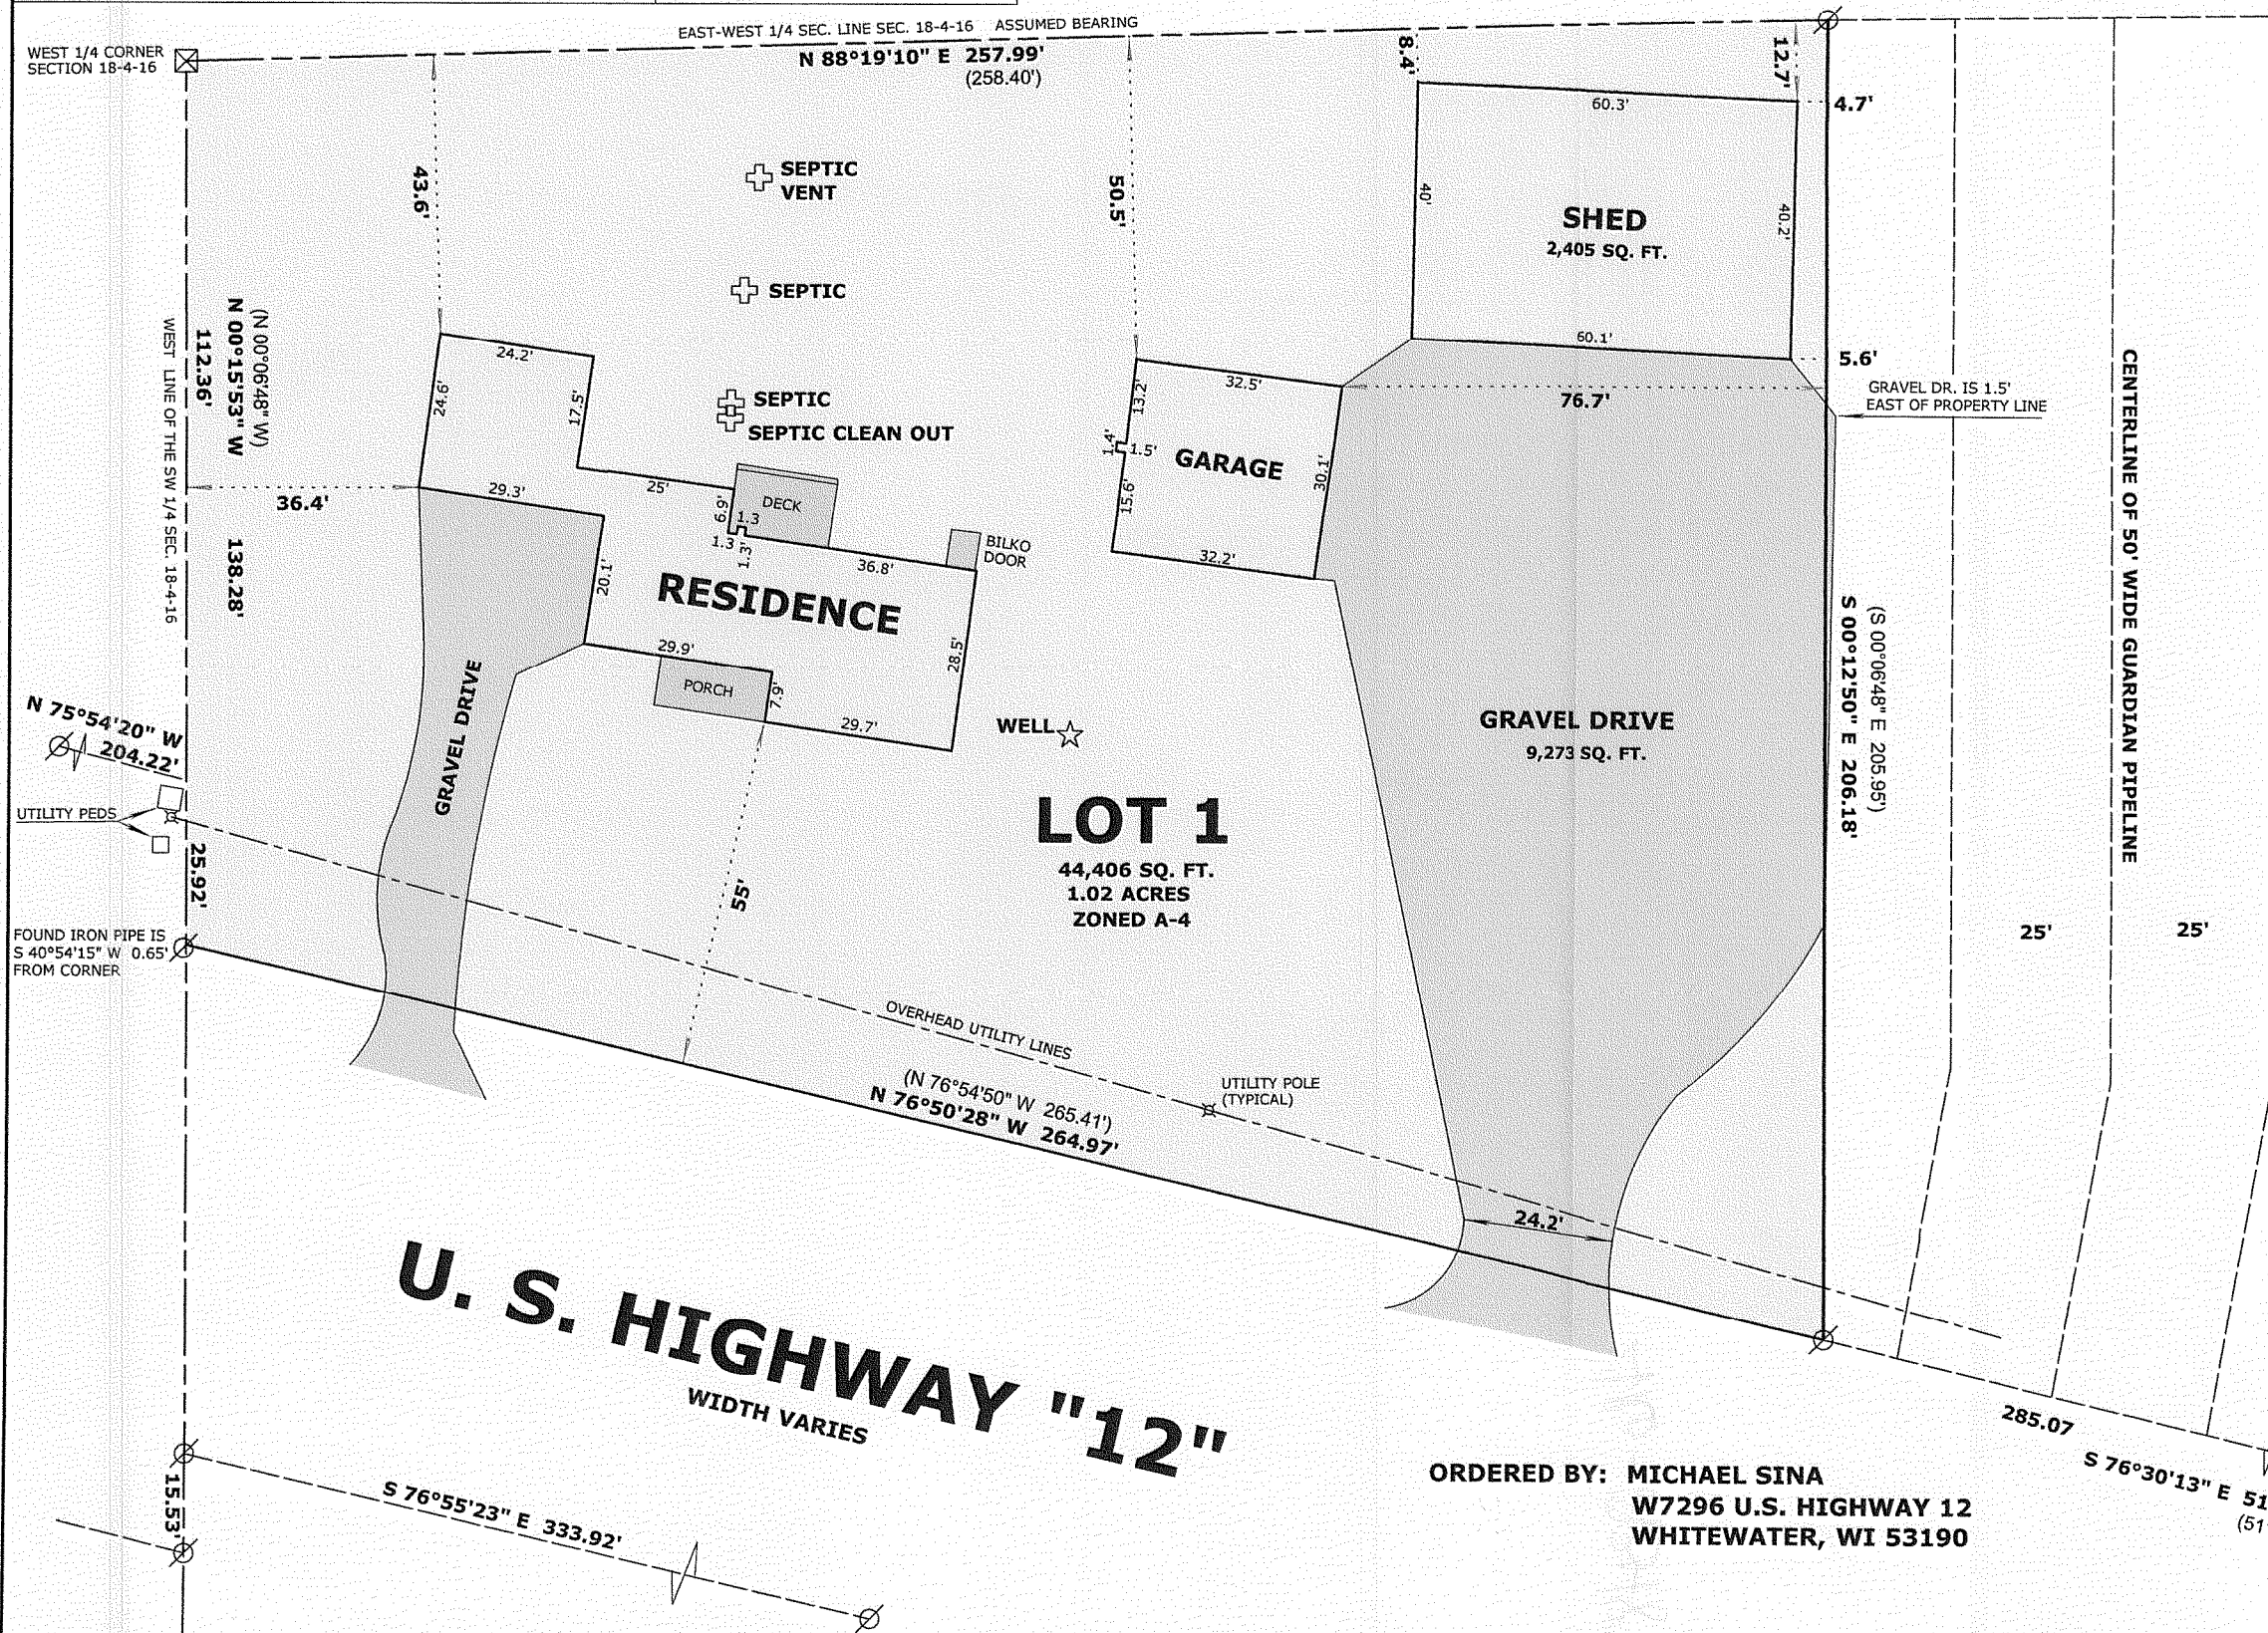


(N 89°11'11" E 502.15')
N 88°56'04" E 502.13'

PLAT OF SURVEY

LOT 1 OF CERTIFIED SURVEY MAP NO. 441, LOCATED IN THE NORTHWEST 1/4 OF THE SOUTHWEST 1/4 OF SECTION 18, TOWN 4 NORTH, RANGE 16 EAST, LaGRANGE TOWNSHIP, WALWORTH COUNTY, WISCONSIN.

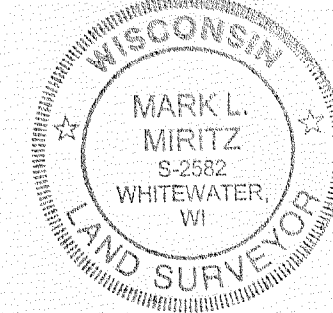

C.S.M. NO. 736

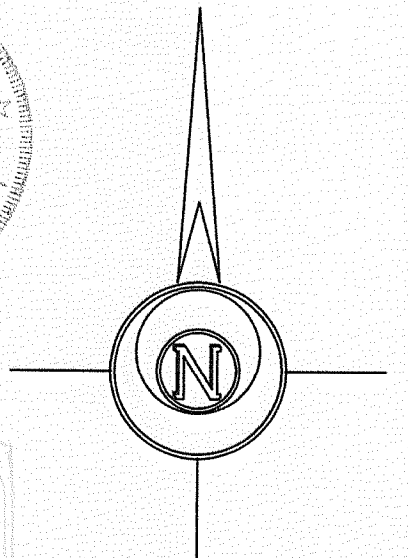

LEGEND

- FOUND IRON PIPE
- FOUND IRON ROD
- FOUND COUNTY MONUMENT
- RECORDED AS DIMENSION

SCALE: 1" = 30 FEET

"I hereby certify that the above described property has been surveyed by me or under my direction and that the above map is a true representation thereof and shows the size and location of the property, its exterior boundaries, the location of all visible structures and dimensions of all principal buildings thereon, boundary fences, apparent easements, roadways and visible encroachments, if any."
"This survey is made for the use of the present owners of the property, and also those who purchase, mortgage, or guarantee the title thereto within one year from date hereof."

Mark L. Miritz
MARK L. MIRITZ
WISCONSIN REGISTERED
LAND SURVEYOR S-2582

DATE: JUNE 3, 2008 JOB NO. 08.513

ORDERED BY: MICHAEL SINA
W7296 U.S. HIGHWAY 12
WHITEWATER, WI 53190

U. S. HIGHWAY "12"
WIDTH VARIES

S 76°55'23" E 333.92'

285.07
S 76°30'13" E 511.56'
(511.78')

226.49'

HA 441-1

416-2348