


PLAT OF SURVEY

LOT 3 OF CLOVERLEAF ACRES, A SUBDIVISION OF PART OF THE SOUTHWEST 1/4 OF THE NORTHWEST 1/4 OF SECTION 18, TOWN 4 NORTH, RANGE 16 EAST, LAGRANGE TOWNSHIP, WALWORTH COUNTY, WISCONSIN.

**OWNERS: JEFFREY E. SCHNELL
TINA L. SCHNELL
N8725 CLOVERLEAF LANE
WHITEWATER, WI 53190**

LOT 4

(S 89°29'00" E 279.83')
S 89°28'00" E 279.86'

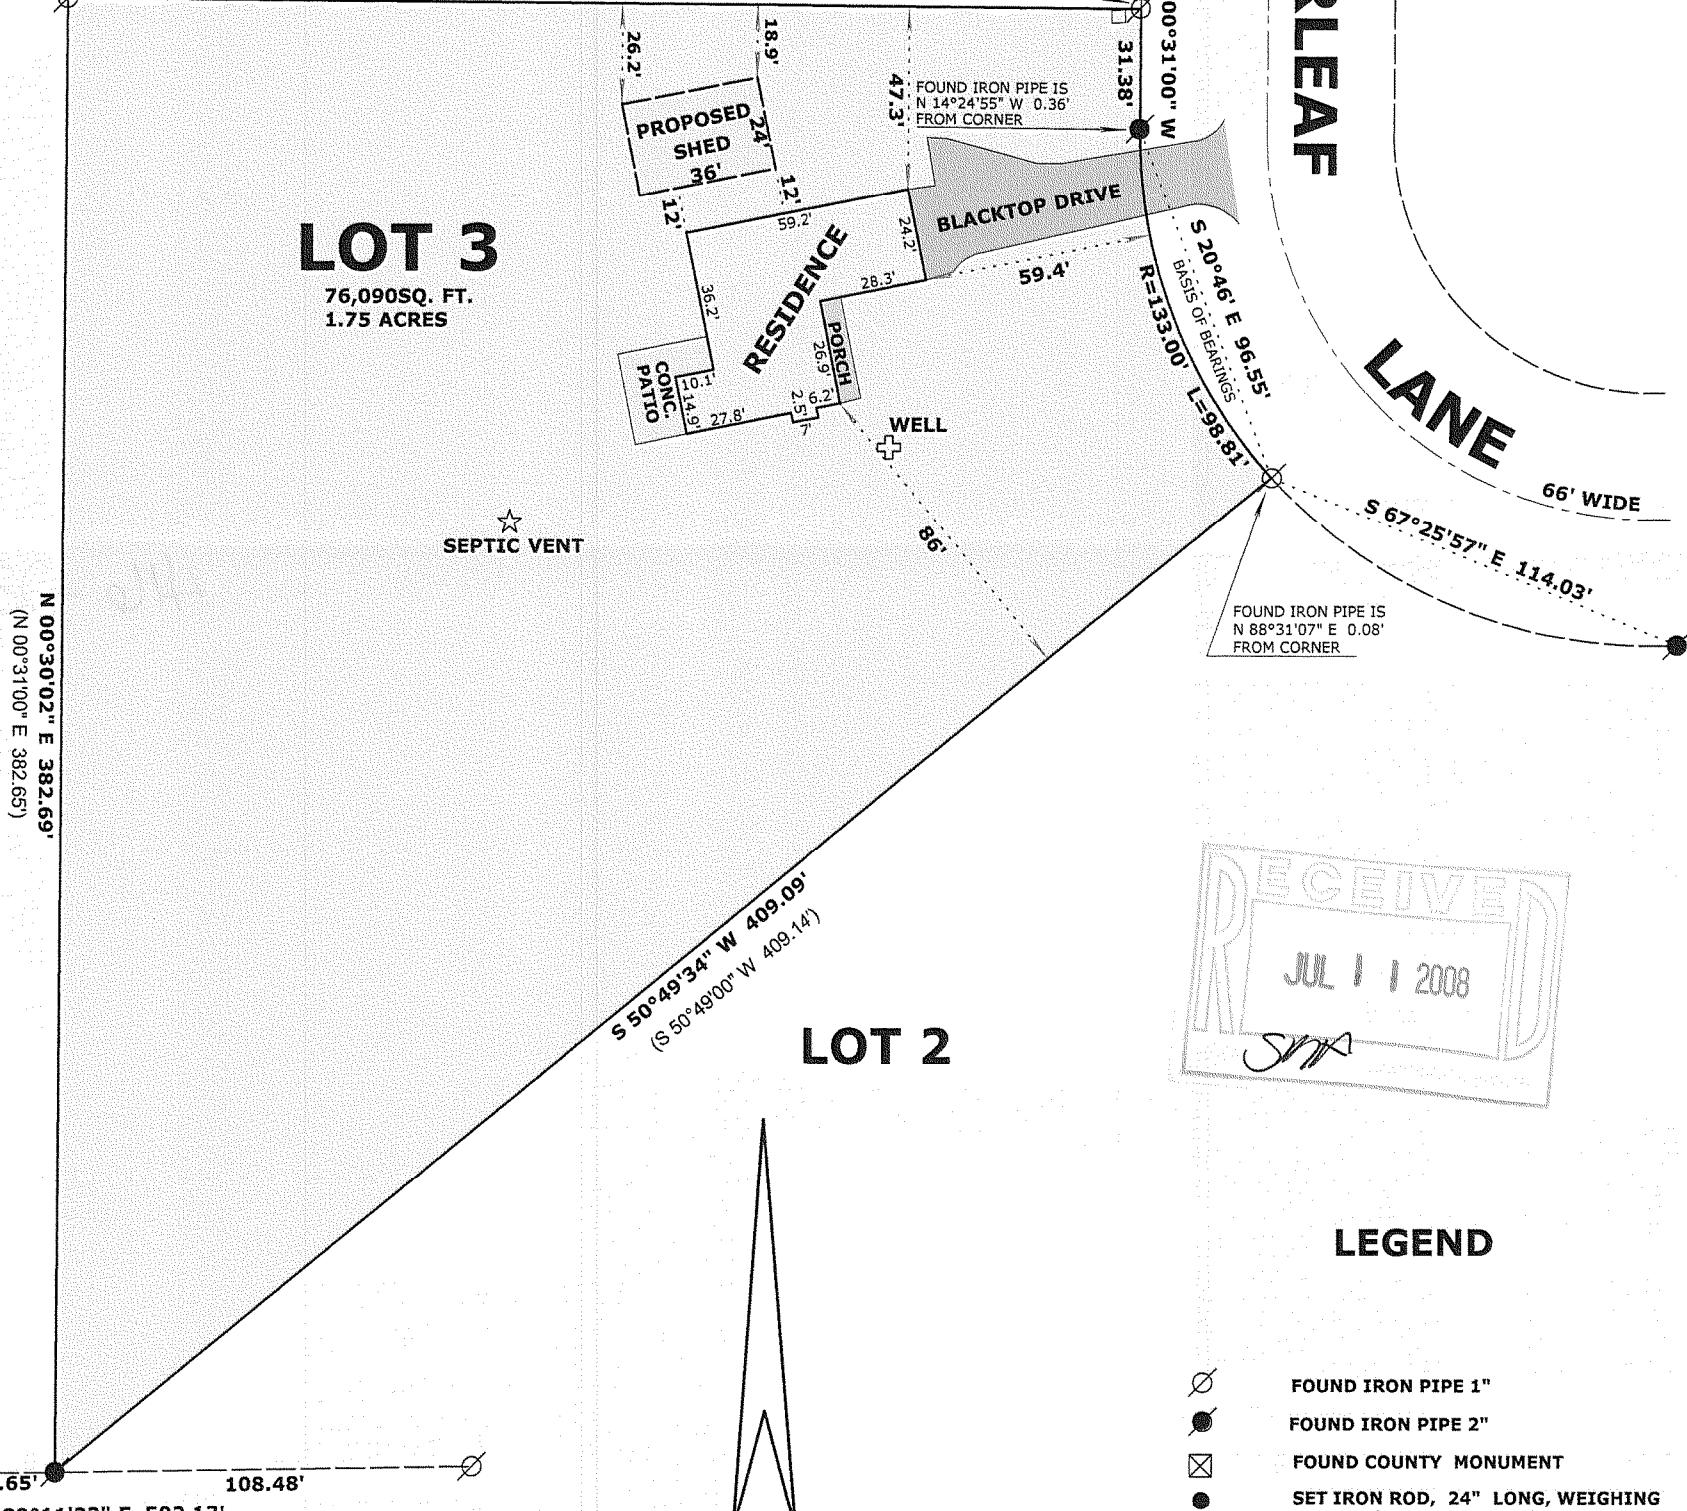

NW CORNER C.S.M. NO. 736



LEGEND

- FOUND IRON PIPE 1"
- FOUND IRON PIPE 2"
- FOUND COUNTY MONUMENT
- SET IRON ROD, 24" LONG, WEIGHING 1.5 LBS./LINEAL FT., 3/4" DIA.
- (xx) RECORDED AS DIMENSION
- X — EXISTING FENCE

SCALE: 1 INCH = 50 FEET

"I hereby certify that the above described property has been surveyed by me or under my direction and that the above map is a true representation thereof and shows the size and location of the property, its exterior boundaries, the location of all visible structures and dimensions of all principal buildings thereon, boundary fences, apparent easements, roadways and visible encroachments, if any." "This survey is made for the use of the present owners of the property, and also those who purchase, mortgage, or guarantee the title thereto within one year from date hereof."

Mark L. Miritz
MARK L. MIRITZ
WISCONSIN REGISTERED
LAND SURVEYOR S-2582

DATE: JUNE 7, 2008 JOB NO. 08.512

HCF-3

411n-0349