


REVISIONS	
08/17/2005	ADD ADDITIONAL INFORMATION
08-13-2005	ADD REVISED SHORELINE
11-16-2005	ADD 2005 TYPICAL FLOOD ELEVATION AND 100-YEAR FLOOD ELEVATION
5-16-2007-KB	TO SHOW SIZE AND LOCATION OF PROPOSED RESERVOIR
05-14-2008	REVISED POLL & HOT TUB
10/23/2008-KB	TO SHOW 65' SETBACK & DIMS.

FARRIS, HANSEN & ASSOCIATES, INC.
ENGINEERING - ARCHITECTURE - SURVEYING
7 RIDGWAY COURT P.O. BOX 437
ELKHORN, WISCONSIN 53121
OFFICE: (262) 723-2098 FAX: (262) 723-5886


— WORK ORDERED BY —
THELEN TOTAL CONSTRUCTION
P.O. BOX 17
ELKHORN, WI. 53121

PLAT OF SURVEY
TOPOGRAPHIC MAPPING

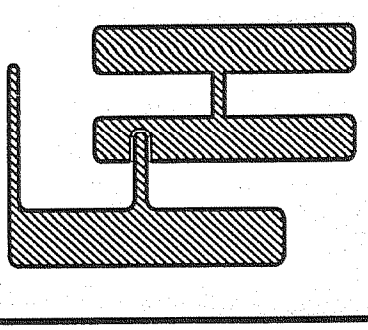

PLAT OF SURVEY & TOPOGRAPHIC MAPPING

THE WESTERLY 1/2 OF LOT 8 AND ALL OF LOT 9 IN THE PLAT OF MORRIS PARK, A SUBDIVISION LOCATED IN THE SW 1/4 OF SECTION 26, TOWN 4 NORTH, RANGE 16 EAST, WALWORTH COUNTY, WISCONSIN

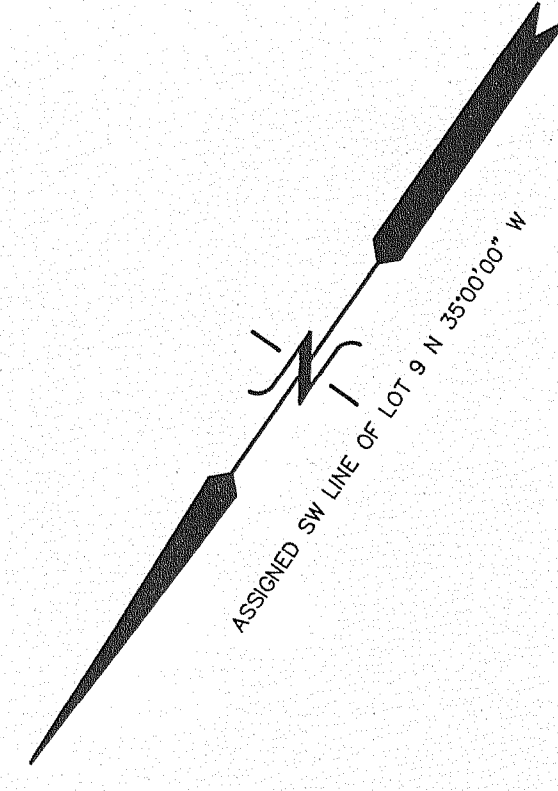

NOTE: COPIES OF THIS MAP TO WHICH THE FOLLOWING CERTIFICATE WILL APPLY SHOW SUPERVISOR'S ORIGINAL SEAL AND SIGNATURE IN RED INK. COPIES BY ANY OTHER MEANS MAY HAVE ALTERATIONS WHICH DO NOT REPRESENT THE SUPERVISOR'S WORK PRODUCT.

PETER S.
GORDON
S-2101
ELKHORN,
WI

DATE: 9-25-2003
 REVISION: 10-31-2007
 UPDATE TO TITLE SPEC'S

REVISED 08-22-2008
 AS BUILT POOL & HOT TUB LOCATION

REVISED 12-11-2008
 TO SHOW AS BUILT SIDEWALK


 PETER S. GORDON R.L.S. 2101

