

Plat of Survey


of

Lot 3 of Certified Survey Map No. 3533,




recorded in Vol. 20 of Certified Survey Maps of Walworth County on Page 315 and located in the Northwest 1/4 of the Southeast 1/4 of Section 11, Town 4 North, Range 16 East, Town of LaGrange, Walworth County, Wisconsin.

Surveyed for: **Dennis & Eileen Schaeffer**

W5440 Whitetail Trail
Whitewater, Wisconsin. 53190

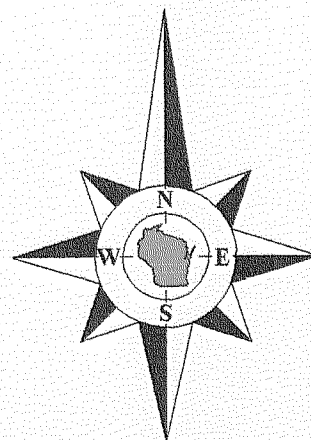

Bearings referenced to Certified Survey Map No. 3533.

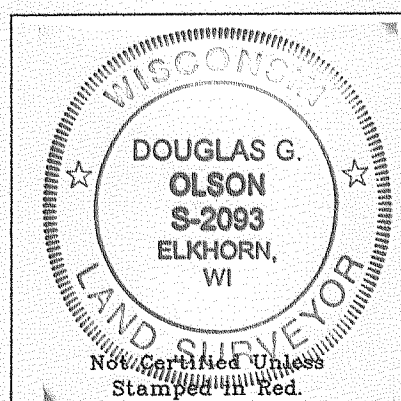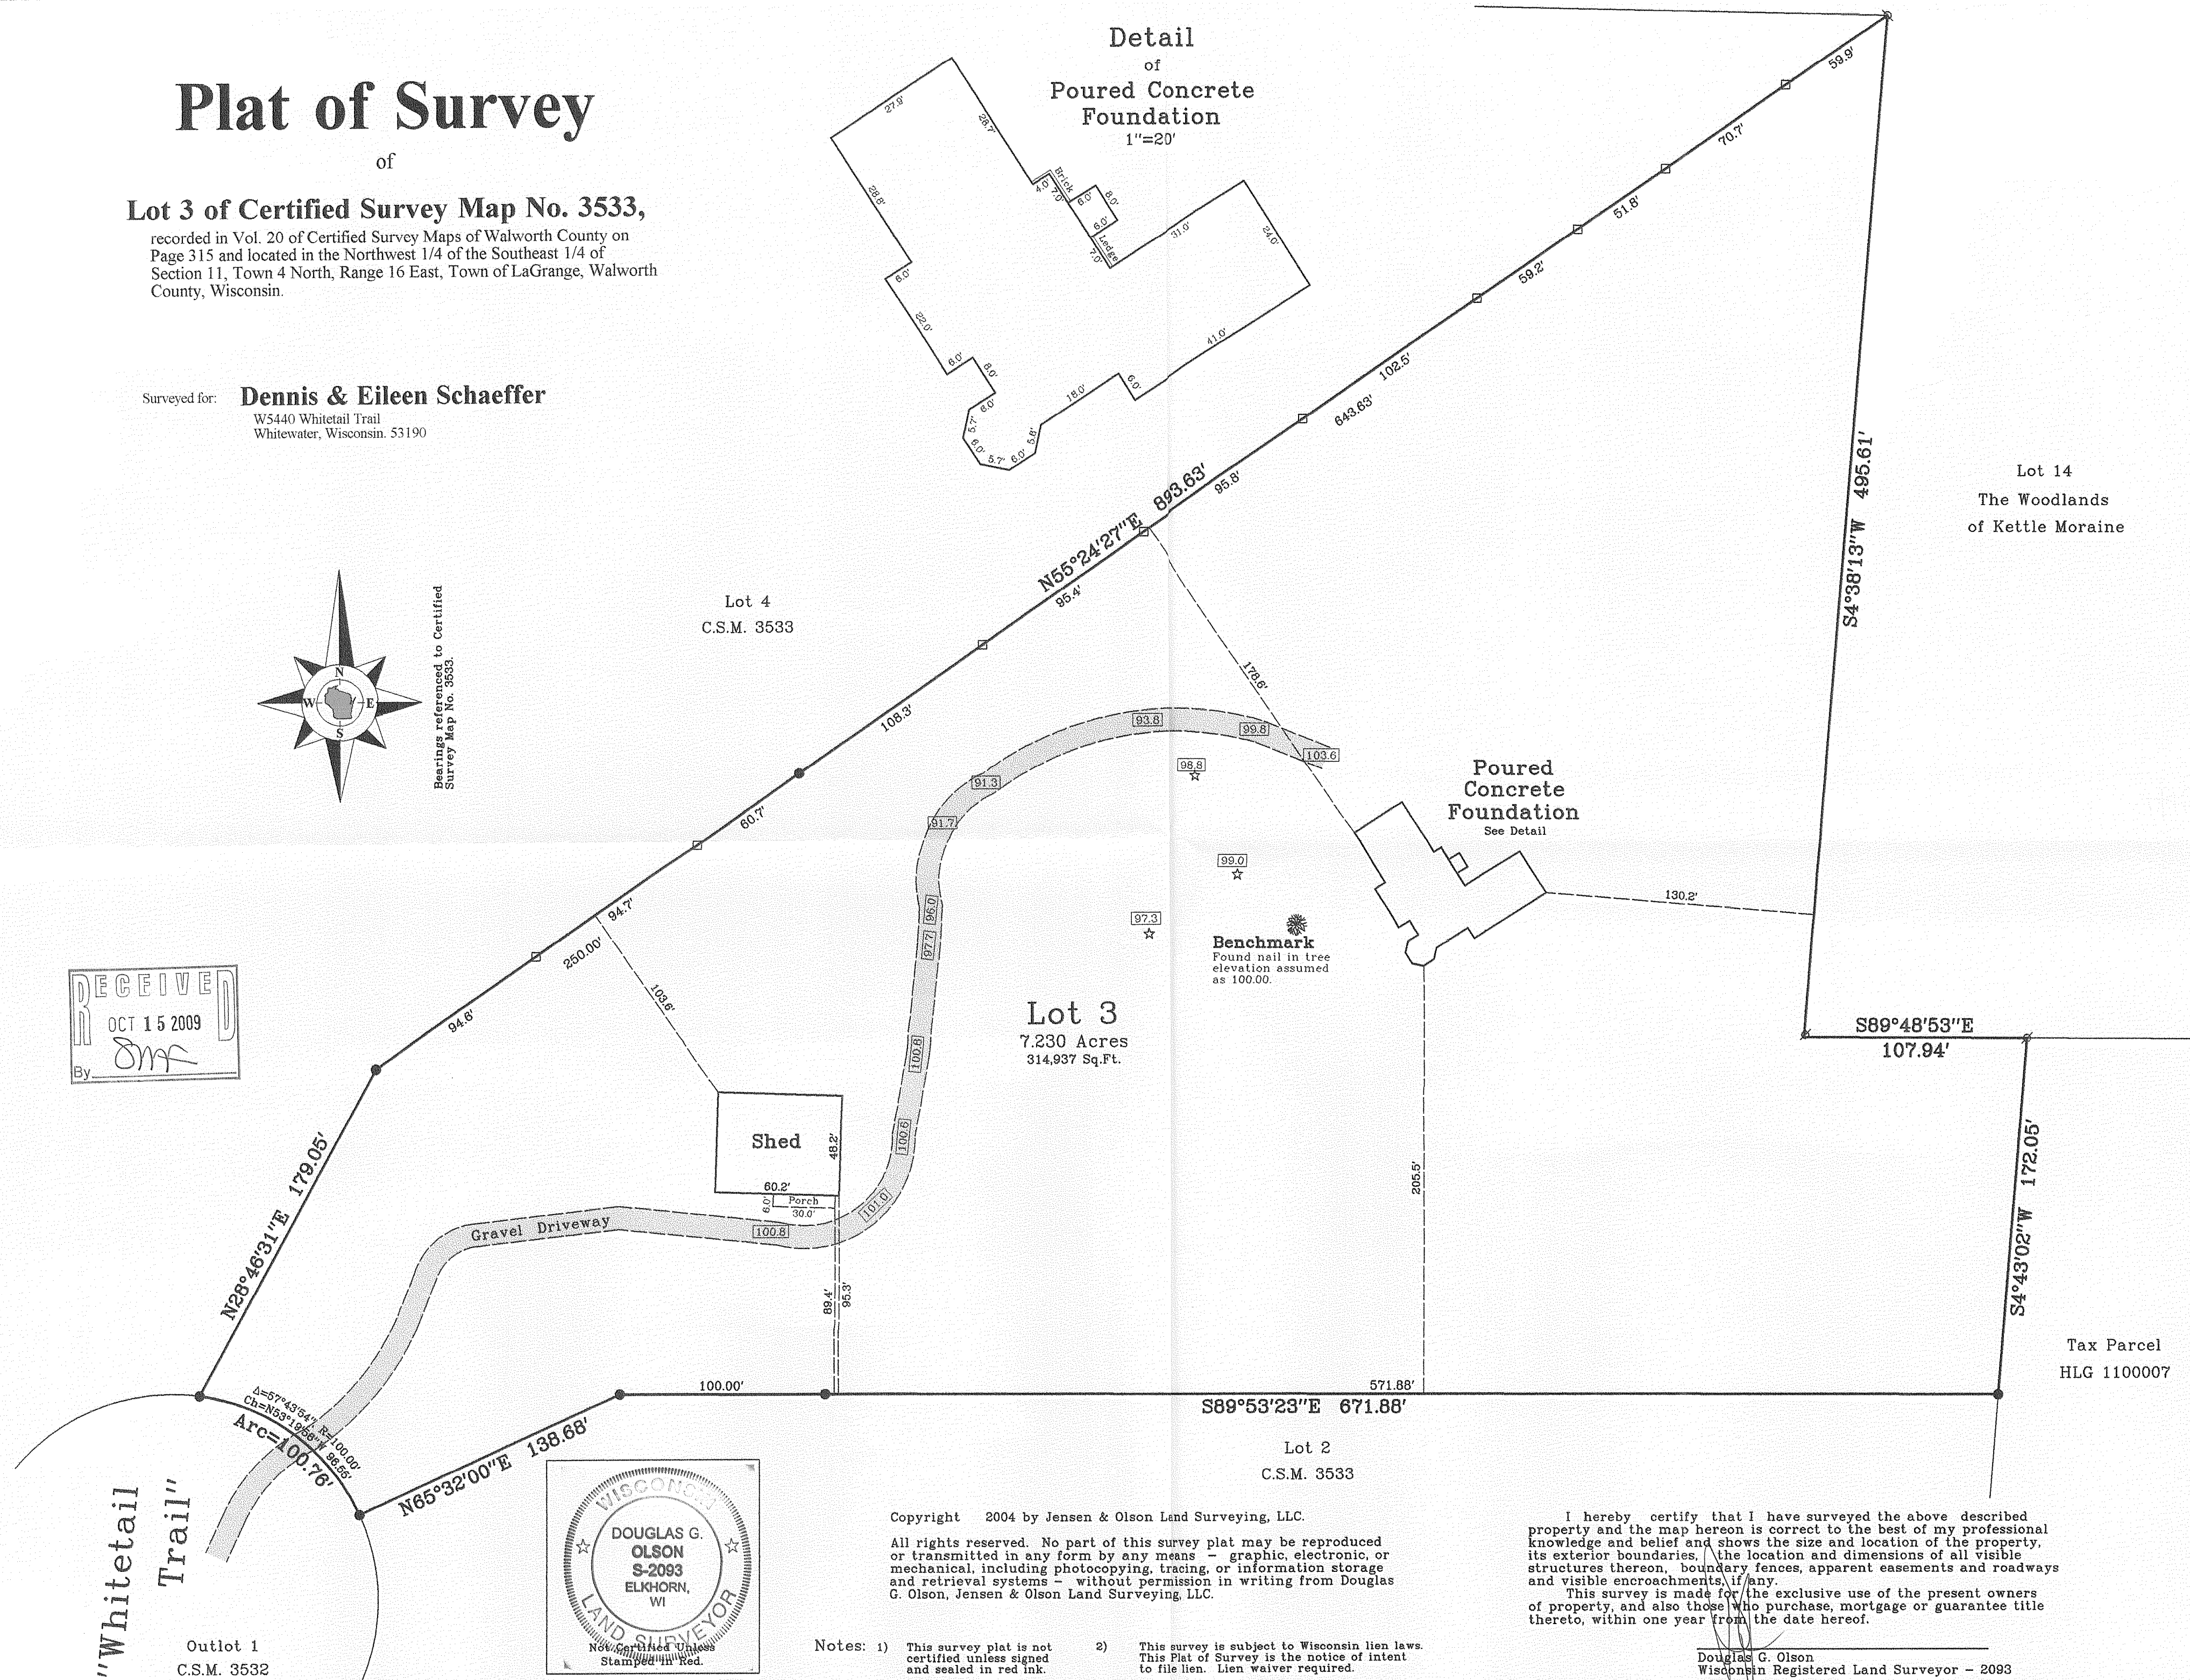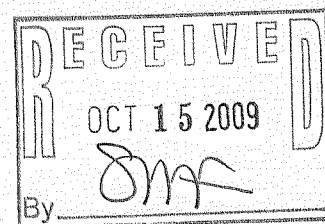

Copyright 2004 by Jensen & Olson Land Surveying, LLC.


All rights reserved. No part of this survey plat may be reproduced or transmitted in any form by any means - graphic, electronic, or mechanical, including photocopying, tracing, or information storage and retrieval systems - without permission in writing from Douglas G. Olson, Jensen & Olson Land Surveying, LLC.

- Notes: 1) This survey plat is not certified unless signed and sealed in red ink. 2) This survey is subject to Wisconsin lien laws. This Plat of Survey is the notice of intent to file lien. Lien waiver required.

I hereby certify that I have surveyed the above described property and the map hereon is correct to the best of my professional knowledge and belief and shows the size and location of the property, its exterior boundaries, the location and dimensions of all visible structures thereon, boundary fences, apparent easements and roadways and visible encroachments, if any.
This survey is made for the exclusive use of the present owners of property, and also those who purchase, mortgage or guarantee title thereto, within one year from the date hereof.

Douglas G. Olson
Wisconsin Registered Land Surveyor - 2093

Survey Date: May 10, 2004.
Revisions: No. 1 - Foundation
Set Lath on
No. 2 - North line

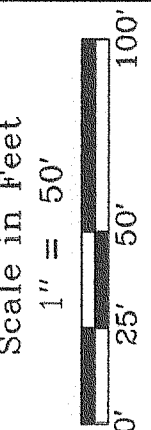

Jensen & Olson Land Surveying, LLC
45 South Wisconsin Street * P.O. Box 322 * Elkhorn, Wisconsin. 53121
Telephone: (262) 723-3434 * Facsimile: (262) 723-8044
Email: jensen.olson@elknet.net

Legend
Found Iron Pipe
Found Iron Rod
Set Lath, 04-03-09
() Recorded Information
☆ Soil Boring
Gravel Surface

Sheet 1 of 1 Sheets
Job Reference Number
2009.015

2009.015

HA3533-3

416-2419