

WORK ORDERED BY -
ROBERT GRAPPLE
5691 FORREST ROAD
ELKHORN, WI 53121

FARRIS, HANSEN & ASSOCIATES, INC.
ENGINEERING - ARCHITECTURE - SURVEYING
7 RIDGWAY COURT P.O. BOX 437
ELKHORN, WISCONSIN 53121
OFFICE: (262) 723-2098 FAX: (262) 723-5886

REVISIONS

PROJECT NO.
6629
DATE:
09/07/04
SHEET NO.
1 OF 1

PLAT OF SURVEY

LOTS 6 THRU 8 OF BLOCK 2 OF
COOPERS MID LAKES SUBDIVISION
LOCATED IN PART OF SECTION 35, TOWN 4 NORTH,
RANGE 16 EAST, WALWORTH COUNTY, WISCONSIN

FOREST ROAD
30' WIDE R.O.W.

GUY WIRE
EDGE OF GRAVEL

N 84°05'20" E
150.74'
(N 84°00'05" E)
(150.75')

EXISTING GARAGE
25.0'
22.1'
24.9'
1.0'
20.0'
22.0'
PROPOSED GARAGE

WOOD FENCE

SEPTIC VENT

WELL

CONCRETE WALK

as built ADDITION

EXISTING RESIDENCE

WOOD STEPS

WOOD DECK

WOOD STEPS

CEDAR WALK


CEDAR WALK

MIDDLE
154' +/- ALONG

PIER
LAKE
THE SHORE

LEGEND

- = FOUND IRON PIPE STAKE
- = FOUND IRON REBAR STAKE
- (XXX) = RECORDED AS

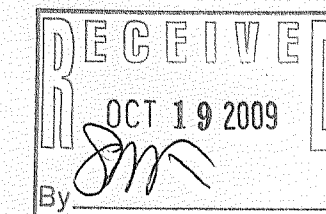

NOTE: COPIES OF THIS MAP TO WHICH THE FOLLOWING CERTIFICATE
WILL APPLY SHOW THE SURVEYOR'S ORIGINAL SEAL AND SIGNATURE
IN RED INK. COPIES BY ANY OTHER MEANS MAY HAVE ALTERATIONS
WHICH DO NOT REPRESENT THE SURVEYOR'S WORK PRODUCT.


I HEREBY CERTIFY THAT THE ABOVE DESCRIBED PROPERTY HAS BEEN
SURVEYED UNDER MY DIRECTION AND THAT THE ABOVE MAP IS A TRUE
REPRESENTATION THEREOF AND SHOWS THE SIZE AND LOCATION OF
THE PROPERTY AND ITS EXTERIOR BOUNDARIES. THIS SURVEY IS
MADE FOR THE USE OF THE PRESENT OWNERS OF THE PROPERTY, AND
ALSO THOSE WHO PURCHASE, MORTGAGE, OR GUARANTEE THE TITLE
THERETO WITHIN ONE YEAR FROM THE DATE HEREOF.

DATED: SEPTEMBER 7, 2004

REVISED 11-07-2005
TO SHOW SIZE & LOCATION OF
PROPOSED ADDITION

REVISED 09-15-2009
TO SHOW AS BUILT ADDITION &
PROPOSED GARAGE

PETER S. GORDON R.L.S. 2101

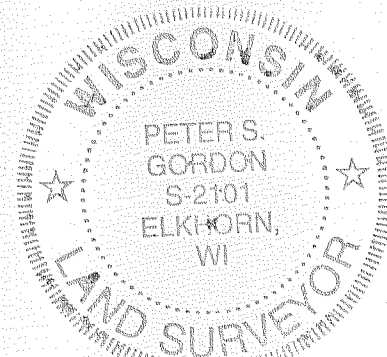

10 5 0 10 20 30 40 50 60 70 80 90 100
MAP SCALE IN FEET ORIGINAL 1" = 20'

HCD-8

416-2424