

LAND-MARK SURVEYING

Mark L. Miritz


Wisconsin Registered Land Surveyor S-2582

N9330 Knuteson Drive
Whitewater, WI 53190
Phone: (262) 495-3284
FAX: (262) 495-8421
LAND-MARKSURVEYING.COM


PLAT OF SURVEY

LOTS 1 THROUGH LOT 10, BLOCK 8,
OF COOPER'S MID-LAKES SUBDIVISION
TOGETHER WITH THE NORTH HALF OF
VACATED PARK ROAD BETWEEN BLOCK
8 AND BLOCK 9, ALL IN COOPER'S MID-
LAKE SUBDIVISION LOCATED IN THE
NORTHWEST 1/4 OF SECTION 35, TOWN
4 NORTH, RANGE 16 EAST, LAGRANGE
TOWNSHIP, WALWORTH COUNTY, WISCONSIN

OWNER: RODGER KUHNKE
W5648 PARK ROAD
ELKHORN, WI 53121

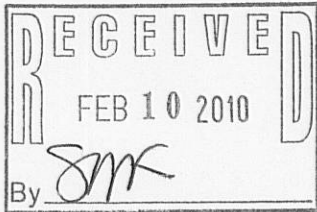


NORTH ROAD A.K.A. DEER PATH ROAD

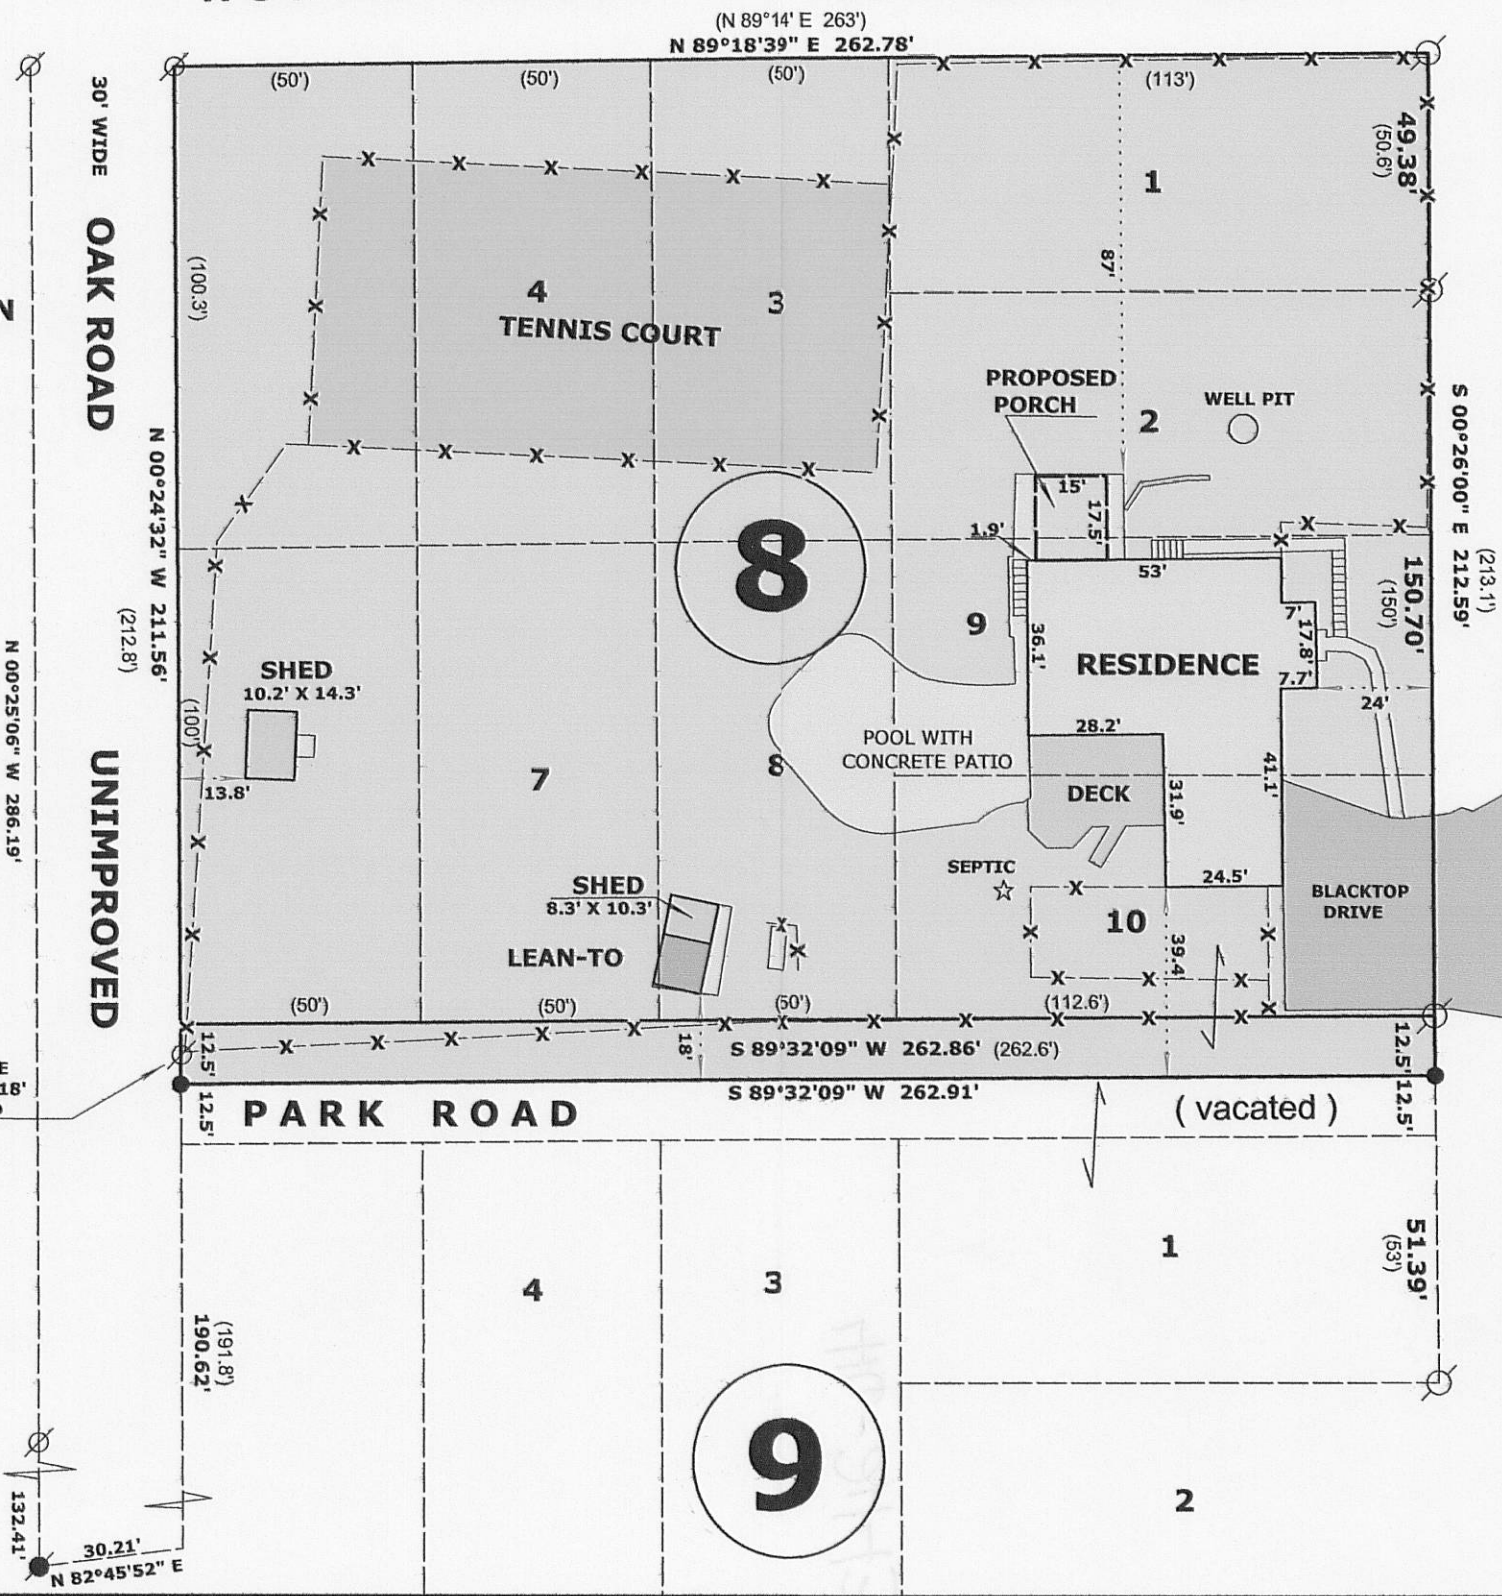

POINT DESCRIBED AS THE NE CORNER OF THE NW 1/4 OF THE NORTH WEST 1/4 SECTION 35-4-16 ON COOPER'S MID-LAKES SUBDIVISION AND REFERED TO AS THE NORTH 1/16 CORNER ON THE NORTH LINE OF THE NW 1/4 OF SECTION 35-4-16 ON SURVEYS & DEEDS.

THE WESTERLY LINE OF EAST ROAD WAS ASSUMED TO BEAR S 0°26'00" E AS PLATTED

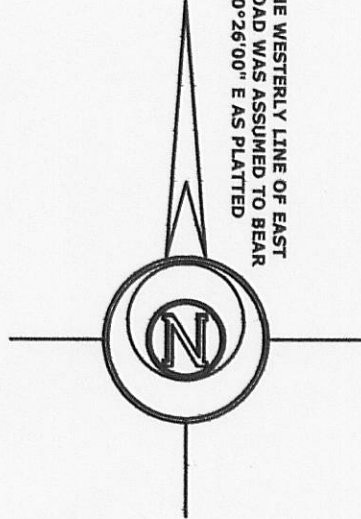

LEGEND

- FOUND IRON PIPE
- FOUND IRON ROD
- FOUND CONCRETE MONUMENT
- CONCRETE
- SET IRON ROD, 24" LONG, WEIGHING 1.5 LBS./LINEAL FT., 3/4" DIA.
- RECORDED AS DIMENSION
- EXISTING FENCE

SCALE: 1 INCH = 40 FEET

"I hereby certify that the above described property has been surveyed by me or under my direction and that the above map is a true representation thereof and shows the size and location of the property, its exterior boundaries, the location of all visible structures and dimensions of all principal buildings thereon, boundary fences, apparent easements, roadways and visible encroachments, if any."
"This survey is made for the use of the present owners of the property, and also those who purchase, mortgage, or guarantee the title thereto within one year from date hereof."

Mark L. Miritz
MARK L. MIRITZ
WISCONSIN REGISTERED
LAND SURVEYOR S-2582

DATE: AUGUST 19, 2009 JOB NO. 09.803

HCO-18

416-2443