


PLAT OF SURVEY

LOT 1 OF CERTIFIED SURVEY MAP NO. 836
 LOCATED IN THE SW 1/4 OF SEC. 36
 TOWN 4 NORTH, RANGE 16 EAST
 WALWORTH COUNTY, WISCONSIN

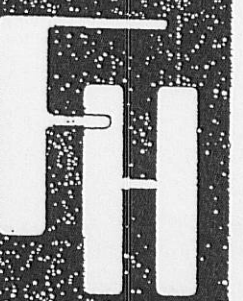

PLAT OF SURVEY
 LOT 1 OF C.S.M. 836

WORK ORDERED BY: ELLEN ZIELINSKI
 5920 NORTHEAST CIRCLE
 CHICAGO, IL.

FARRIS, HANSEN & ASSOCIATES, INC.
 Engineering, Architecture, Surveying
 7 Ridgely Court, P.O. Box 437
 ELKHORN, WISCONSIN 53121
 Office: (414) 723-2098
 Fax: (414) 723-3886

REVISIONS

PROJECT NO.
 4162
 DATE
 09/08/94
 SHEET NO.
 1 OF 1

ASSIGNED NW LINE WILKINSON ROAD
 N 39° 34' 40" E
 PER RECORD C.S.M.

LINE	BEARING	DISTANCE
L1	S 11° 48' 15" E	9.07
	(S 12° 09' 25" E)	(9.05)

- LEGEND
- = SET IRON REBAR STAKE
 - = FOUND IRON PIPE STAKE
 - ⊙ = FOUND IRON REBAR STAKE
 - = SET PK NAIL
 - (XXX) = RECORDED AS
 - XXX = As Built Measurements

MAP SCALE IN FEET
 1" = 10'


Lot width @ building setback = 52.06'
 16% = 8.33' min. side yard

Shore yard
 50' to east
 75' to west
 Average shore yard = 62.5'


NOTE: COPIES OF THIS MAP TO WHICH THE FOLLOWING CERTIFICATE WILL APPLY ARE BLUE LINE PRINTS SHOWING SURVEYOR'S ORIGINAL SEAL AND SIGNATURE IN BLUE INK. COPIES BY ANY OTHER MEANS MAY HAVE ALTERATIONS WHICH DO NOT REPRESENT THE SURVEYOR'S WORK PRODUCT.

I HEREBY CERTIFY THAT THE ABOVE DESCRIBED PROPERTY HAS BEEN SURVEYED UNDER MY DIRECTION AND THAT THE ABOVE MAP IS A TRUE REPRESENTATION THEREOF AND SHOWS THE SIZE AND LOCATION OF THE PROPERTY AND ITS EXTERIOR BOUNDARIES. THIS SURVEY IS MADE FOR THE USE OF THE PRESENT OWNERS OF THE PROPERTY, AND ALSO THOSE WHO PURCHASE, MORTGAGE, OR GUARANTEE THE TITLE THERETO WITHIN ONE YEAR FROM THE DATE HEREOF.

DATED: 9/9/94
 Revised 10/1/2009
 To show Proposed
 ADDITIONS + DECK

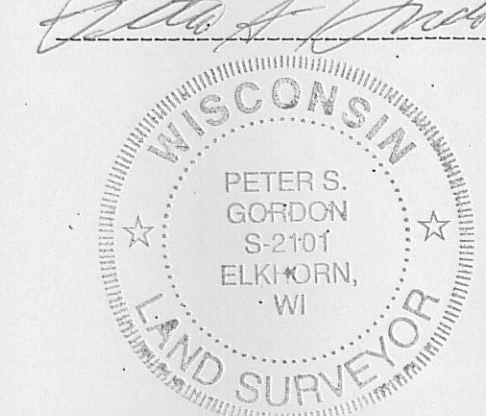

Revised
 2/12/2010
 To show
 AS BUILT ADD.

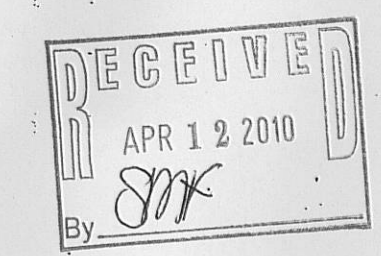

416-2451

OCT 01 2009
 OCT 02 2009
 FEB 12 2010