

RECEIVED
MAY 11 2010
By *SM*

Plat of Survey


of

Unit 67 of Lauderdale Shores A Recreational Vehicle Condominium,


located in the Northwest 1/4 of Section 25, Town 4 North, Range 16 East, Town of LaGrange, Walworth County, Wisconsin.

Surveyed for: **Thomas Vondrasek**

1193 Old Creek Court
Woodridge, Illinois. 60517

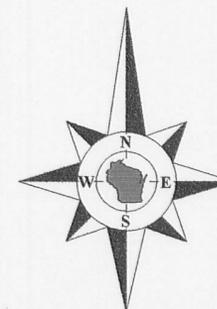

Bearings reference to the plat of Lauderdale Shores A Recreational Vehicle Condominium.

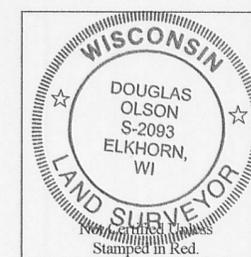

Notes:


- 1) This survey plat is not certified unless signed and sealed in red ink.
- 2) This survey is subject to Wisconsin lien laws. This Plat of Survey is the notice of intent to file lien. Lien waiver required.

Copyright 2009 by Jensen & Olson Land Surveying, LLC.


All rights reserved. No part of this survey plat may be reproduced or transmitted in any form by any means - graphic, electronic, or mechanical, including photocopying, tracing, or information storage and retrieval systems - without permission in writing from Douglas G. Olson, Jensen & Olson Land Surveying, LLC.

I, Douglas G. Olson, Wisconsin Registered Land Surveyor, do hereby certify that this survey was performed by me, or under my direction in full compliance with the owner's/agent's instructions and Chapter A-E 7 of the Wisconsin Administrative Code "Minimum Standards for Property Surveys"; and that this map is an accurate representation thereof to the best of my knowledge and belief.

Douglas G. Olson
Douglas G. Olson
Wisconsin Registered Land Surveyor - 2093

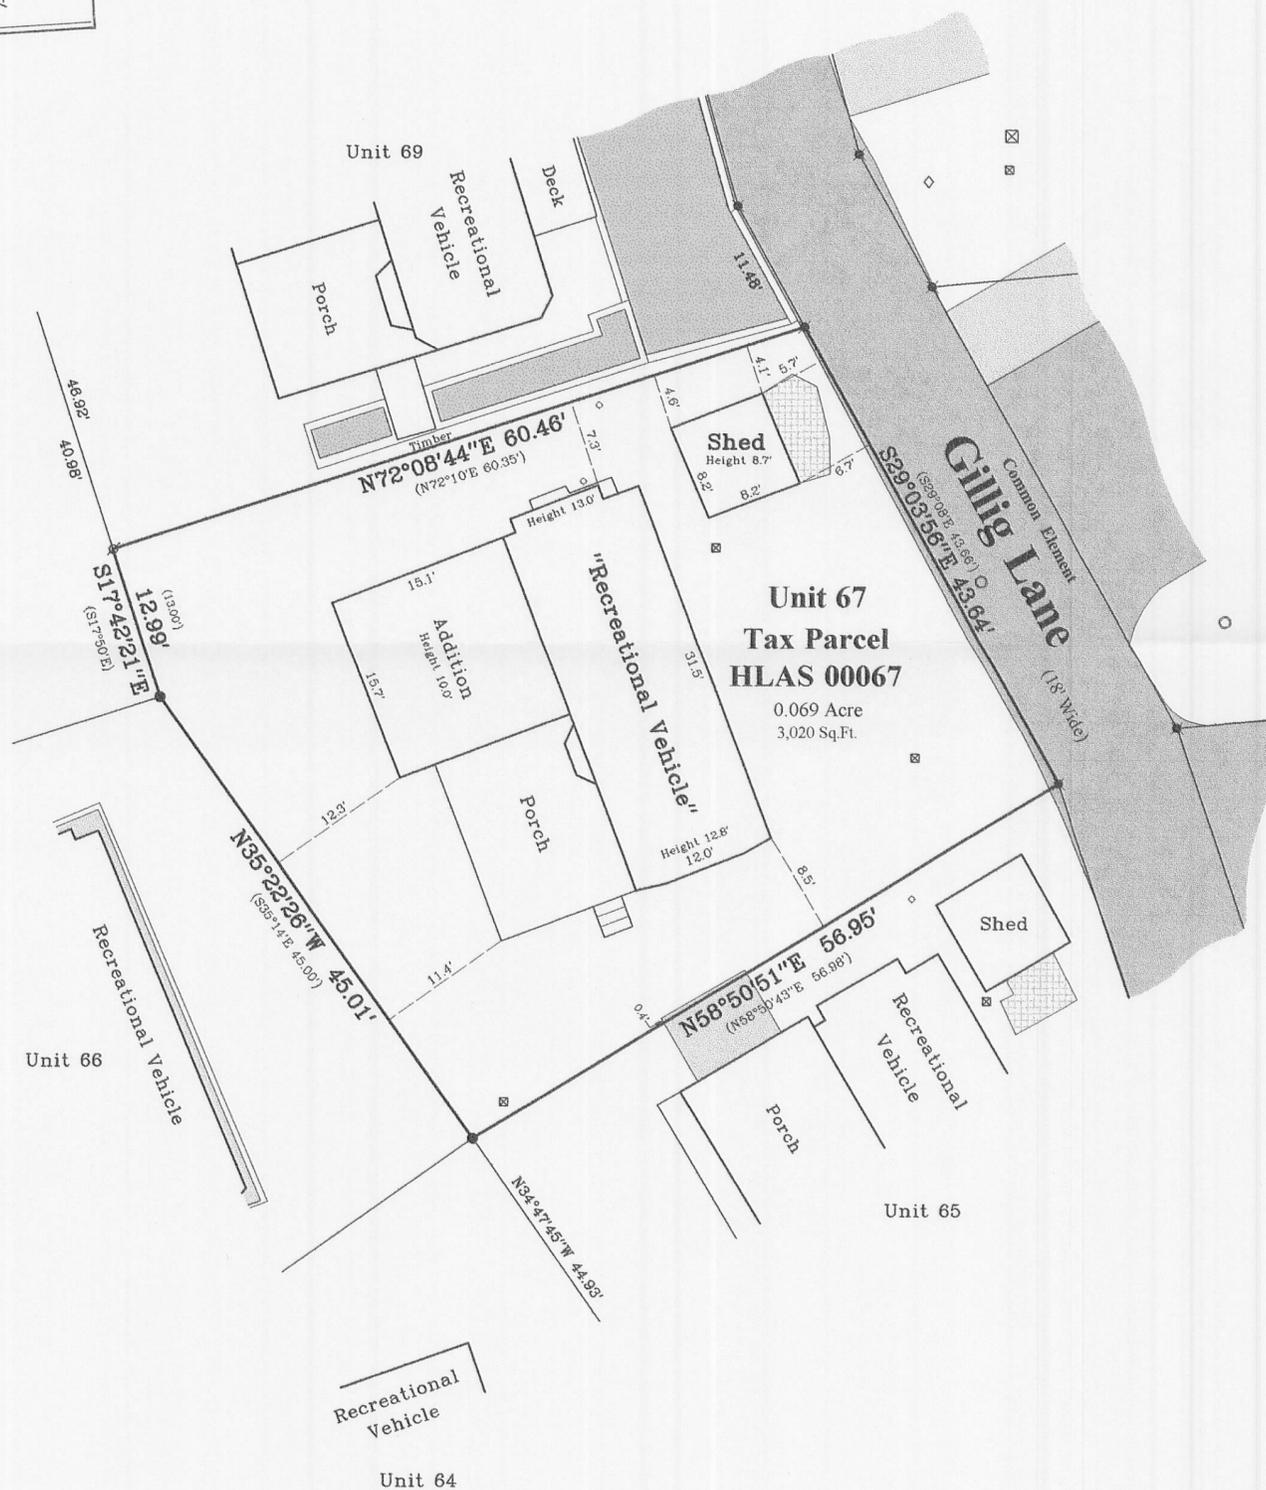

Survey Date: November 19, 2009.
Revisions:

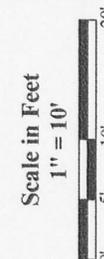

Jensen & Olson Land Surveying, LLC

45 South Wisconsin Street * P.O. Box 322 * Elkhorn, Wisconsin. 53121
Telephone: (262) 723-3434 * Facsimile: (262) 723-8044
Email: jensen.olson@elknet.net

Legend

- Found Iron Rod
- Settles
- Recorded Information
- Utility Box or Pedestal
- Asphalt Surface
- Concrete Surface
- Gravel Surface
- Pavers or Stone
- Water Spigot
- Manhole
- PVC Pipe

Sheet 1 of 1 Sheets
Drawing Name: Hlas-2009108-2009108(Plat.rls)

Job Reference Number
2009.108

2009.108

HLAS-67

416-3468