

FARRIS, HANSEN & ASSOCIATES, INC.

ENGINEERING — ARCHITECTURE — SURVEYING
7 RIDGWAY COURT — P.O. BOX 437 — ELKHORN, WISCONSIN 53121
PHONE: (262) 723-2098 FAX: (262) 723-5886



PLAT OF SURVEY

LOT 10 OF BUBBLING SPRINGS SUBDIVISION

LOCATED IN SECTION 34, TOWN 4 NORTH, RANGE 16 EAST,
WALWORTH COUNTY, WISCONSIN


— WORK ORDERED BY —
RICHARD NEUMANN
N7472 BAY DRIVE
ELKHORN, WI 53121

2010 PERMIT PLAT
ORDERED BY:
TOM DUVAL
W7793 HACKETT ROAD
WHITEWATER, WI. 53190

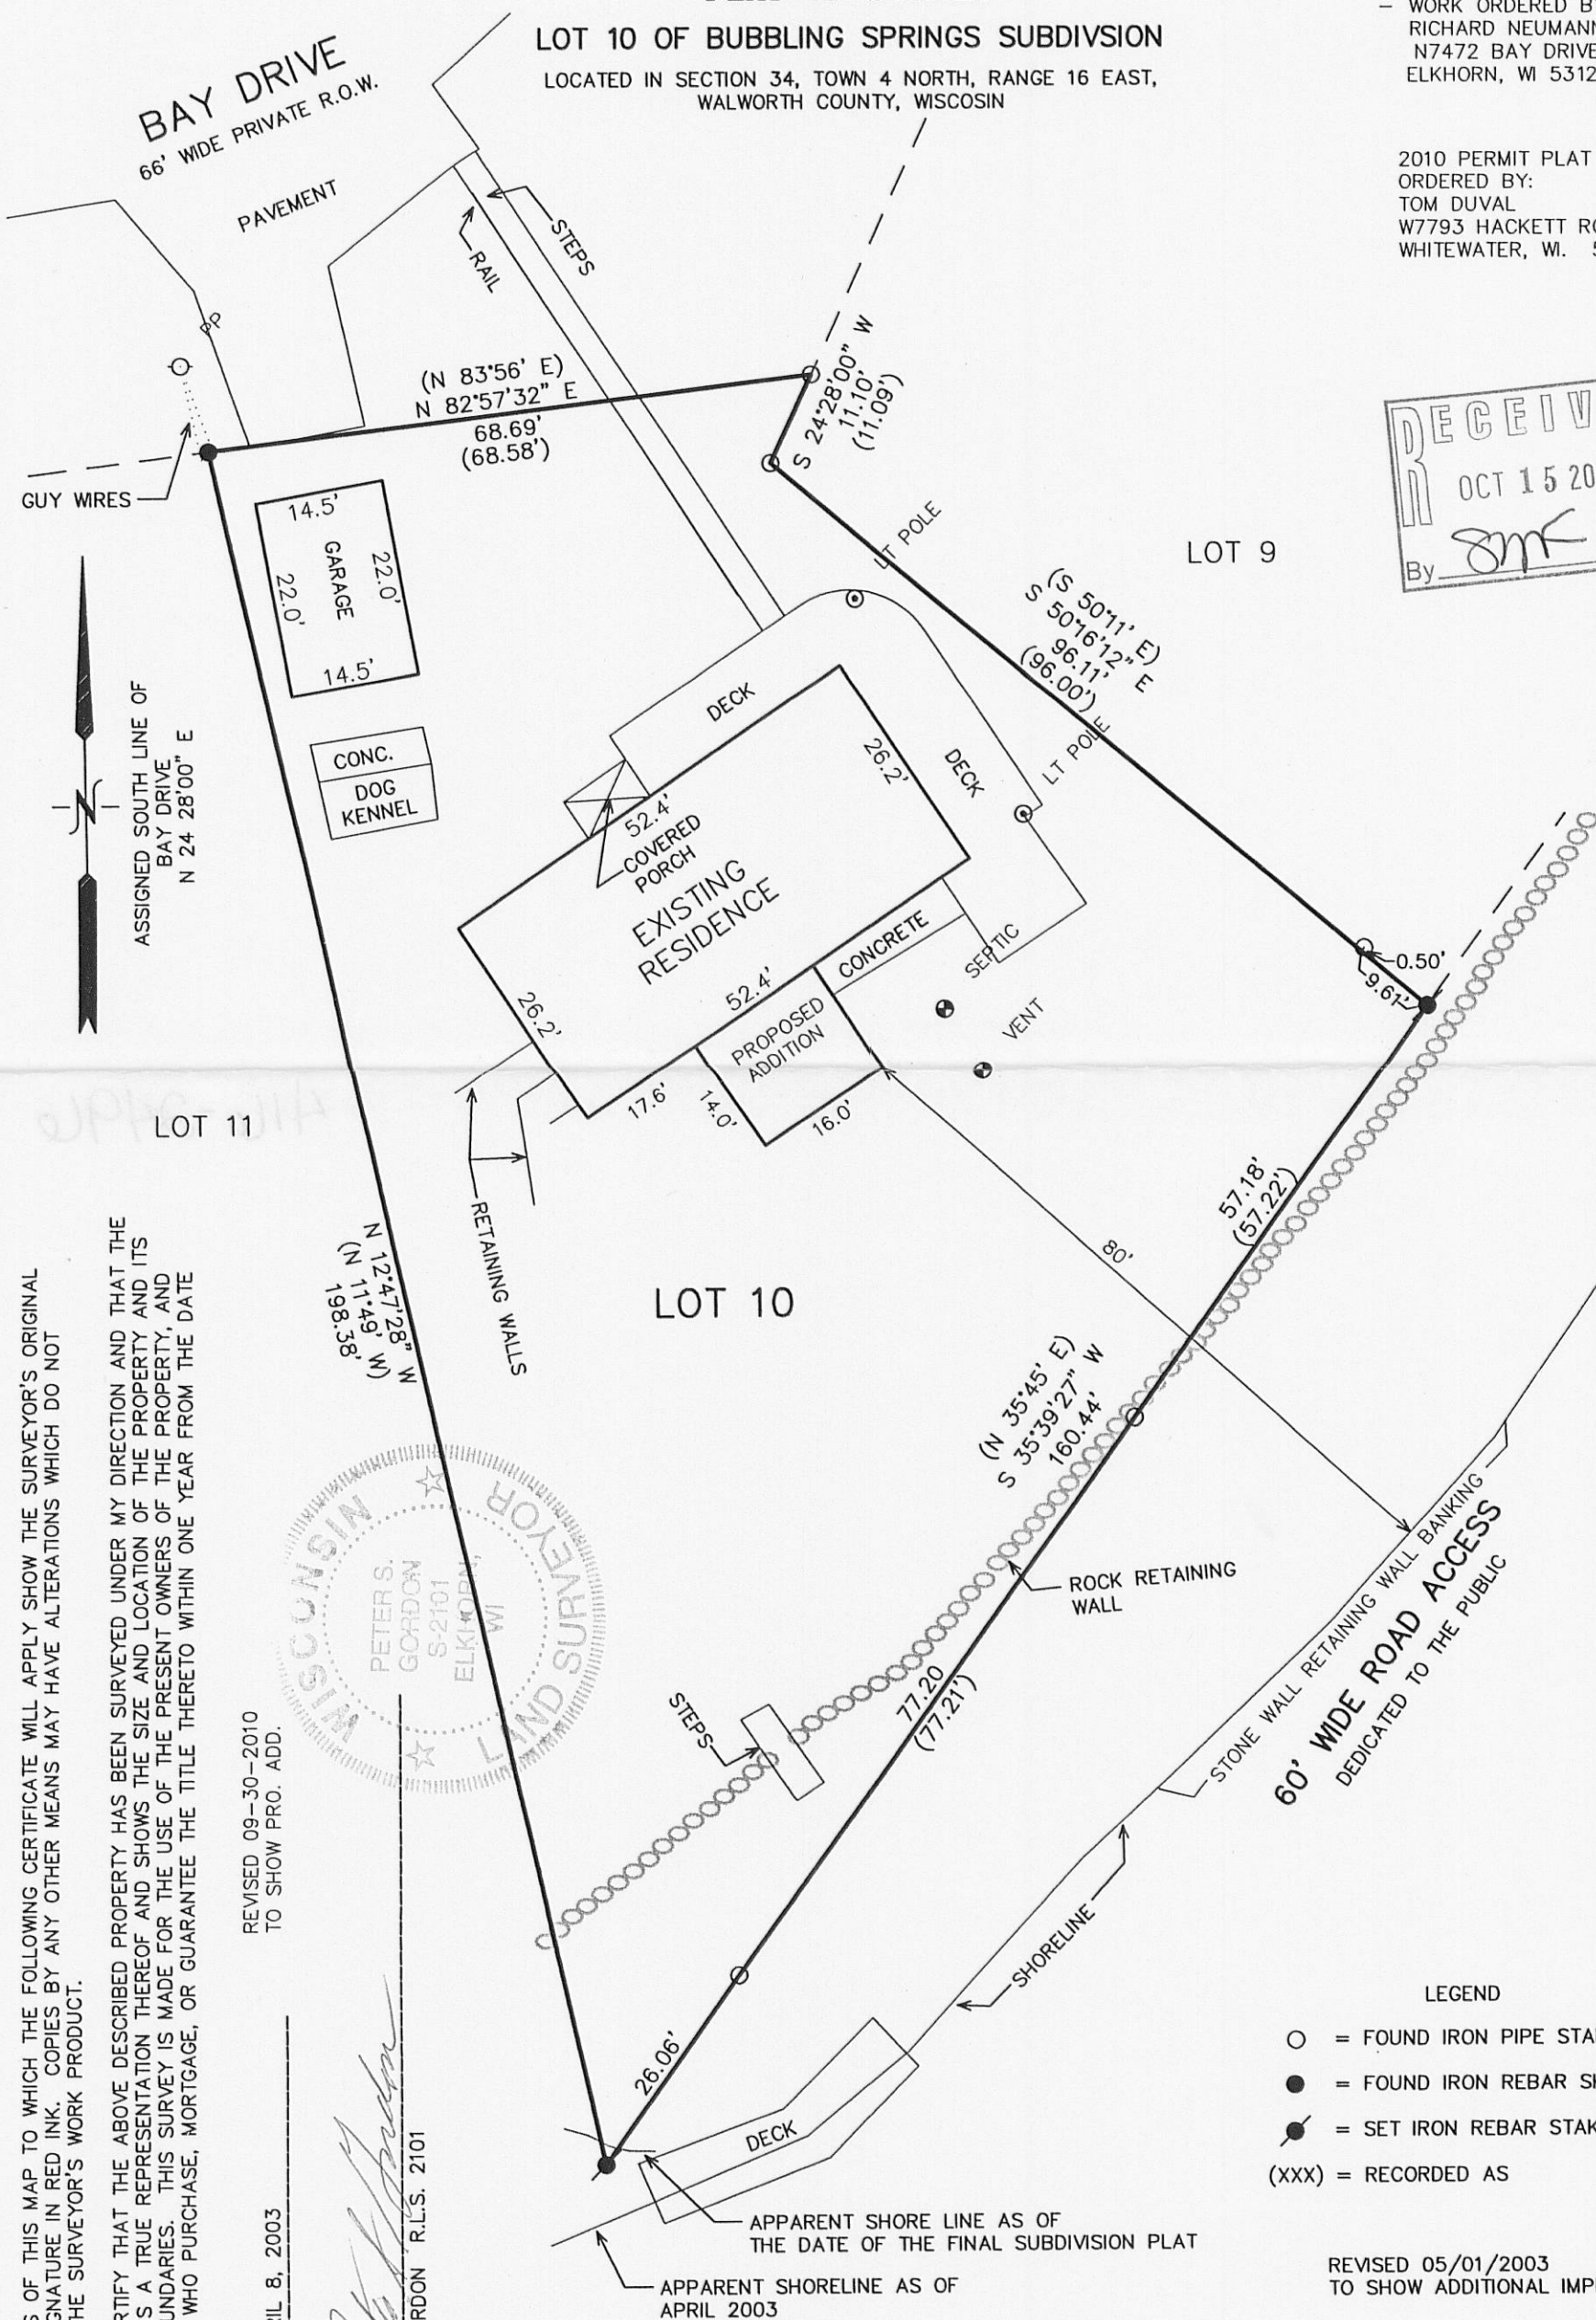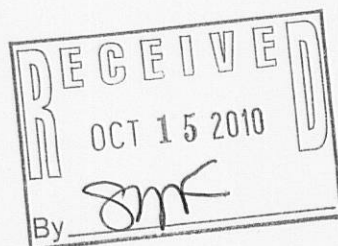

NOTE: COPIES OF THIS MAP TO WHICH THE FOLLOWING CERTIFICATE WILL APPLY SHOW THE SURVEYOR'S ORIGINAL SEAL AND SIGNATURE IN RED INK. COPIES BY ANY OTHER MEANS MAY HAVE ALTERATIONS WHICH DO NOT REPRESENT THE SURVEYOR'S WORK PRODUCT.

I HEREBY CERTIFY THAT THE ABOVE DESCRIBED PROPERTY HAS BEEN SURVEYED UNDER MY DIRECTION AND THAT THE ABOVE MAP IS A TRUE REPRESENTATION THEREOF AND SHOWS THE SIZE AND LOCATION OF THE PROPERTY AND ITS EXTERIOR BOUNDARIES. THIS SURVEY IS MADE FOR THE USE OF THE PRESENT OWNERS OF THE PROPERTY, AND ALSO THOSE WHO PURCHASE, MORTGAGE, OR GUARANTEE THE TITLE THERETO WITHIN ONE YEAR FROM THE DATE HEREOF.

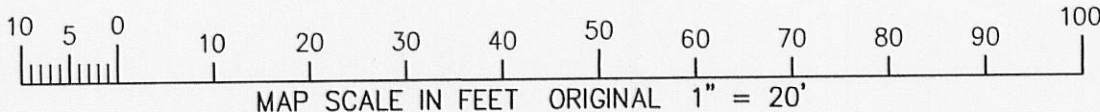

PROJECT: 5944
DATE: 04/08/03
SHEET 1 OF 1