


PLAT OF SURVEY & TOPOGRAPHIC MAPPING

LOT 4 OF CERTIFIED SURVEY MAP NO. 459

LOCATED IN THE SOUTHWEST 1/4 OF SECTION 36, TOWN 4
NORTH, RANGE 16 EAST, WALWORTH COUNTY, WISCONSIN

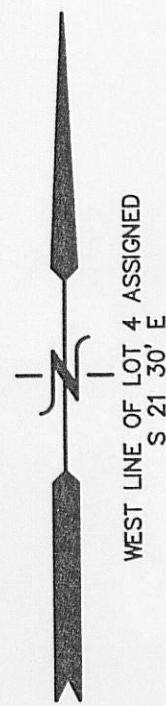


LEGEND
 ○ = FOUND IRON PIPE STAKE
 ● = SET IRON REBAR STAKE, 3/4" DIA.
 (XXX) = RECORDED AS

NOTE: COPIES OF THIS MAP TO WHICH THE FOLLOWING CERTIFICATE
 WILL APPLY SHOW THE SURVEYOR'S ORIGINAL SEAL AND SIGNATURE
 IN RED INK. COPIES BY ANY OTHER MEANS MAY HAVE ALTERATIONS
 WHICH DO NOT REPRESENT THE SURVEYOR'S WORK PRODUCT.

I HEREBY CERTIFY THAT THE ABOVE DESCRIBED PROPERTY HAS BEEN
 SURVEYED UNDER MY DIRECTION AND THAT THE ABOVE MAP IS A TRUE
 REPRESENTATION THEREOF AND SHOWS THE SIZE AND LOCATION OF
 THE PROPERTY AND ITS EXTERIOR BOUNDARIES. THIS SURVEY IS
 MADE FOR THE USE OF THE PRESENT OWNERS OF THE PROPERTY, AND
 ALSO THOSE WHO PURCHASE, MORTGAGE, OR GUARANTEE THE TITLE
 THERETO WITHIN ONE YEAR FROM THE DATE HEREOF.



DATED: 10-21-1999
 PETER S. GORDON R.L.S. 2101
 REVISED 12-07-2009
 TO SHOW PROPOSED
 GARAGE
 05-27-2010
 REVISED 09-03-2010
 TO SHOW AS BUILT
 BUILDINGS

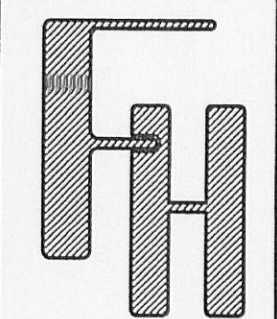

PLAT OF SURVEY
 TOPOGRAPHIC MAPPING

WORK ORDERED BY -
 ALBERT CHAMIS
 C/O DALE CZARNECKI
 W6774 BRICK CHURCH ROAD
 WALWORTH, WI. 53184

FARRIS, HANSEN & ASSOCIATES, INC.
 Engineering, Architecture, Surveying
 7 Ridgeway Court P.O. Box 437
 ELKHORN, WISCONSIN 53121
 Office: (414) 723-2098
 Fax: (414) 723-5886

REVISIONS

PROJECT NO.
 2170-0199
 DATE
 08/20/99
 SHEET NO.

