

LAND-MARK SURVEYING

Mark L. Miritz


Wisconsin Registered Land Surveyor S-2582

N9330 Knuteson Drive
Whitewater, WI 53190
Phone: (262) 495-3284
FAX : (262) 495-8421
LAND-MARKSURVEYING.COM



**ORDERED BY: CONNIE POGGENSEE
RAULAND AGENCY, INC.
118 KENOSHA STREET
WALWORTH, WI 53184**

PLAT OF SURVEY

**LOT 1, BLOCK 13, COOL HILL PARK
ADDITION NO. 2, LOCATED IN THE
SOUTHEAST 1/4 OF SECTION 34,
TOWN 4 NORTH, RANGE 16 EAST,
LAGRANGE TOWNSHIP, WALWORTH
COUNTY, WISCONSIN**

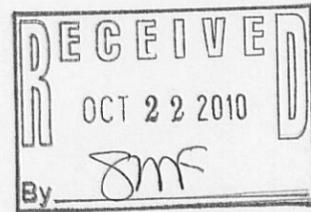

NINE INDIANS TRAIL
(66' WIDE)

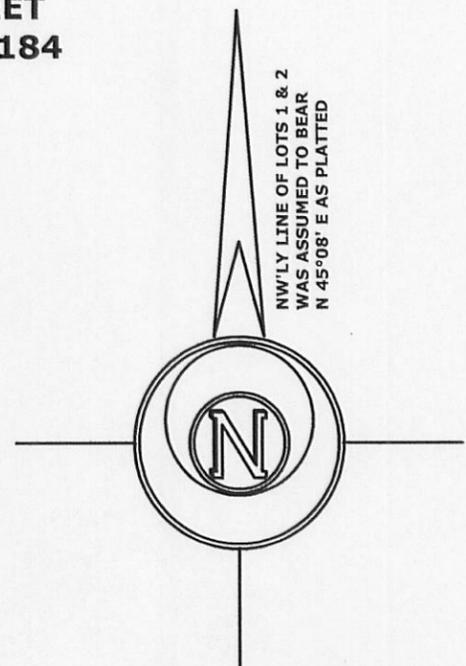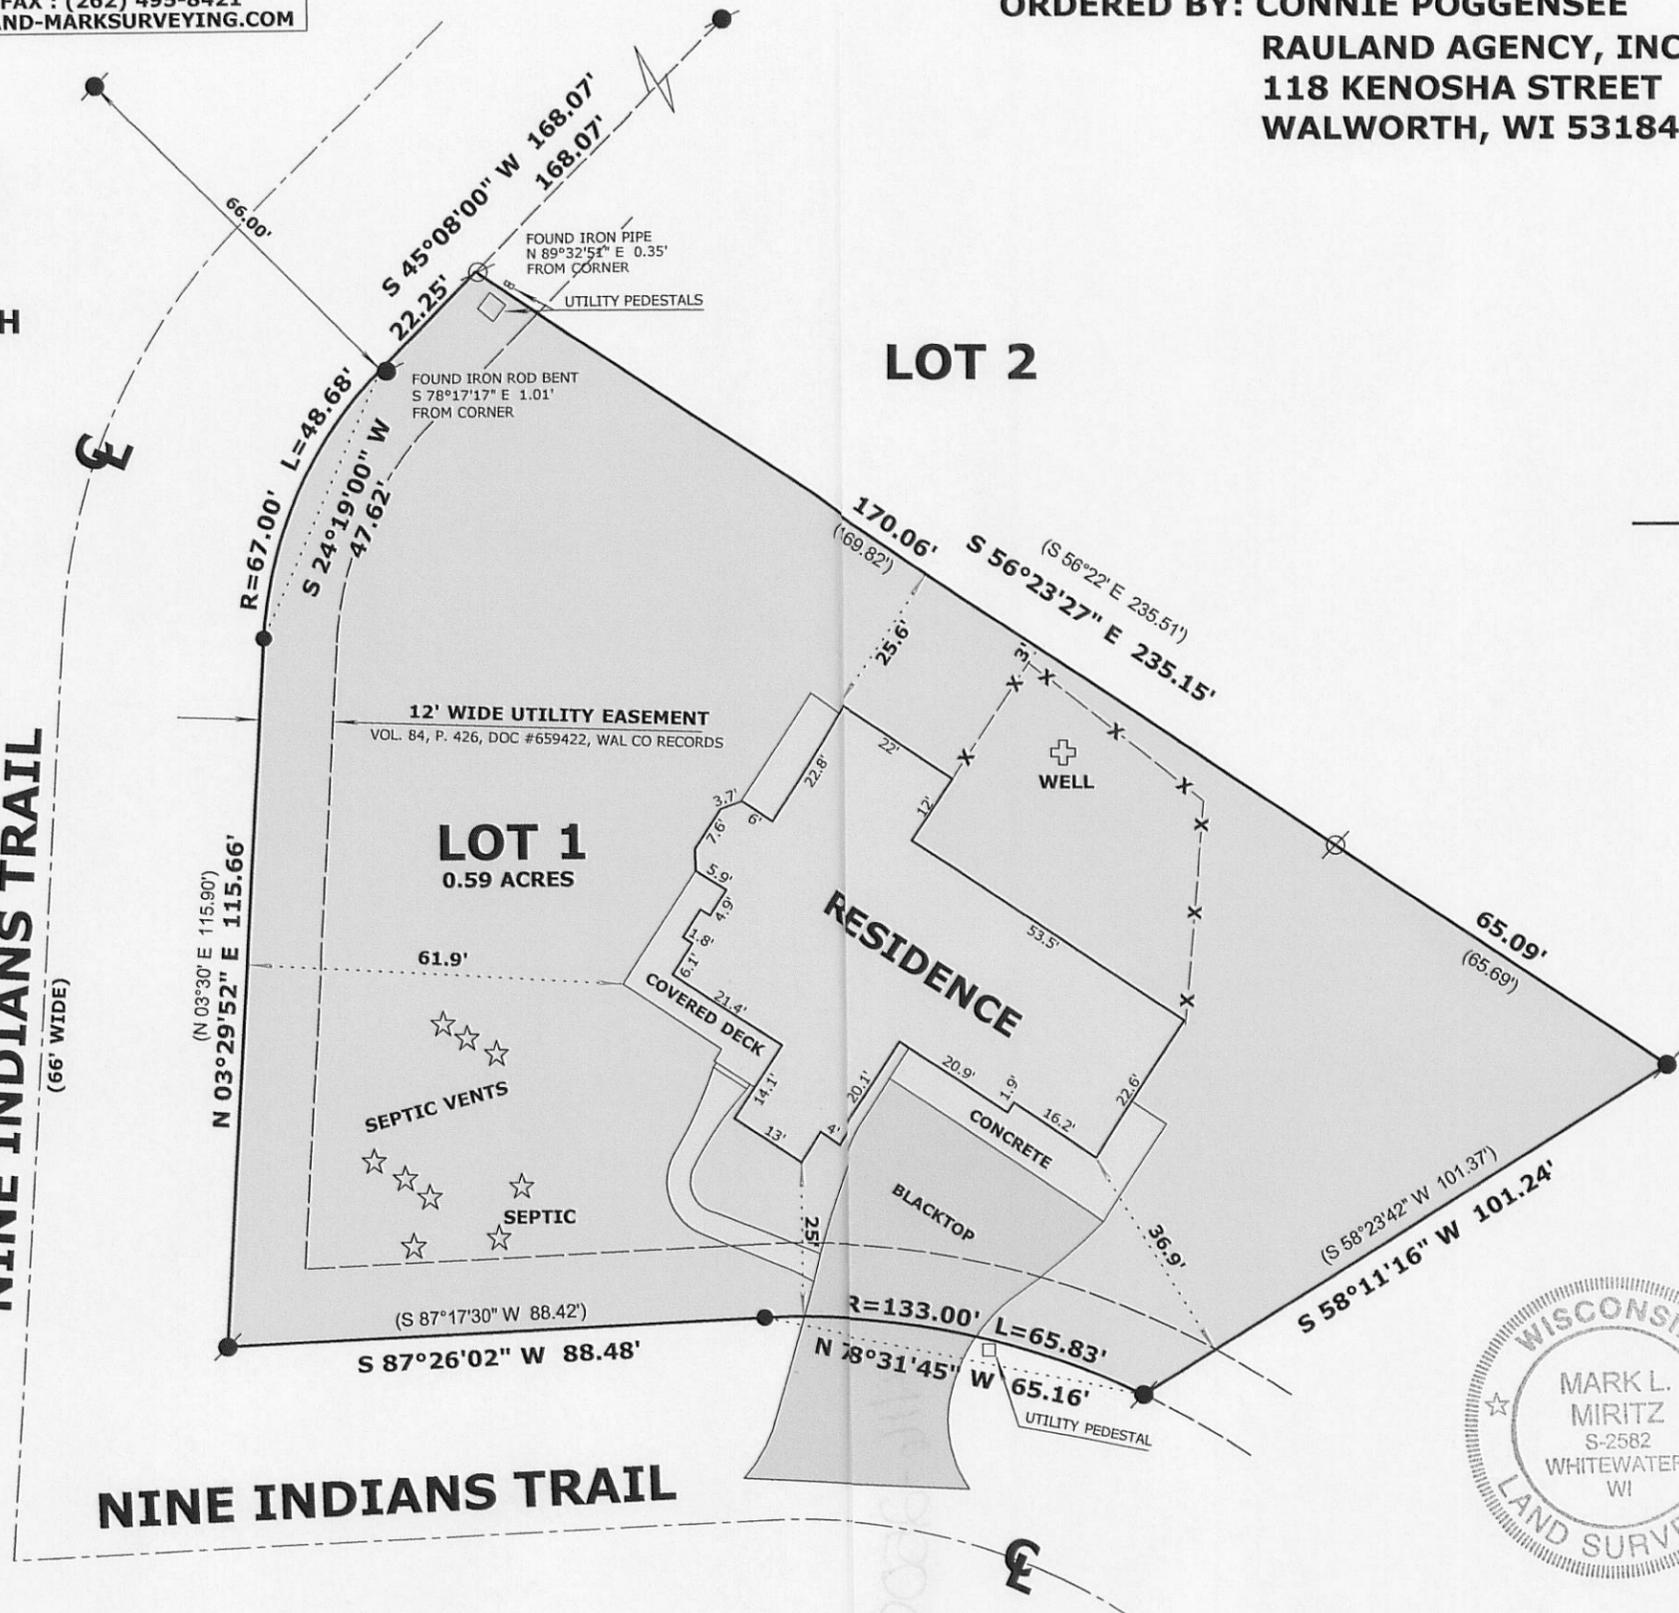

LEGEND

- FOUND 1 1/4" IRON PIPE
- FOUND 1 3/16" IRON ROD
- SET IRON PIPE, 18" LONG, WEIGHING 1.5 LBS./LINEAL FT., 1 1/4" DIA.
- RECORDED AS DIMENSION
- EXISTING WOOD FENCE

SCALE: 1 INCH = 30 FEET

"I hereby certify that the above described property has been surveyed by me or under my direction and that the above map is a true representation thereof and shows the size and location of the property, its exterior boundaries, the location of all visible structures and dimensions of all principal buildings thereon, boundary fences, apparent easements, roadways and visible encroachments, if any."
"This survey is made for the use of the present owners of the property, and also those who purchase, mortgage, or guarantee the title thereto within one year from date hereof."



Mark L. Miritz
MARK L. MIRITZ
WISCONSIN REGISTERED
LAND SURVEYOR S-2582

DATE: OCT. 21, 2010 JOB NO. 10.1003