


PLAT OF SURVEY
LOT 10 EXCLUDING THE WESTERLY 10' THEREOF
AND THE WESTERLY 35' OF LOT 11
1st ADDITION TO LAUDERDALE PARK
LOCATED IN SECTION 25, TOWN 4 NORTH, RANGE 16 EAST,
WALWORTH COUNTY, WISCONSIN

3. The land referred to in the Commitment is described as follows:
LOT 10, excepting the West 10 feet thereof and the West 35 feet of Lot 11, all in
First Addition of Lauderdale Park, Town of LaGrange, County of Walworth, State of
Wisconsin.
Tax Key No: HLP 00003

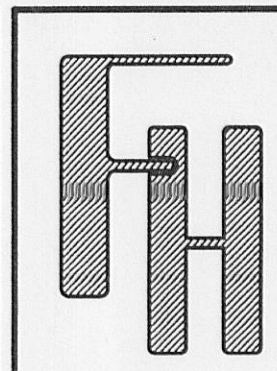

PLAT OF SURVEY

WORK ORDERED BY -
LARRY VOLSTEIN
531 LONG HILL ROAD
GURNEE, IL 60031

FARRIS, HANSEN & ASSOCIATES, INC.
Engineering, Architecture, Surveying
7 Ridgway Court P.O. Box 437
ELKHORN, WISCONSIN 53121
Office: (414) 723-2098
Fax: (414) 723-5856

REVISIONS	
PROJECT NO.	5020
DATE	06/01/98
SHEET NO.	1 OF 1



LEGEND
O = FOUND IRON PIPE STAKE
X = FOUND CHISLED "X" IN CONCRETE
(XXX) = RECORDED AS

MAP SCALE IN FEET ORIGINAL 1" = 10'

RECEIVED
APR 29 2011
By [Signature]

NOTE: DOCUMENTS RECORDED AS 333414, 495076, AND 561369 ALLOW FOR ACCESS OVER THE ROADWAY AS EXISTS TO HIGHWAY 12, BEING 1 ROD WIDE.

NOTE: COPIES OF THIS MAP TO WHICH THE FOLLOWING CERTIFICATE WILL APPLY SHOW SURVEYOR'S ORIGINAL SEAL AND SIGNATURE IN RED INK. COPIES BY ANY OTHER MEANS MAY HAVE ALTERATIONS WHICH DO NOT REPRESENT THE SURVEYOR'S WORK PRODUCT.

I HEREBY CERTIFY THAT THE ABOVE DESCRIBED PROPERTY HAS BEEN SURVEYED UNDER MY DIRECTION AND THAT THE ABOVE MAP IS A TRUE REPRESENTATION THEREOF AND SHOWS THE SIZE AND LOCATION OF THE PROPERTY, ITS EXTERIOR BOUNDARIES, THE LOCATION OF ALL VISIBLE STRUCTURES, AND DIMENSIONS OF ALL PRINCIPLE BUILDINGS THEREON, BOUNDARY FENCES, APPARENT EASEMENTS, ROADWAYS, AND VISIBLE ENCROACHMENTS, IF ANY. THIS SURVEY IS MADE FOR THE USE OF THE PRESENT OWNERS OF THE PROPERTY, AND ALSO THOSE WHO PURCHASE, MORTGAGE, OR GUARANTEE THE TITLE THERETO WITHIN ONE YEAR FROM THE DATE HEREOF.

DATED: MARCH 9, 2011
[Signature]
PETER S. GORDON R.L.S. 2101

