

Mill

Lake

Plat of Survey

of


Lot 1 of Certified Survey Map No. 4379,

recorded in Vol. 28 of Certified Survey Maps of Walworth County on Page 203 and located in the Northwest 1/4 of Section 36, Town 4 North, Range 16 East, Town of LaGrange, Walworth County, Wisconsin.

Surveyed for: **Sandra Hamilton**
21727 Sound Way #101
Estero, Florida, 33928


No. 6 - Changed shoreline setback, topo added & house staked
No. 7 - Building Setback
No. 8 - Concrete Foundation

Survey Date: July 13, 2011.
Revisions: No. 1 - Proposed Lot Line
No. 2 - Adjustments to Proposed Lot Line
No. 3 - Building Setback Lines
No. 4 - Proposed Addition
No. 5 - CSM recording info
--- Continued above ---

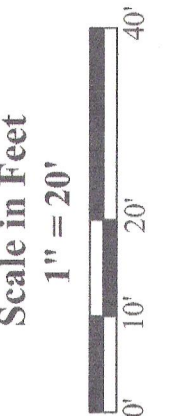

North 1/4 Corner
Section 36-4-16.
N. 284.423.24
E. 2,386,292.64

Center 1/4 Corner
Section 36-4-16.
N. 281,787.39
E. 2,386,358.92

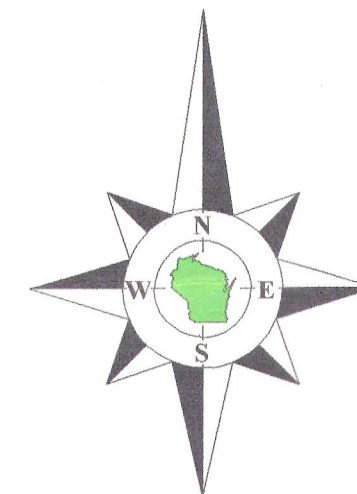

Bearings reference to the Wisconsin State Plane Coordinate System, South Zone.

Elevations on this survey are referenced to a recorded elevation of 886.959 on Benchmark FX-P-9, a chiselled + on the Southwest wingwall of the Honey Creek dam. This elevation is referenced to the National Geodetic Vertical Datum of 1929 (NGVD29).

The flood elevation information shown on this survey is referenced to Flood Insurance Rate Map (FIRM) No. 55127C0065D and the Flood Insurance Study (FIS) report dated October 2, 2009 prepared by the Federal Emergency Management Agency (FEMA). These publications were prepared using the North American Vertical Datum of 1988 (NAVD88). Page 18 of the Flood Insurance Study gives the following conversion factor for Walworth County, NAVD88 + 0.2 feet = NGVD29.


A 100 year flood elevation of 886.2 NGVD29 was used on this survey based upon an elevation of 886 NAVD88 on the above mentioned FIRM and FIS.

Copyright 2011 by Jensen & Olson Land Surveying, LLC.

All rights reserved. No part of this survey plat may be reproduced or transmitted in any form by any means - graphic, electronic, or mechanical, including photocopying, tracing, or information storage and retrieval systems - without permission in writing from Douglas G. Olson, Jensen & Olson Land Surveying, LLC.

I, Douglas G. Olson, Wisconsin Registered Land Surveyor, do hereby certify that this survey was performed by me, or under my direction in full compliance with the owner's/agent's instructions and Chapter A-E 7 of the Wisconsin Administrative Code "Minimum Standards for Property Surveys"; and that this map is an accurate representation thereof to the best of my knowledge and belief.

Douglas G. Olson
Wisconsin Registered Land Surveyor - 2093

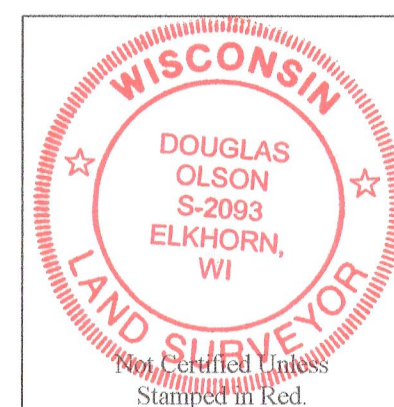

Notes:

- 1) This survey plat is not certified unless signed and sealed in red ink.
- 2) This survey is subject to Wisconsin lien laws. This Plat of Survey is the notice of intent to file lien. Lien waiver required.

Water Elevation on
October 24, 2011.
884.6

Lot 1
0.318 Acre
13,860 Sq.Ft.

House
N7511

Poured
Concrete
Foundation

Country Club Drive
(Orchard Street)

Benchmark
Railroad spike
in pavement
Elevation=906.23.

Boathouse

Shed

Quit Claim Deed Recorded
August 22, 2011 as
Document No. 820546.


Quit Claim Deed Recorded
August 22, 2011 as
Document No. 820547.

Lot 6

Tax Parcel
HRP 00004

Lot 5

House

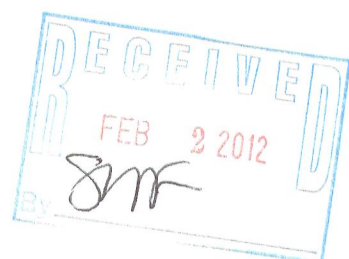

HA4379-1

416-2571

Jensen & Olson Land Surveying, LLC

45 South Wisconsin Street * P.O. Box 322 * Elkhorn, Wisconsin, 53121
Telephone: (262) 723-3434 * Facsimile: (262) 723-8044
Email: jensen.olson@elknet.net

Legend
Found County Section Corner
Found Iron Pipe
Found Iron Rod
Found Stake
Recorded Information
Recorded Pole
Concrete Cover
Septic Vent
Asphalt Surface
Concrete Surface
Gravel
Set Wood Stake
Drain
Lamp

Sheet 1 of 1 Sheets

Job Reference Number

2011.063

2011.063