

Plat of Survey

of

Lot 2 of Certified Survey Map No. 672,

recorded in Vol. 3 of Certified Survey Maps of Walworth County on Page 160 and located in the Northeast 1/4 of Section 36, Town 4 North, Range 16 East, Town of LaGrange, Walworth County, Wisconsin.

Surveyed for: **Coldwell Banker, Leith & Associates**


102 North Wisconsin Street
Elkhorn, Wisconsin. 53121

Tax Parcel
HLG 3600001

Lot 2
Tax Parcel
HA 67200002

5.377 Acres
234,236 Sq.Ft.
5.072 Acres
220,947 Sq.Ft.
Exclusive of R.O.W.

Lot 3
C.S.M. 672

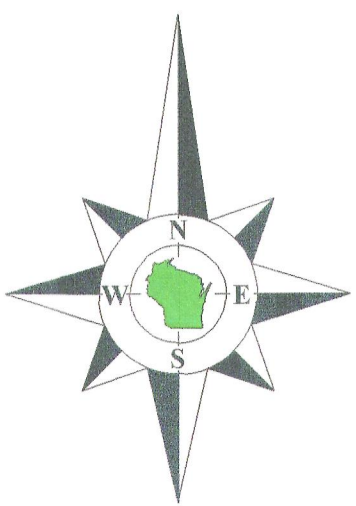

Bearings reference to Certified Survey Map No. 672..

Lot 1
C.S.M. 672

Riding Area

Barn

House

W4980

Well

Building Setback Line
As shown on C.S.M. 672.
(133' from centerline of road)

Pleasant Lake Road

S89°41'05"W 399.94'

(66' Wide)

Copyright 2011 by Jensen & Olson Land Surveying, LLC.


All rights reserved. No part of this survey plat may be reproduced or transmitted in any form by any means - graphic, electronic, or mechanical, including photocopying, tracing, or information storage and retrieval systems - without permission in writing from Douglas G. Olson, Jensen & Olson Land Surveying, LLC.

I hereby certify that I have surveyed the above described property and the map hereon is correct to the best of my professional knowledge and belief and shows the size and location of the property, its exterior boundaries, the location and dimensions of all visible structures thereon, boundary fences, apparent easements and roadways and visible encroachments, if any.

This survey is made for the exclusive use of the present owners of the property, and also those who purchase, mortgage or guarantee title thereto, within one year from the date hereof.

Douglas G. Olson
Wisconsin Registered Land Surveyor - 2093

- Notes:**
- 1) This survey plat is not certified unless signed and sealed in red ink.
 - 2) This survey is subject to Wisconsin lien laws. This Plat of Survey is the notice of intent to file lien. Lien waiver required.

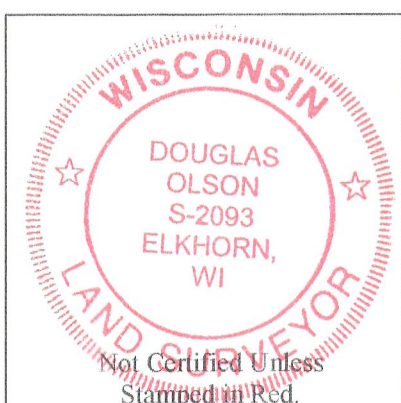

2011.085

Sheet 1 of 1 Sheets

Drawing Name: 4hr16e-2011085-2011085Plat.scd

Job Reference Number

2011.085

Legend

- Found County Section Corner
- Found Concrete Monument
- Found Iron Pipe
- Recorded Information
- Utility Pole
- Concrete Cover
- Asphalt Surface
- Concrete Surface
- Pedestal
- Vent
- Patio Block
- Sand



Jensen & Olson Land Surveying, LLC

45 South Wisconsin Street * P.O. Box 322 * Elkhorn, Wisconsin. 53121

Telephone: (262) 723-3434 * Facsimile: (262) 723-8044

Email: jensen.olson@elknet.net

Scale in Feet

1" = 40'



Survey Date: August 15, 2011.

Revisions:

HA672-2

416-2576