


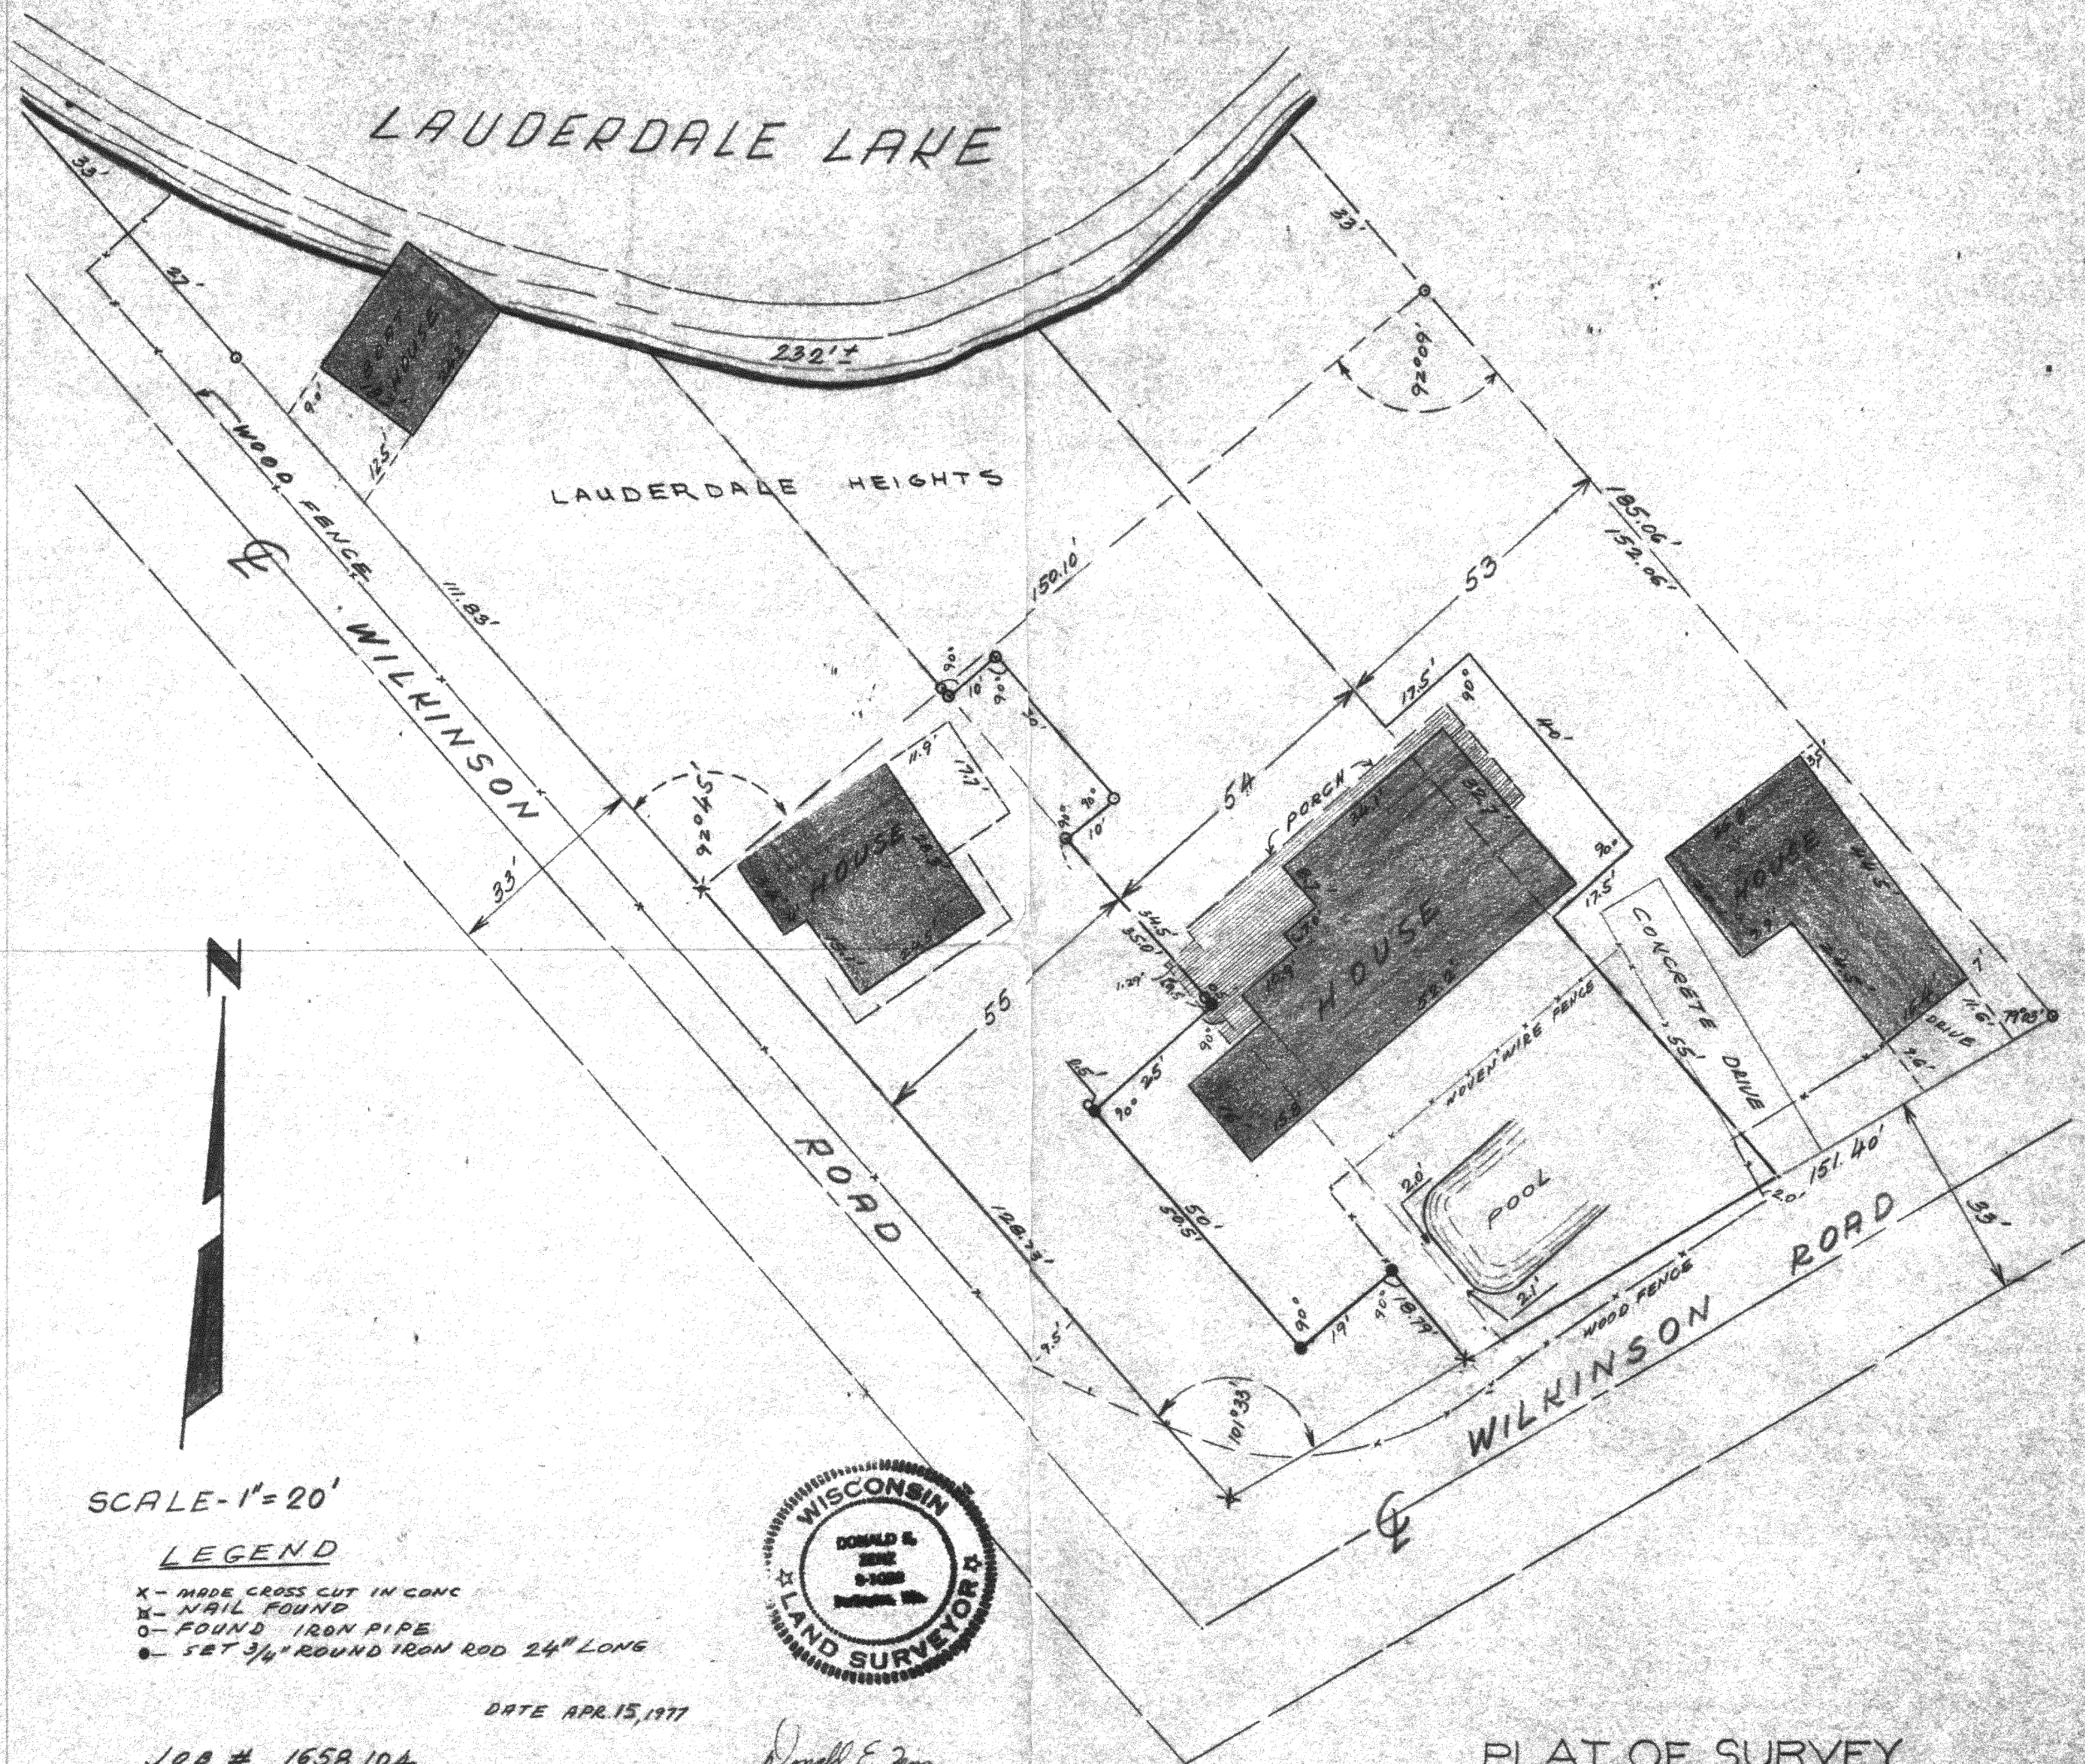

SCALE - 1" = 20'

LEGEND

- X - MADE CROSS CUT IN CONC
- X - NAIL FOUND
- O - FOUND IRON PIPE
- - SET 3/4" ROUND IRON ROD 24" LONG

DATE APR. 15, 1977

JOB # 1658.104
 SURVEY FOR LOUIS HILFER
 107 YORK ROAD
 GLENVIEW, IL 60025

Donald E. Lenz
 DONALD E. LENZ 5-1088

LOT LINE ADJUSTMENT AS RECORDED
 IN DOCUMENT NOS 02845, 669307, 669602
 AND 680798 AT WALWORTH COUNTY COURT HOUSE

PLAT OF SURVEY
 OF

LOT LINE ADJUSTMENT BETWEEN
 LOT 54 & 55 LAUDERDALE HEIGHTS,
 T4N - R16E WALWORTH COUNTY,
 WISCONSIN

LAUDERDALE LAKE

LAUDERDALE HEIGHTS

WOOD FENCE
WILKINSON

ROAD

WILKINSON


ROAD

THE PROPERTY HEREON DESCRIBED
HAS BEEN SURVEYED UNDER MY DIRECTION
AND THE PLAT SHOWN HEREON IS A TRUE
REPRESENTATION THEREOF AND SHOWS THE
SIZE AND LOCATION OF THE PROPERTY TO
THE BEST OF MY KNOWLEDGE AND BELIEF

SCALE - 1" = 20'

LEGEND

- X - MADE CROSS CUT IN CONC
- ✕ - NAIL FOUND
- - FOUND IRON PIPE
- - SET 3/4" ROUND IRON ROD 24" LONG

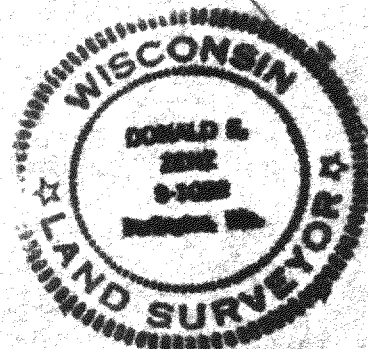

DATE APR. 15, 1977
REVISED 5/27/77

JOB # 1658.104
SURVEY FOR LOUIS HILFER
707 YORK ROAD
GLENVIEW, IL. 60025

Donald E. Zenz
DONALD E. ZENZ 5-1088

LOT LINE ADJUSTMENT AS RECORDED
IN DOCUMENT NOS 02345, 669307, 669002
AND 680798 AT WALWORTH COUNTY COURT HOUSE


Put on both lots

PLAT OF SURVEY OF

LOT LINE ADJUSTMENT BETWEEN
LOT 54 & 55 LAUDERDALE HEIGHTS,
T4N - R16E WALWORTH COUNTY,
WISCONSIN

416-259

1658.104

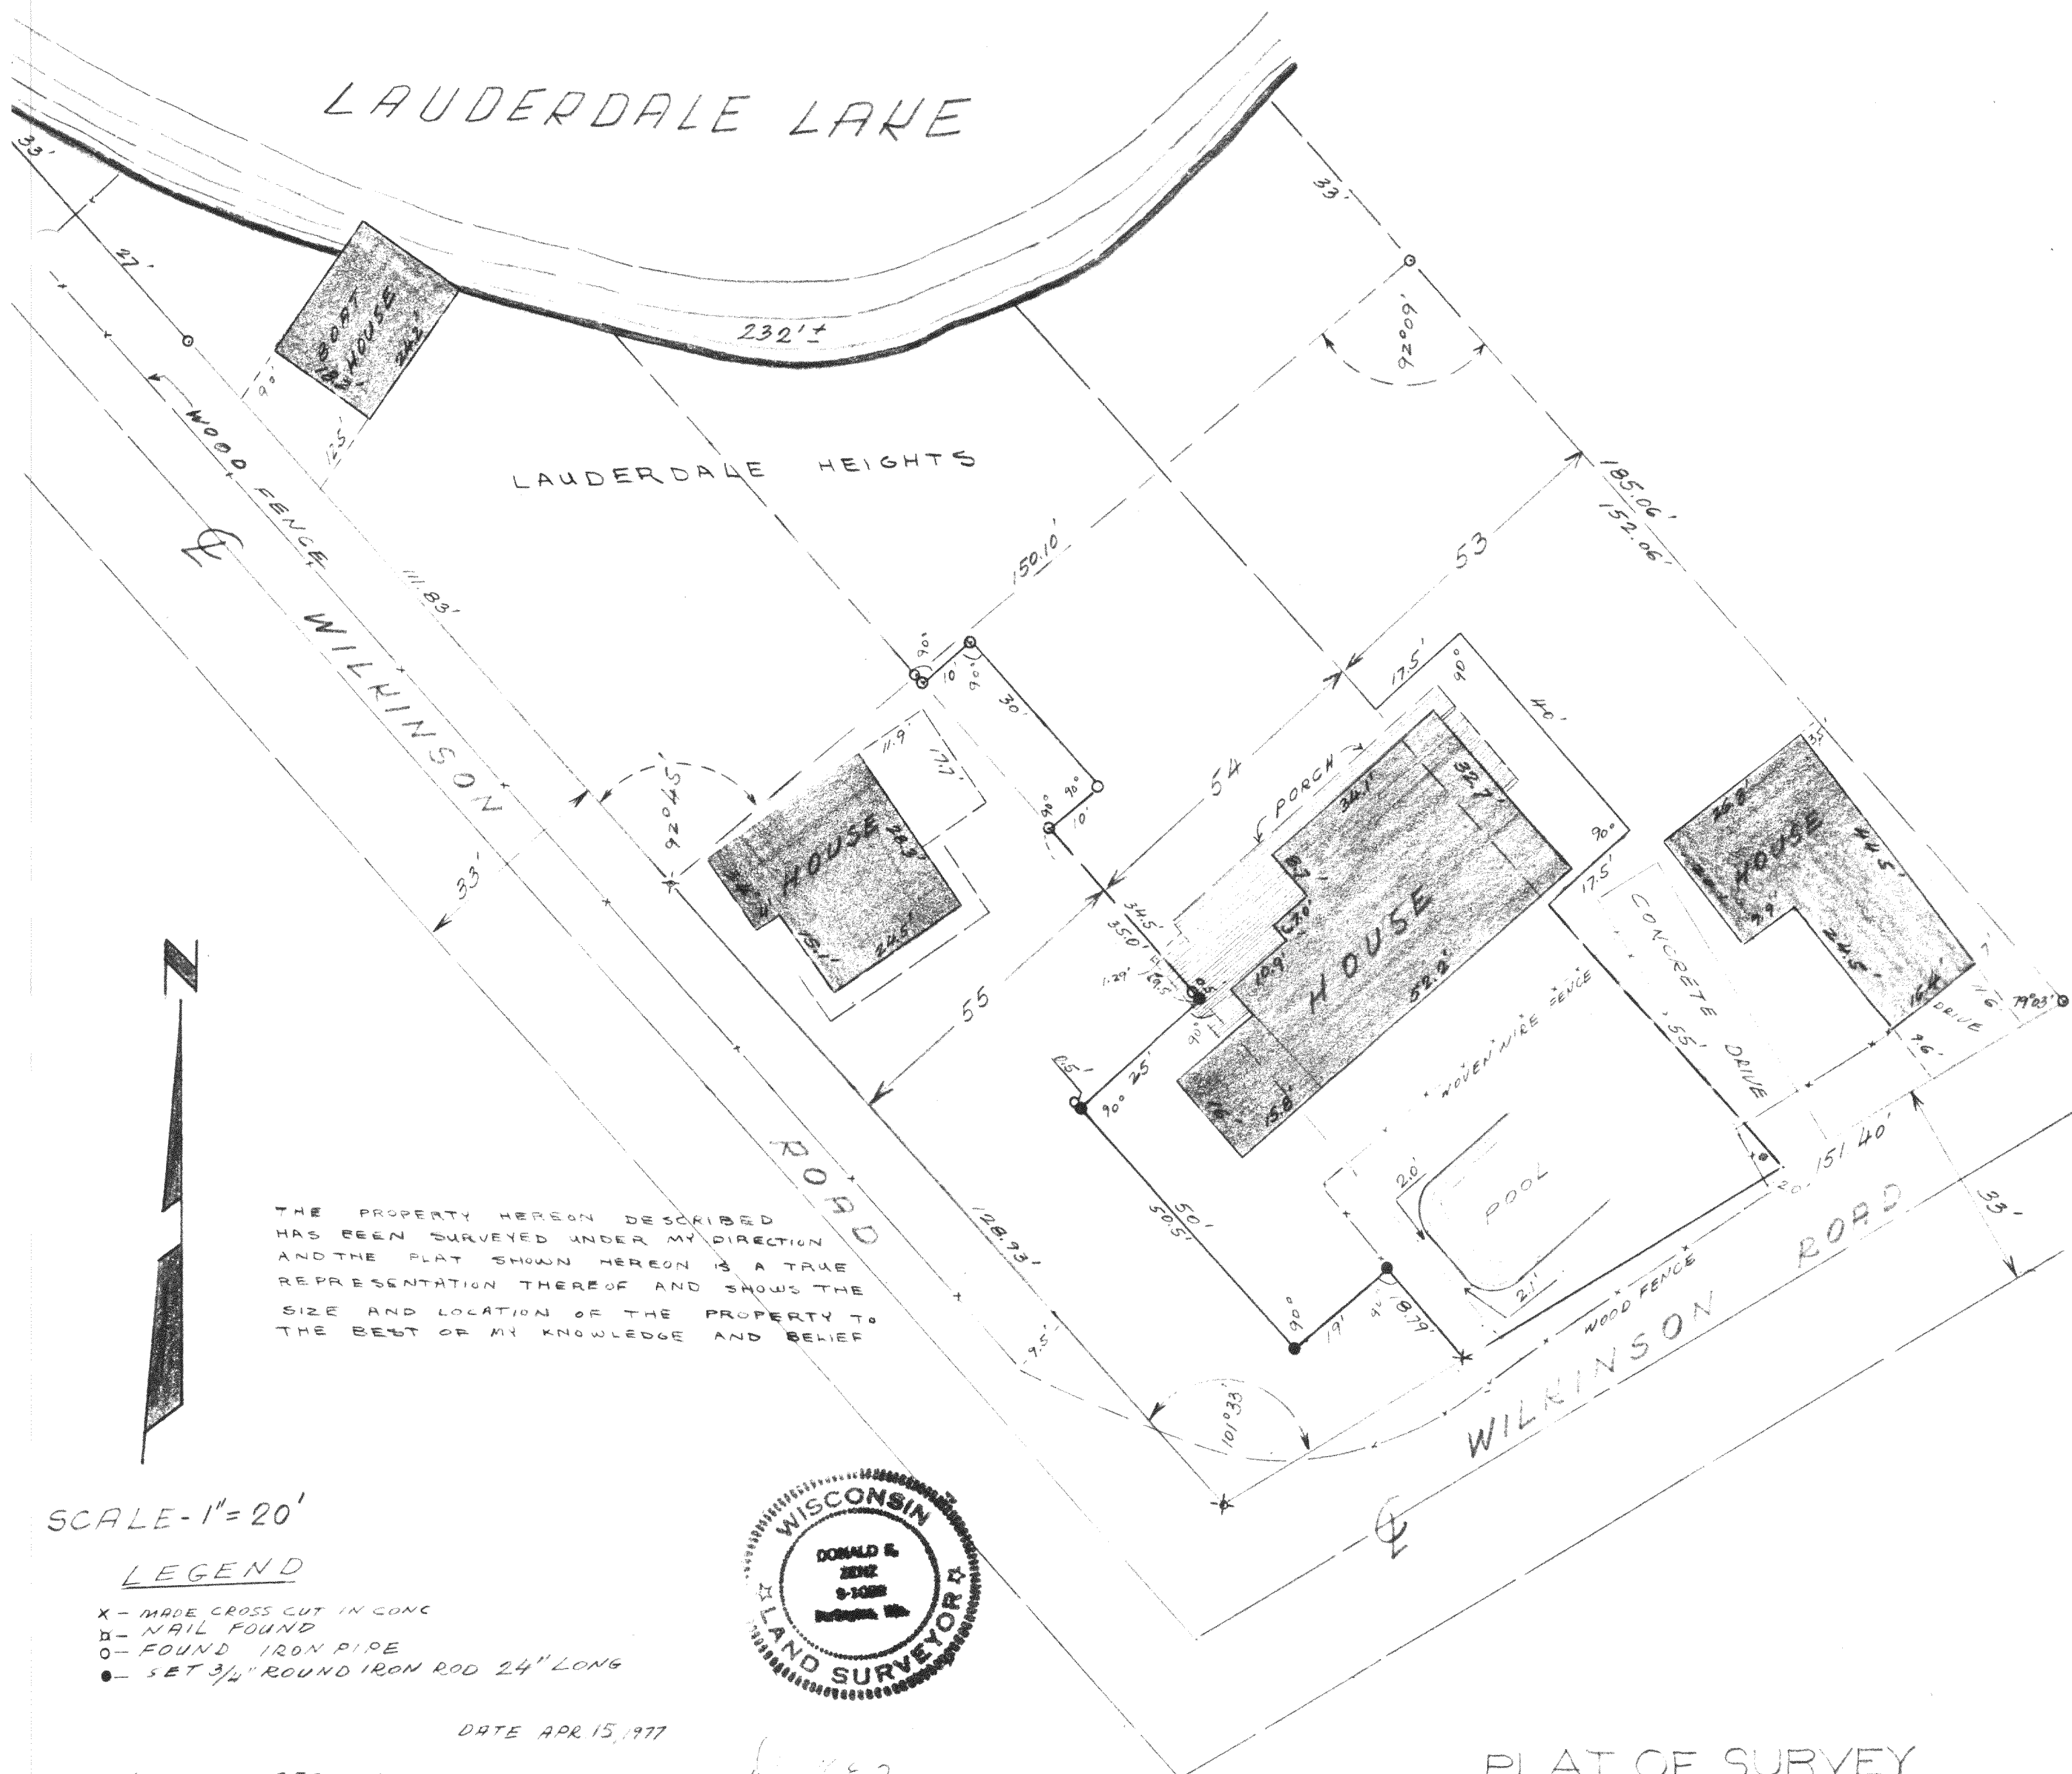

416-259

1658.104