



PLAT OF SURVEY OF

Part of Lot 18 as designated upon the plat of Morris Park in Section 26, T4N, R16E, LaGrange Township, Walworth County, Wisconsin, described as follows: Beginning at an iron pipe monument found at the S.W. corner of said Lot 18; thence N 28° 56' E along the easterly line of West Line Road, 59.89 feet to an iron rod monument; thence S 64° 13' E, 196.74 feet to an iron rod monument set on a meander line; thence S 25° 13' W along said meander line, 50.97 feet to an iron pipe monument found on the southerly line of said Lot 18; thence N 66° 45' W along the southerly line of said Lot 18, 202.70 feet to the place of beginning, including all land lying between said meander line and Green Lake.

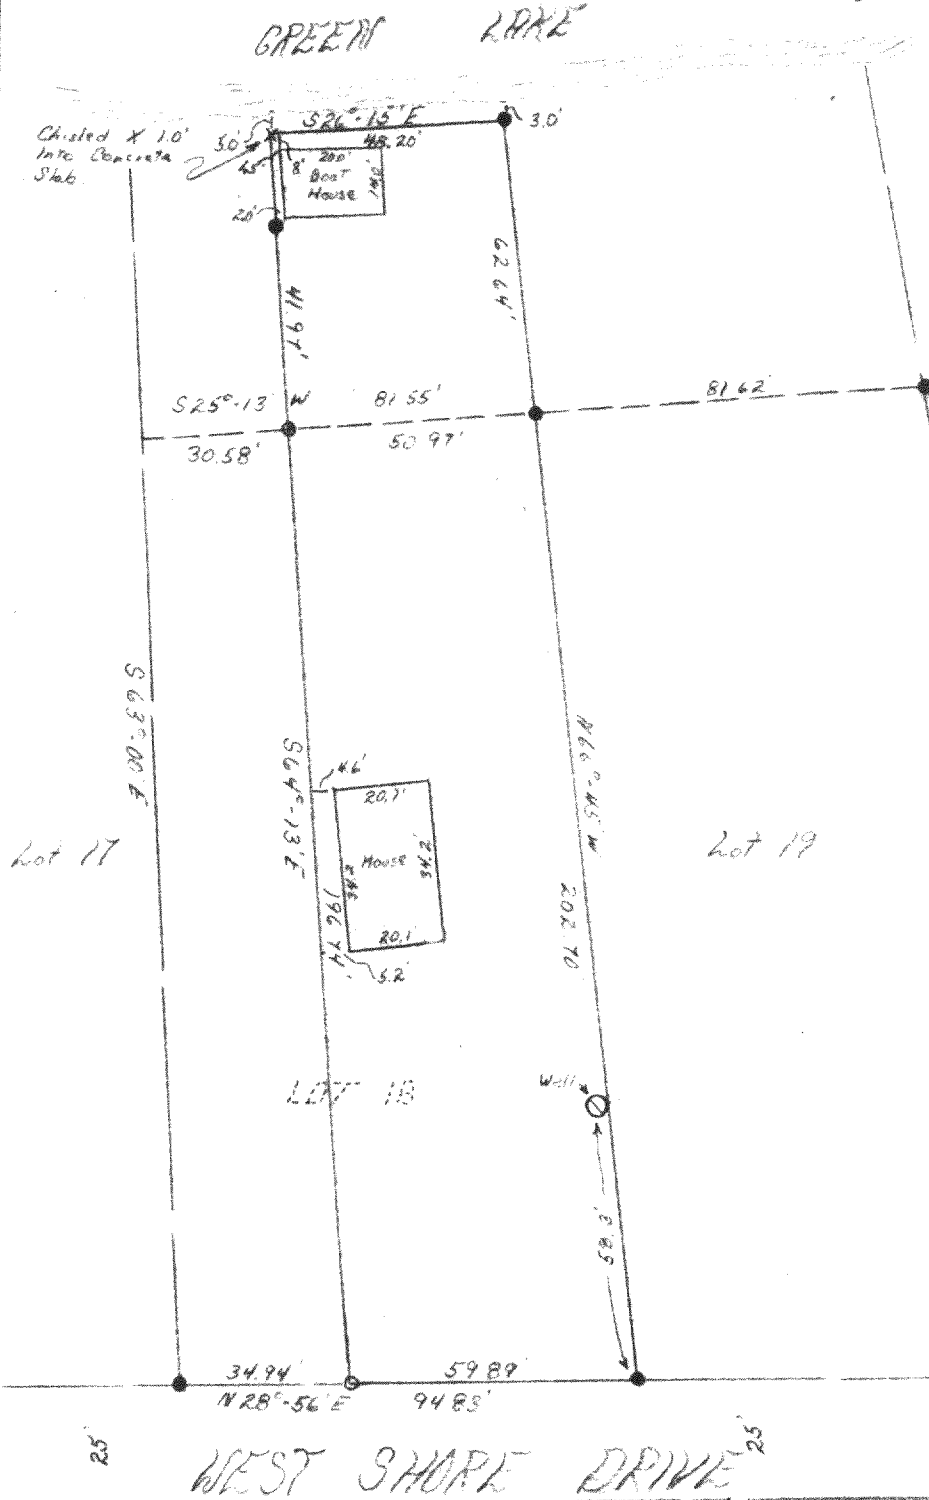

SCALE 1" = 40'
Bearing referenced to center line of West Line Road assumed bearing N 28° 56' 00" E

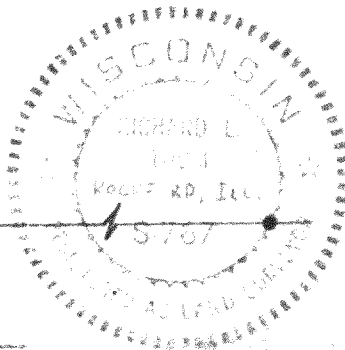

SURVEY AND PLAT BY
JENSEN & JOHNSON,
CIVIL ENGINEERS AND SURVEYORS
Elkhorn, Wisconsin

LEGEND

- — 1" x 24" Iron rod set
 - — 1" Iron Pipe found
- Scale 1" = 40'

WE CERTIFY: That we have surveyed the above described property and that the plat shown hereon is an accurate survey and a true representation thereof and correctly shows the exterior boundary lines and all divisions of said property.

HMP-16

Date MAY 5, 1977

Richard L. Jensen

SURVEYED FOR JAMES P. SHANNON

Wisconsin Registered Land Surveyor, No. S-767