


Plat of Survey

LOT 12 DUNBAR ESTATES SUBDIVISION, located in the Northwest 1/4 of the Southeast 1/4, and the Northeast 1/4 of the Southeast 1/4 of Section 36, Town 4 North, Range 16 East, Town of LaGrange, Walworth County, Wisconsin.

Surveyed for: Alan Thomas

Survey address: W4947 Dunbar Dr.

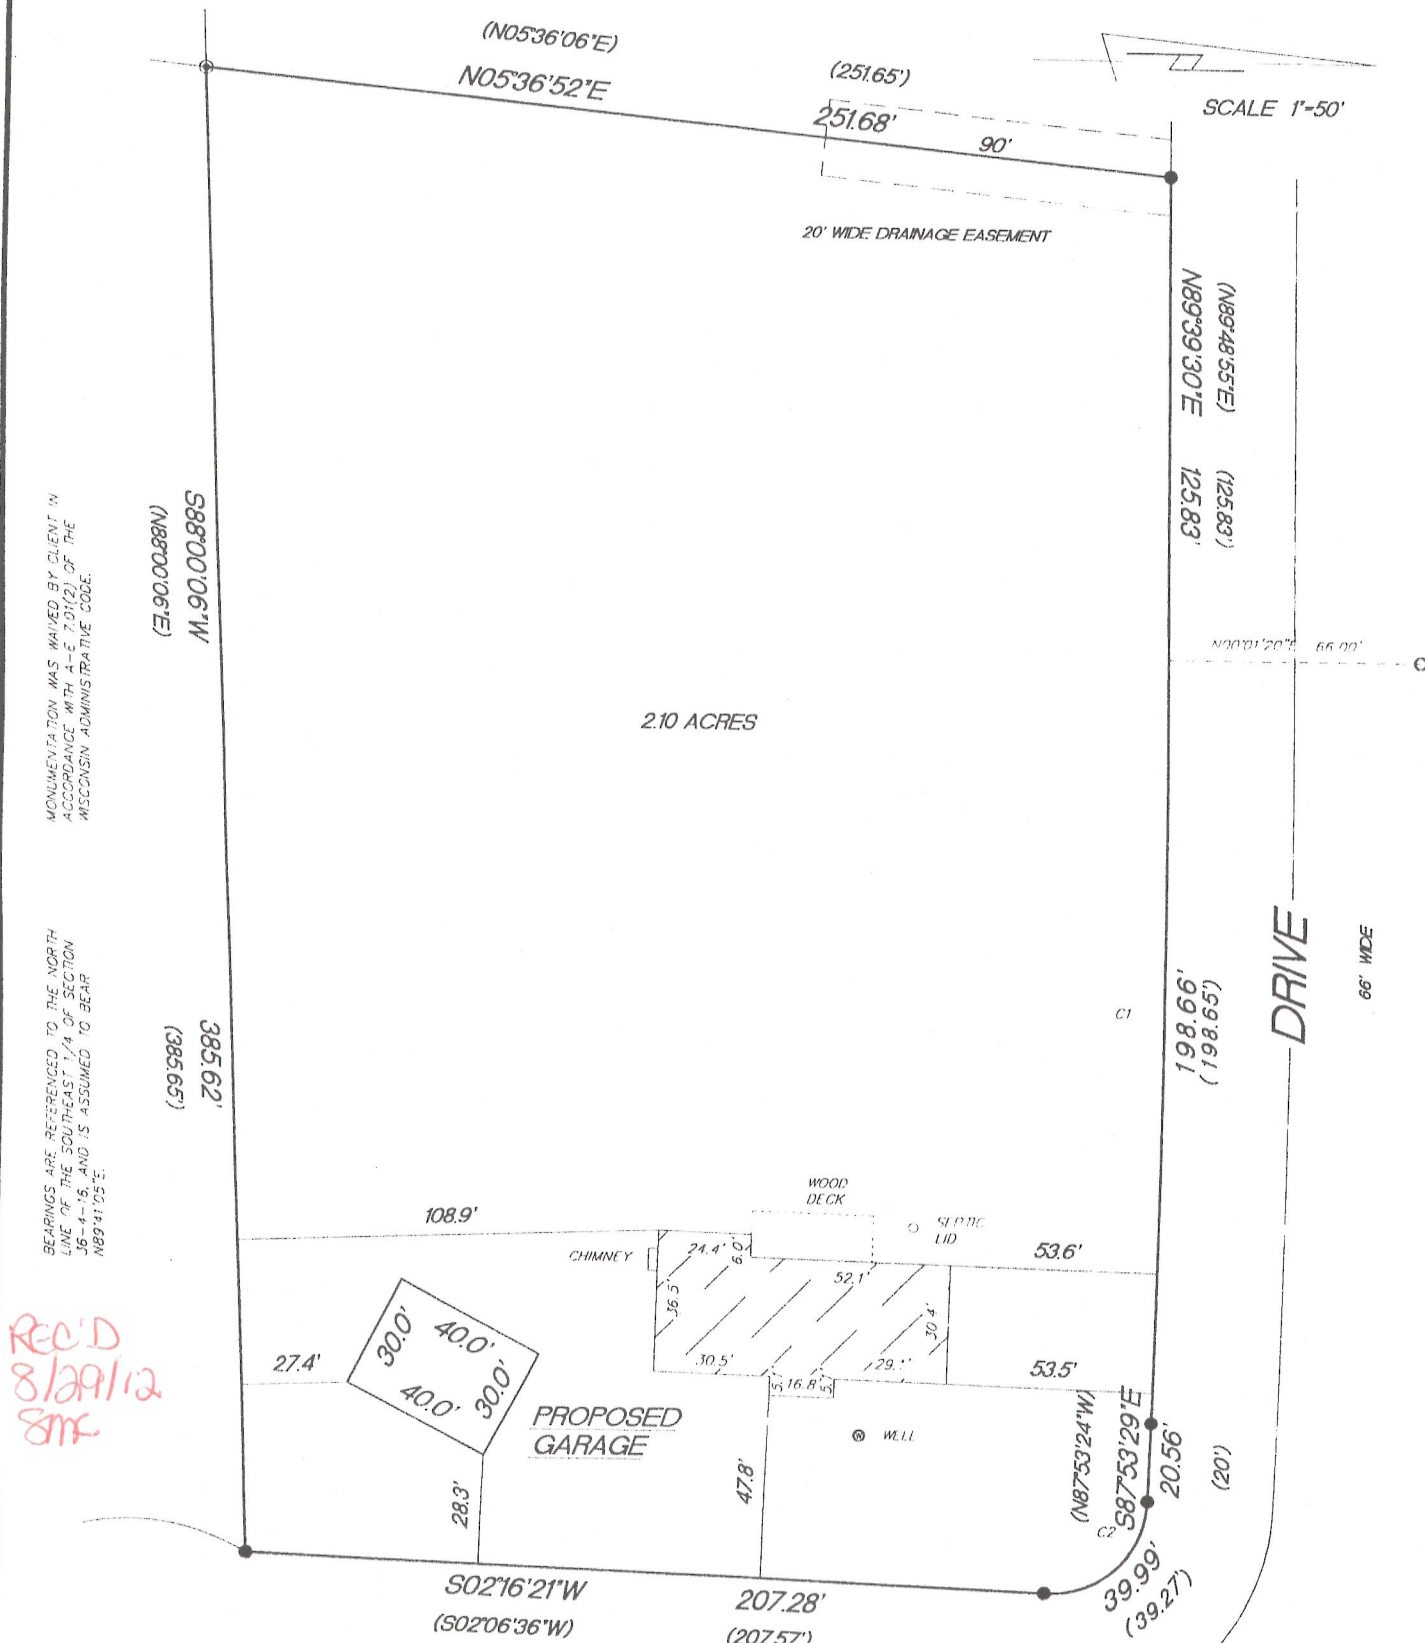

REC'D
8/29/12
SMC

MEASURED CURVE DATA					
CURVE	RADIUS	LENGTH	CHORD	BEARING	DELTA
C1	4960.03'	198.66'	198.64'	S89°03'36"E	02°17'41"
C2	25.00'	39.99'	35.86'	S42°00'01"E	91°38'48"

RECORDED CURVE DATA					
CURVE	RADIUS	LENGTH	CHORD	BEARING	DELTA
C1	4960.030'	198.65'	198.638'	S89°02'14.5"E	02°17'41"
C2	25.00'	39.27'	35.355'	S42°53'24"E	90°00'00"

"I hereby certify that I have surveyed the above described property and that the above map is a true representation thereof and shows the size and location of the property, its exterior boundaries, the location of all visible structures and dimension of all principal buildings thereon, boundary fences, apparent easements, roadways and encroachments if any."

"This survey is made for the use of the present owners of the property, and also those who purchase, mortgage or guarantee the title thereto within one year from date hereof."

KETTLE MORaine SURVEYING INC.
S75 W36245 Wilton Road
Eagle Wisconsin 53119
P.O. Box 357
(262) 594-3484
Terrance E. Pisarek R.L.S.



THIS IS NOT AN ORIGINAL SURVEY UNLESS THE SEAL IS RED.

5/14/12	TEP	TEP	12035
DATE	FIELD WORK BY	DRAWN BY	JOB NUMBER

HDS-12

416-2008