


Bay Drive

(66' Wide)

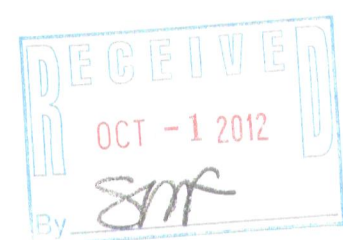

(Marsh)
Pond

Connected to Middle Lake
by channel.



Shoreline of Marsh
As shown the plat
of Bubbling Springs
Subdivision.

Lot 16
Tax Parcel
HBS 00016
0.312 Acre
13,604 Sq.Ft.

House
W5890

2 Story Deck

Garage

Garage 2.4' E. of line
Roof 1.7' E. of line

Well

Well

Well

Roof Overhang

Garage

Garage 2.0' W. of line
Roof 1.1' W. of line

(43.51')
43.45'


Top of leaning pipe is
at corner, 2nd pipe is
straight, but is 0.31
N14°13'27"W of
corner.

Overhead Wires

Bubbling Springs Drive
(66' Wide)

Notes:

- 1) This survey plat is not certified unless signed and sealed in red ink.
- 2) This survey is subject to Wisconsin lien laws. This Plat of Survey is the notice of intent to file lien. Lien waiver required.

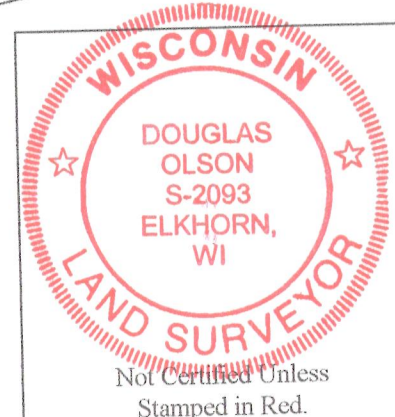

Plat of Survey

of


Lot 16 of Bubbling Springs Subdivision,

located in the Southeast 1/4 of Section 34, Town 4 North, Range 16 East, Town of LaGrange, Walworth County, Wisconsin.

Surveyed for:

Coldwell Banker, Leith & Associates

102 North Wisconsin Street
Elkhorn, Wisconsin. 53121

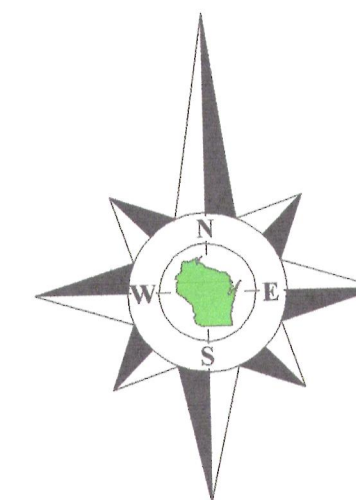

Bearings reference to the plat of
Bubbling Springs Subdivision.

Copyright 2012 by Jensen & Olson Land Surveying, LLC.

All rights reserved. No part of this survey plat may be reproduced or transmitted in any form by any means - graphic, electronic, or mechanical, including photocopying, tracing, or information storage and retrieval systems - without permission in writing from Douglas G. Olson, Jensen & Olson Land Surveying, LLC.


I hereby certify that I have surveyed the above described property and the map hereon is correct to the best of my professional knowledge and belief and shows the size and location of the property, its exterior boundaries, the location and dimensions of all visible structures thereon, boundary fences, apparent easements and roadways and visible encroachments, if any.

This survey is made for the exclusive use of the present owners of the property, and also those who purchase, mortgage or guarantee title thereto, within one year from the date hereof.

Douglas G. Olson
Wisconsin Registered Land Surveyor - 2093

Survey Date: February 22, 2012

Revisions:

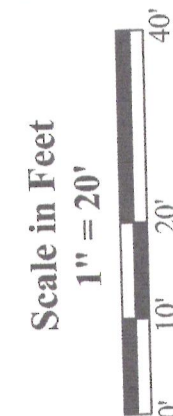

Jensen & Olson Land Surveying, LLC

45 South Wisconsin Street * P.O. Box 322 * Elkhorn, Wisconsin. 53121

Telephone: (262) 723-3434 * Facsimile: (262) 723-8044

Email: jensen.olson@elknet.net

Legend

- Found Iron Pipe
- Found Metal Nail
- Recorded Information
- Utility Pedestal
- Concrete Cover
- Asphalt Surface
- Concrete Surface
- Gravel

Sheet 1 of 1 Sheets

Job Reference Number

2012.011

2012.011

HBS-16

416-2610