


PLAT OF SURVEY

- OF -

COMMENCING AT THE NORTHEAST CORNER OF LOT 22, BLOCK 2 OF GREEN LAKE PARK LOCATED IN THE SOUTHWEST 1/4 OF SECTION 26, TOWN 4 NORTH, RANGE 16 EAST, THENCE SOUTH 48°45' EAST 29.90 FEET TO THE PLACE OF BEGINNING; THENCE SOUTH 48°45' EAST 10 FEET; THENCE SOUTH 65°03' EAST 39.95 FEET; THENCE SOUTH 31°44' WEST 163.72 FEET TO A MEANDER LINE OF GREEN LAKE, WHICH LINE RUNS SOUTH 82°13'30" WEST 26.80 FEET AND NORTH 38°30' WEST 76.05 FEET; THENCE CONTINUE SOUTH 31°44' WEST 32.47 FEET TO THE SHORE OF GREEN LAKE; THENCE NORTHEASTERLY ALONG THE SHORE OF GREEN LAKE 108 FEET MORE OR LESS; THENCE NORTH 47°24' EAST 56.98 FEET TO THE ABOVE DESCRIBED MEANDER LINE; THENCE CONTINUE NORTH 47°24' EAST 157.80 FEET TO THE PLACE OF BEGINNING, ALL IN WALWORTH COUNTY, WISCONSIN

PATHFINDER SURVEYING INC.
(formerly)
J.K. SURVEYING INC.
P.O BOX 322
LAKE GENEVA, WI. 53147
WWW.PATHFINDERSURVEYING.NET
262-248-8303

PREPARED FOR
JERRY KROUPA
KEEFE REAL ESTATE
ELKHORN WI.

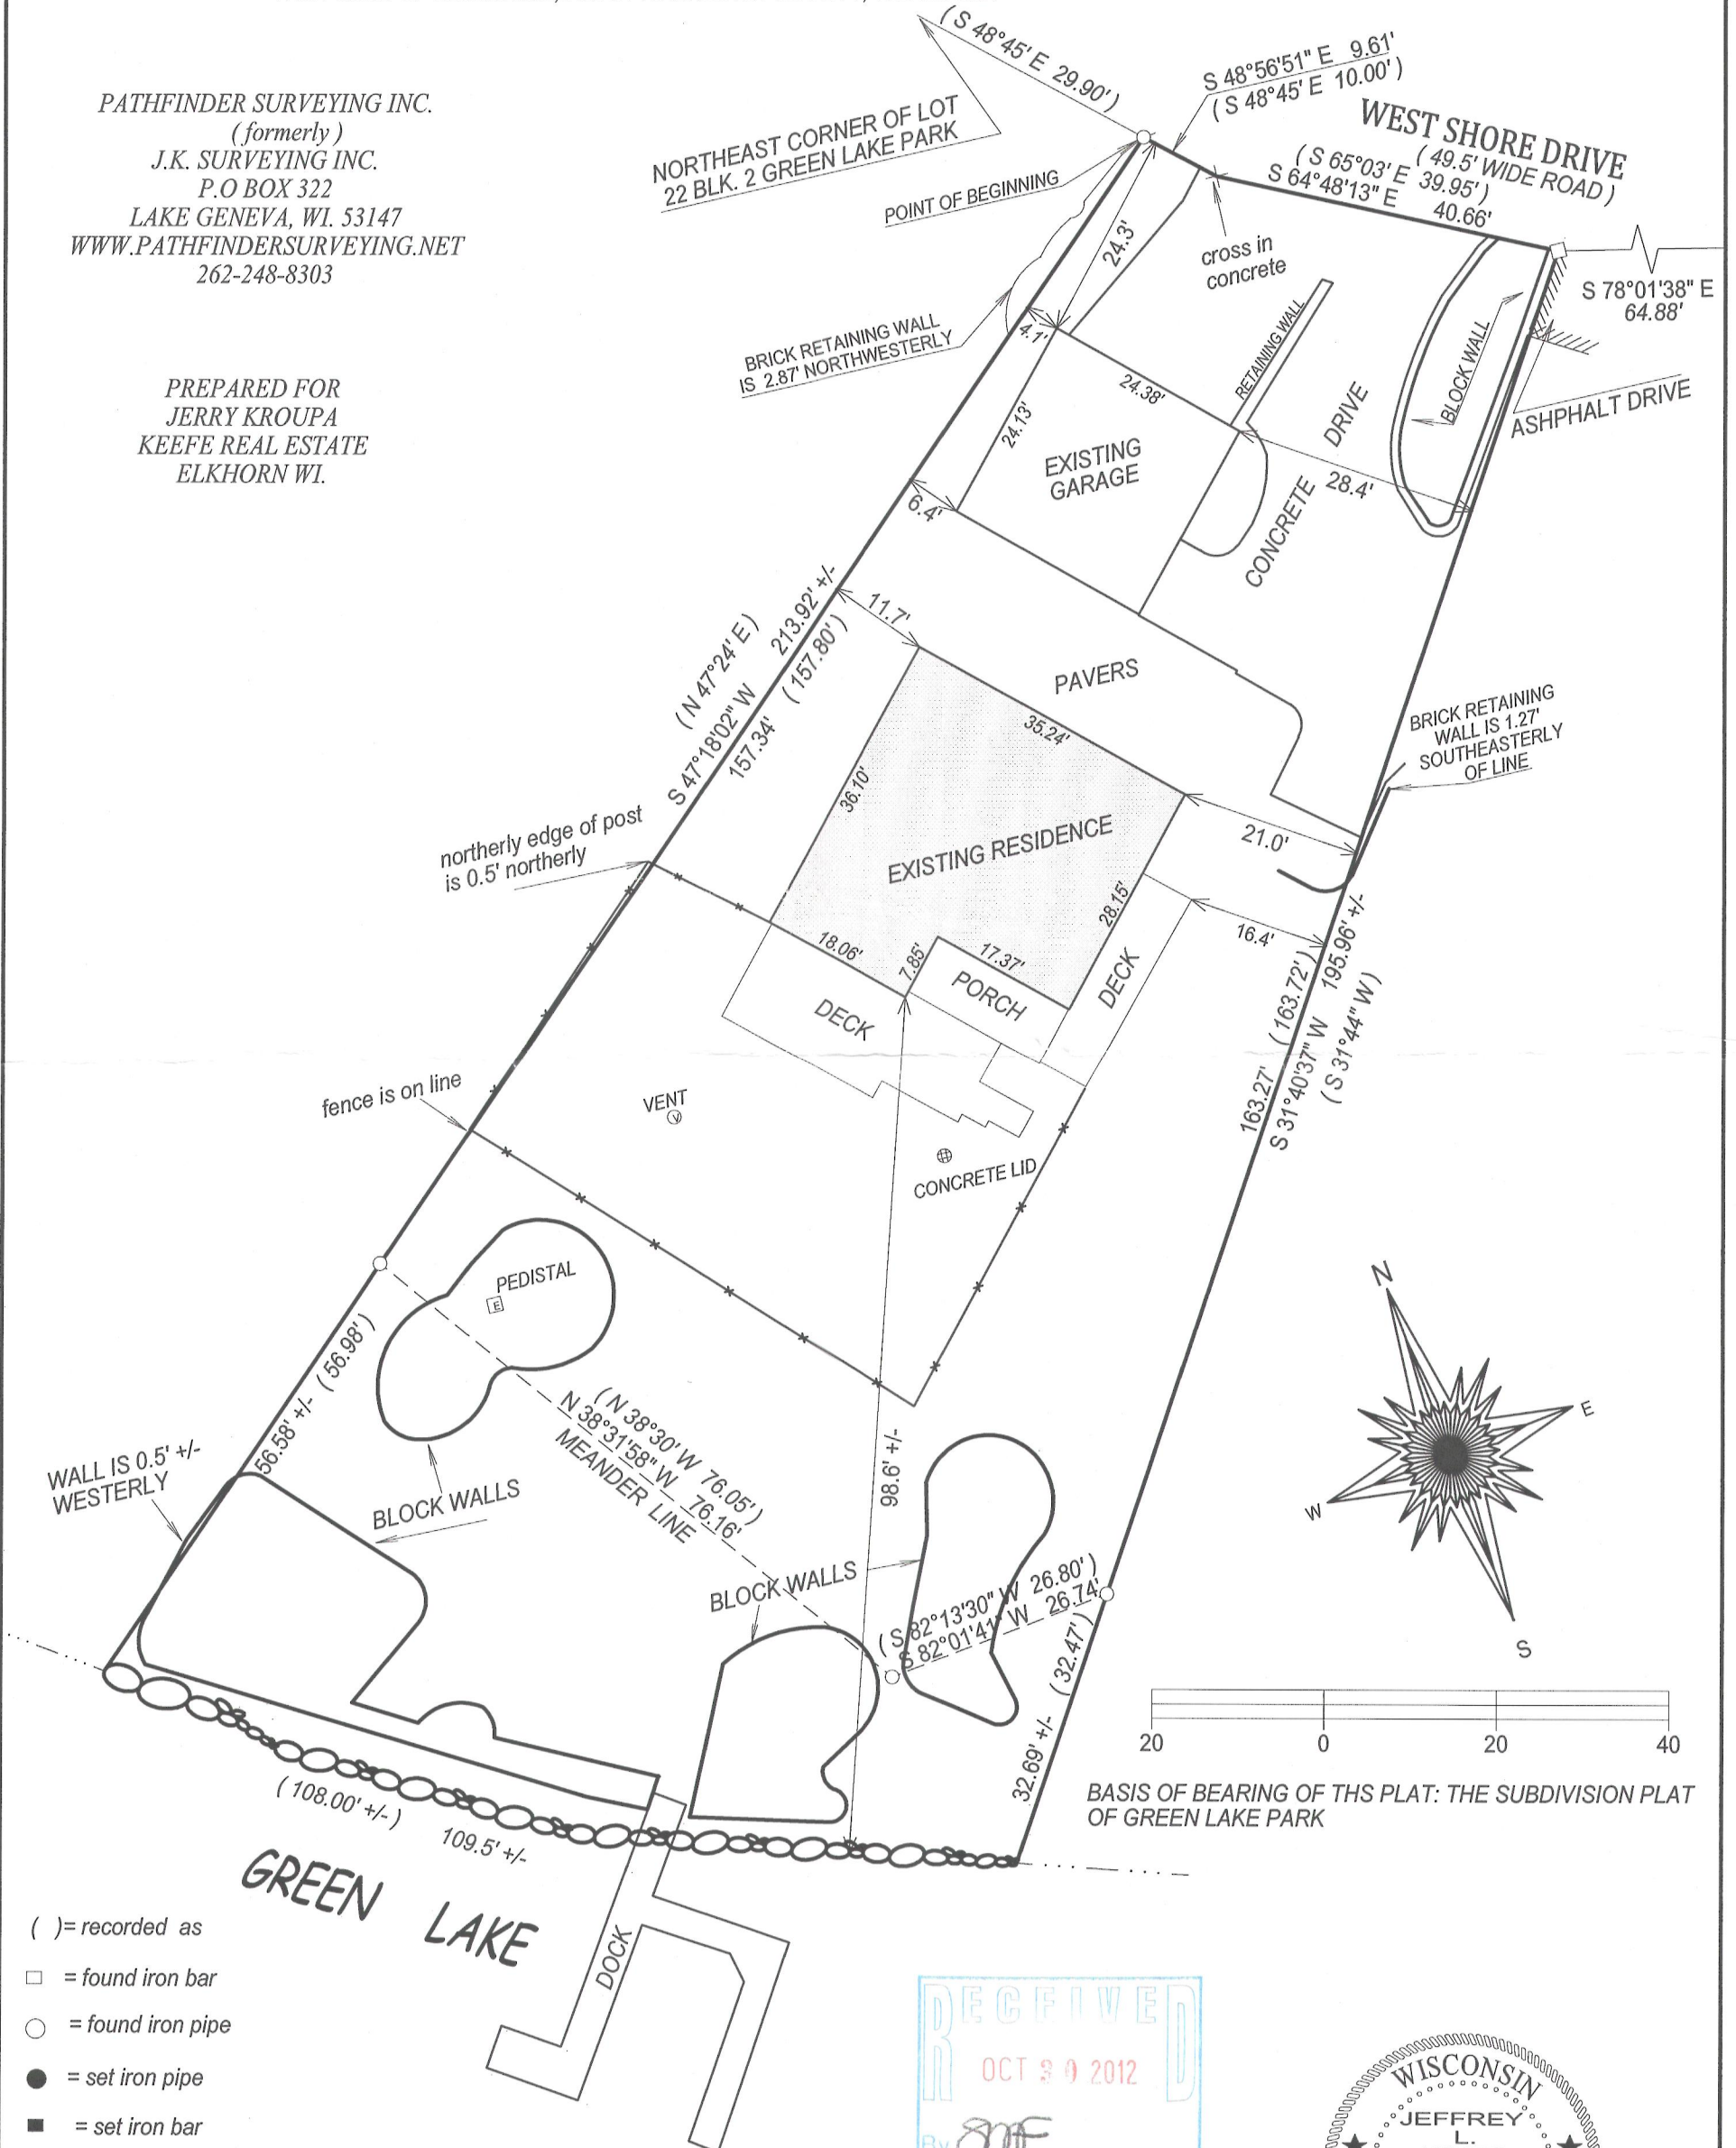

- () = recorded as
- = found iron bar
- = found iron pipe
- = set iron pipe
- = set iron bar

SCALE 1" = 20'

JOB # 12-89

TAX ID # HGP-18F

"I hereby certify that I have surveyed the above described property and that the above map is a true representation of its exterior boundary and shows the size and location of all visible structures, apparent easements and encroachments if any."

This survey is made for the present owners of the property, and those who purchase, mortgage, or guarantee the title thereto, within one year from the date hereof.

DATED THIS 27TH DAY OF JUNE, 2012.



JEFFREY L. KIMPS S - 2436
Wisconsin Registered Land Surveyor
(original if signed in red)

416-2621