


PLAT OF SURVEY


LOT 2 CSM 788
LOCATED IN THE NW 1/4 & SW 1/4 OF THE SW 1/4
SECTION 24, TOWN 4 NORTH, RANGE 16 EAST
WALWORTH COUNTY, WI.

PARCEL 1: Lot 2 of Certified Survey Map No. 788 recorded May 19, 1978 in Volume 3 of
Certified Surveys on Page 326 as Document No. 32865.
PARCEL 2: A right-of-way to the public highway in common with other lot owners on
Pleasant Lake, as specifically described in Deed No. 473915 recorded in Volume 487
of Walworth County Deeds, on Page 171.
Tax Key No: HA 78800002

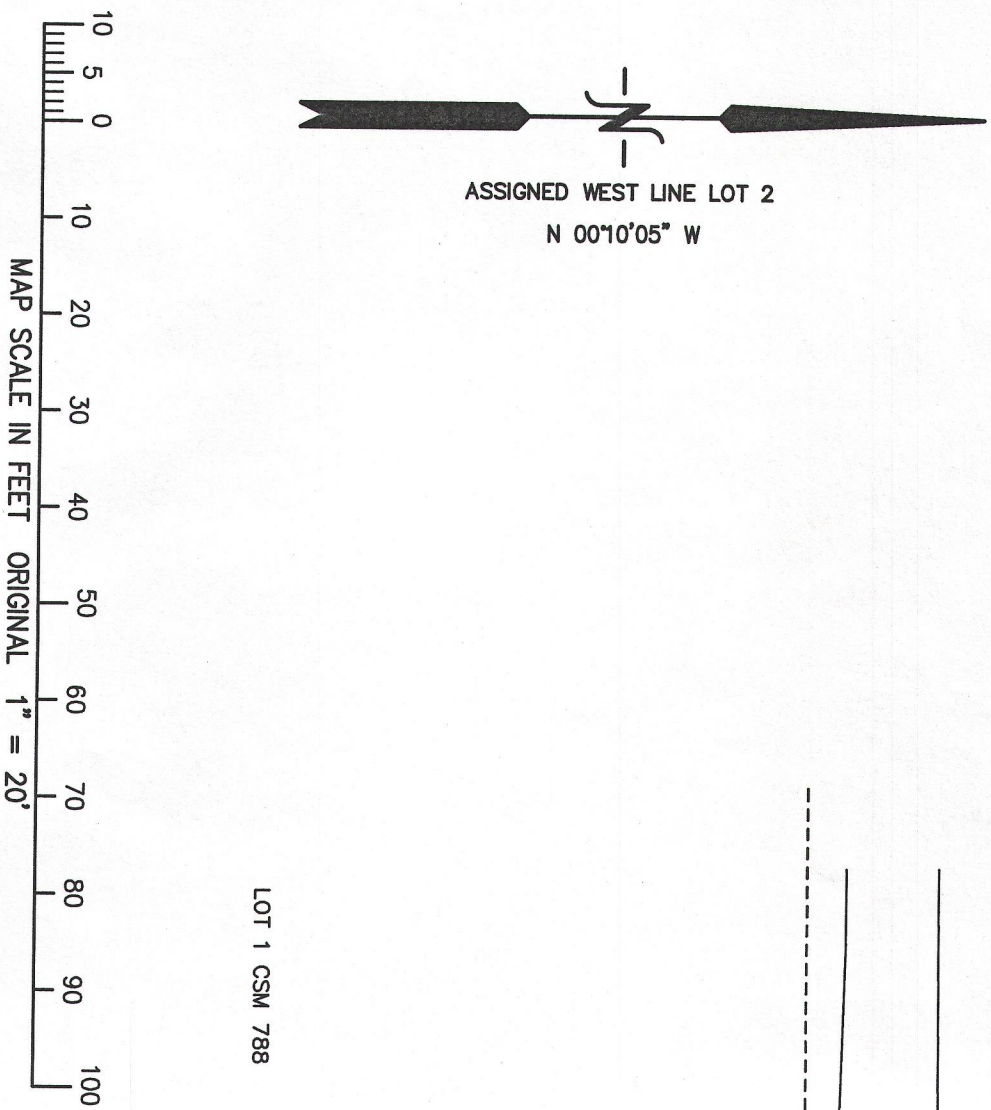

- LEGEND
- = FOUND IRON PIPE STAKE
 - = FOUND IRON REBAR STAKE
 - = SET IRON REBAR STAKE
 - (xxx) = RECORDED AS
 - = POWER POLE

NOTE: DGS, ASSURES ALONG FOR MEASURING LINE SYSTEM
OVER THE PROPERTY WITH A SPECIAL INSTRUMENT.
THIS SURVEY WAS MADE WITH THE GROUND UNDER SNOW ON THE DATE OF THE FIELD
WORK.

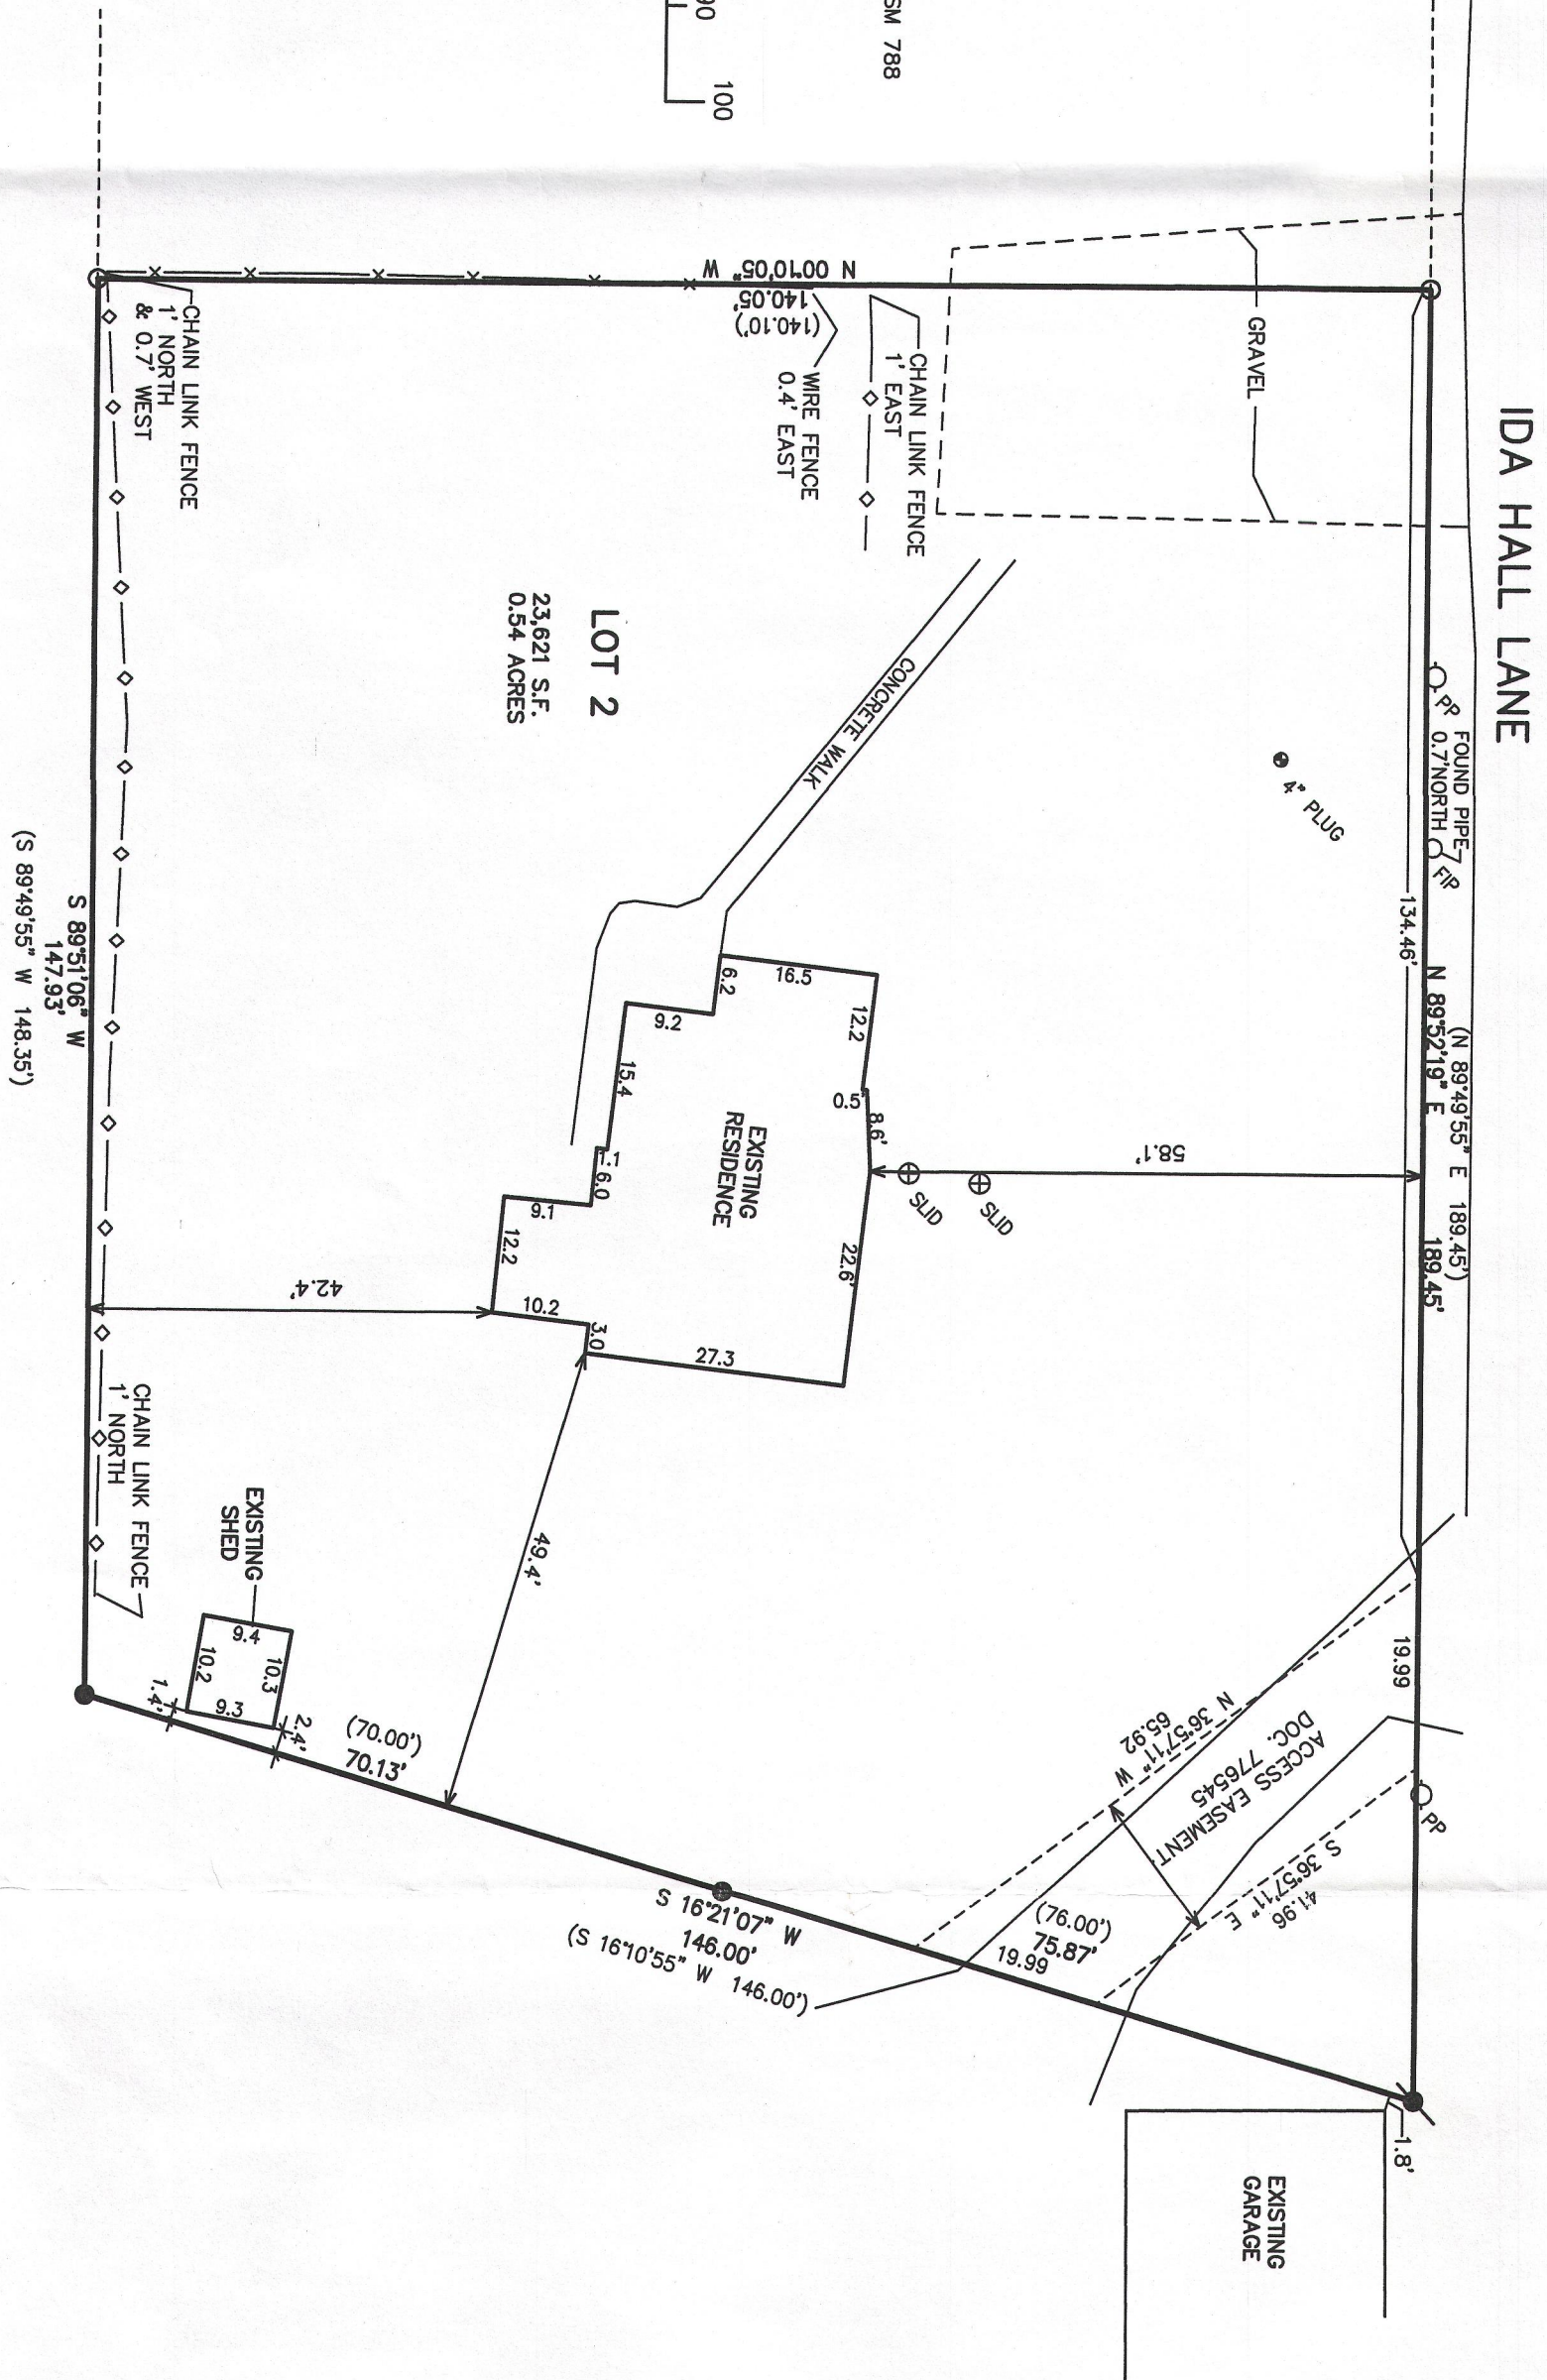

PARCEL 2 RIGHT OF WAY

IDA HALL LANE

16' WIDE RIGHT OF WAY TO PUBLIC HIGHWAY VOL. 487, Pg 171
IN COMMON WITH OTHERS

STATE HIGHWAY 67

LOT 2
CSM 788

NOTE: COPIES OF THIS MAP TO WHICH THE FOLLOWING CERTIFICATE WILL APPLY, SHOW
THE SURVEYOR'S ORIGINAL SEAL AND SIGNATURE IN RED INK. COPIES BY ANY OTHER
PERSON, WITHOUT THE SURVEYOR'S SIGNATURE, ARE NOT VALID. ANY ALTERATIONS
TO THE MAP, INCLUDING BUT NOT LIMITED TO, CHANGES IN THE SURVEYOR'S
PRODUCT, HAVE ALTERATIONS WHICH DO NOT REPRESENT THE SURVEYOR'S WORK.
I HEREBY CERTIFY THAT THE ABOVE DESCRIBED PROPERTY HAS BEEN SURVEYED UNDER
MY DIRECTION AND THAT THE ABOVE MAP IS THE REPRESENTATION OF THE PROPERTY,
SHOWS THE SIZE AND LOCATION OF THE PROPERTY, ITS EXTERIOR BOUNDARIES, THE
BUILDINGS THEREON, AND THE LOCATION OF ALL PRINCIPAL, AND
VISIBLE ENCROACHMENTS, IF ANY. THIS SURVEY IS MADE FOR THE USE OF THE
OWNER OF THE PROPERTY, AND ALSO THOSE WHO PURCHASE, MORTGAGE, OR
GUARANTEE THE TITLE THEREIN WITHIN ONE YEAR FROM THE DATE HEREOF.

DATED: MARCH 25, 2013

PETER S. GORDON



WORK ORDERED BY:
THE RAULAND AGENCY
118 KENOSHA STREET
WALWORTH, WI. 53184

FARRIS, HANSEN & ASSOCIATES, INC.
ENGINEERING — ARCHITECTURE — SURVEYING
7 RIDGWAY COURT P.O. BOX 437
ELKHORN, WISCONSIN 53121
OFFICE: (262) 723-2098 FAX: (262) 723-5886

REVISIONS

PROJECT NO.
8761

DATE
03-21-2013

SHEET NO.
1 OF 1