

KROTT SURVEYING INC.

N3705 WILLOW BEND LANE
LAKE GENEVA WI. 53147
PHONE # (262)248-3697
FAX # (262)249-0639

LOT 114 MARINER HILLS SUBDIVISION, LOCATED IN THE NW 1/4 OF THE SW 1/4, AND THE SW 1/4 OF THE SW 1/4, AND THE SE 1/4 OF THE SW 1/4, AND THE SW 1/4 OF THE SE 1/4, OF SECTION 34, T4N, R16E, TOWN OF LAGRANGE, WALWORTH COUNTY, WISCONSIN.

C.L. BUBBLING SPRINGS DRIVE

(66' WIDE)




LEGEND

- FOUND IRON PIPE
□ FOUND IRON BAR
■ SET IRON BAR

(XX) RECORDED AS

JOB # 13-037

TAX ID # ~~HMH 0114~~

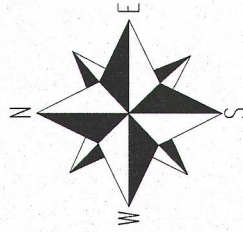


SCALE 1" = 20'

BEARINGS REFERENCED TO THE RECORD PLAT

I have surveyed the above-described property and the above maps is a true representation thereof and shows the size and location of the property, its exterior boundaries, the location and dimensions of all structures thereon, fences apparent easements and roadways and visible encroachments, if any.

This survey is made for the exclusive use of the present owners of the property, and also those who purchase, mortgage, or insure the title thereto within one (1) year from date hereof, and as to them I warrant the accuracy of said survey map.

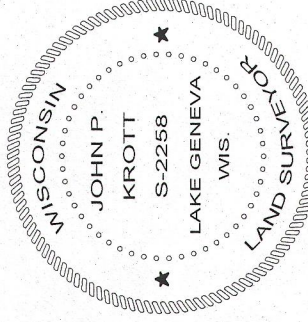

DATED THIS 2nd, DAY OF APRIL, 2013

[Handwritten signature in red ink]

JOHN KROTT S - 2258
Wisconsin Registered Land Surveyor
(original if signed in red)

416-2649