


AS-BUILT MAPPING
PART OF LOT 2 CSM 4174
REC. AS DOC. 744871
LOCATED IN THE SW 1/4 & SE 1/4 OF SECTION 23 &
THE NW 1/4 & NE 1/4 OF SECTION 26
TOWN 4 NORTH, RANGE 16 EAST
WALWORTH COUNTY, WISCONSIN

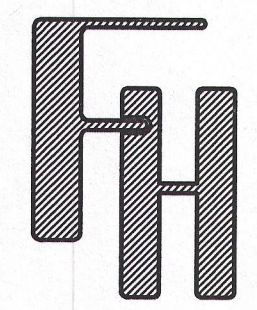

ASBUILT
MAPPING
TOWN OF LA GRANGE, WALWORTH COUNTY, WISCONSIN

ORDERED BY
THELEN TOTAL CONSTRUCTION
FOR
THOMAS J. FORMOLO

FARRIS, HANSEN & ASSOCIATES, INC.
ENGINEERING - ARCHITECTURE - SURVEYING
7 RIDGWAY COURT P.O. BOX 437
ELKHORN, WISCONSIN 53121
OFFICE: (262) 723-2098 FAX: (262) 723-5886

REVISIONS	
01-03-2012	UPDATE INFO
02-07-2013	KB ADVANCE PLAN
4/15/2013	KB ADJUST PLAN FOR NEW BUILDING LOCATION
6/13/2013	KB TO SHOW SIZE & LOC. OF ASBUILT FOUNDATION

PROJECT NO.
6492.13
DATE
09-25-2008
SHEET NO.
1 OF 1

CERTIFIED SURVEY MAP NO. 4174

A PARCEL SPLIT LOCATED IN PART OF THE NE 1/4 AND SE 1/4 OF THE SW 1/4 AND THE NW 1/4 AND SW 1/4 OF THE SE 1/4 OF SECTION 23 AND THE NE 1/4 OF THE NW 1/4 AND THE NW 1/4 OF THE NE 1/4 OF SECTION 26, ALL IN TOWN 4 NORTH, RANGE 16 EAST, TOWN OF LAGRANGE, WALWORTH COUNTY, WISCONSIN

LEGEND

- FOUND IRON PIPE STAKE, 1 3/8" O.D.
- FOUND IRON REBAR STAKE, 3/4" DIA.
- FOUND CONCRETE COUNTY MONUMENT
- W/ BRASS CAP
- SET IRON REBAR STAKE, 3/4" DIA.
- 2"x4"x13 lbs./ft.
- (XXX) = RECORDED AS

WISCONSIN LAND SURVEYOR
PETER S. GORDON
S-2101
ELKHORN, WI


FARRIS, HANSEN & ASSOC. INC.
7 RIDGWAY COURT - P.O. BOX 437
ELKHORN, WISCONSIN 53121
PHONE (262) 723-2098
FAX (262) 723-5886

PROJECT NO. 6492.08
DATED: 08-01-2008
SHEET 3 OF 4 SHEETS
MAP SCALE IN FEET ORIGINAL 1" = 400'

Vol 26 Page 211

RECORD COPY OF CERTIFIED SURVEY MAP NO. 4174

LOT 2


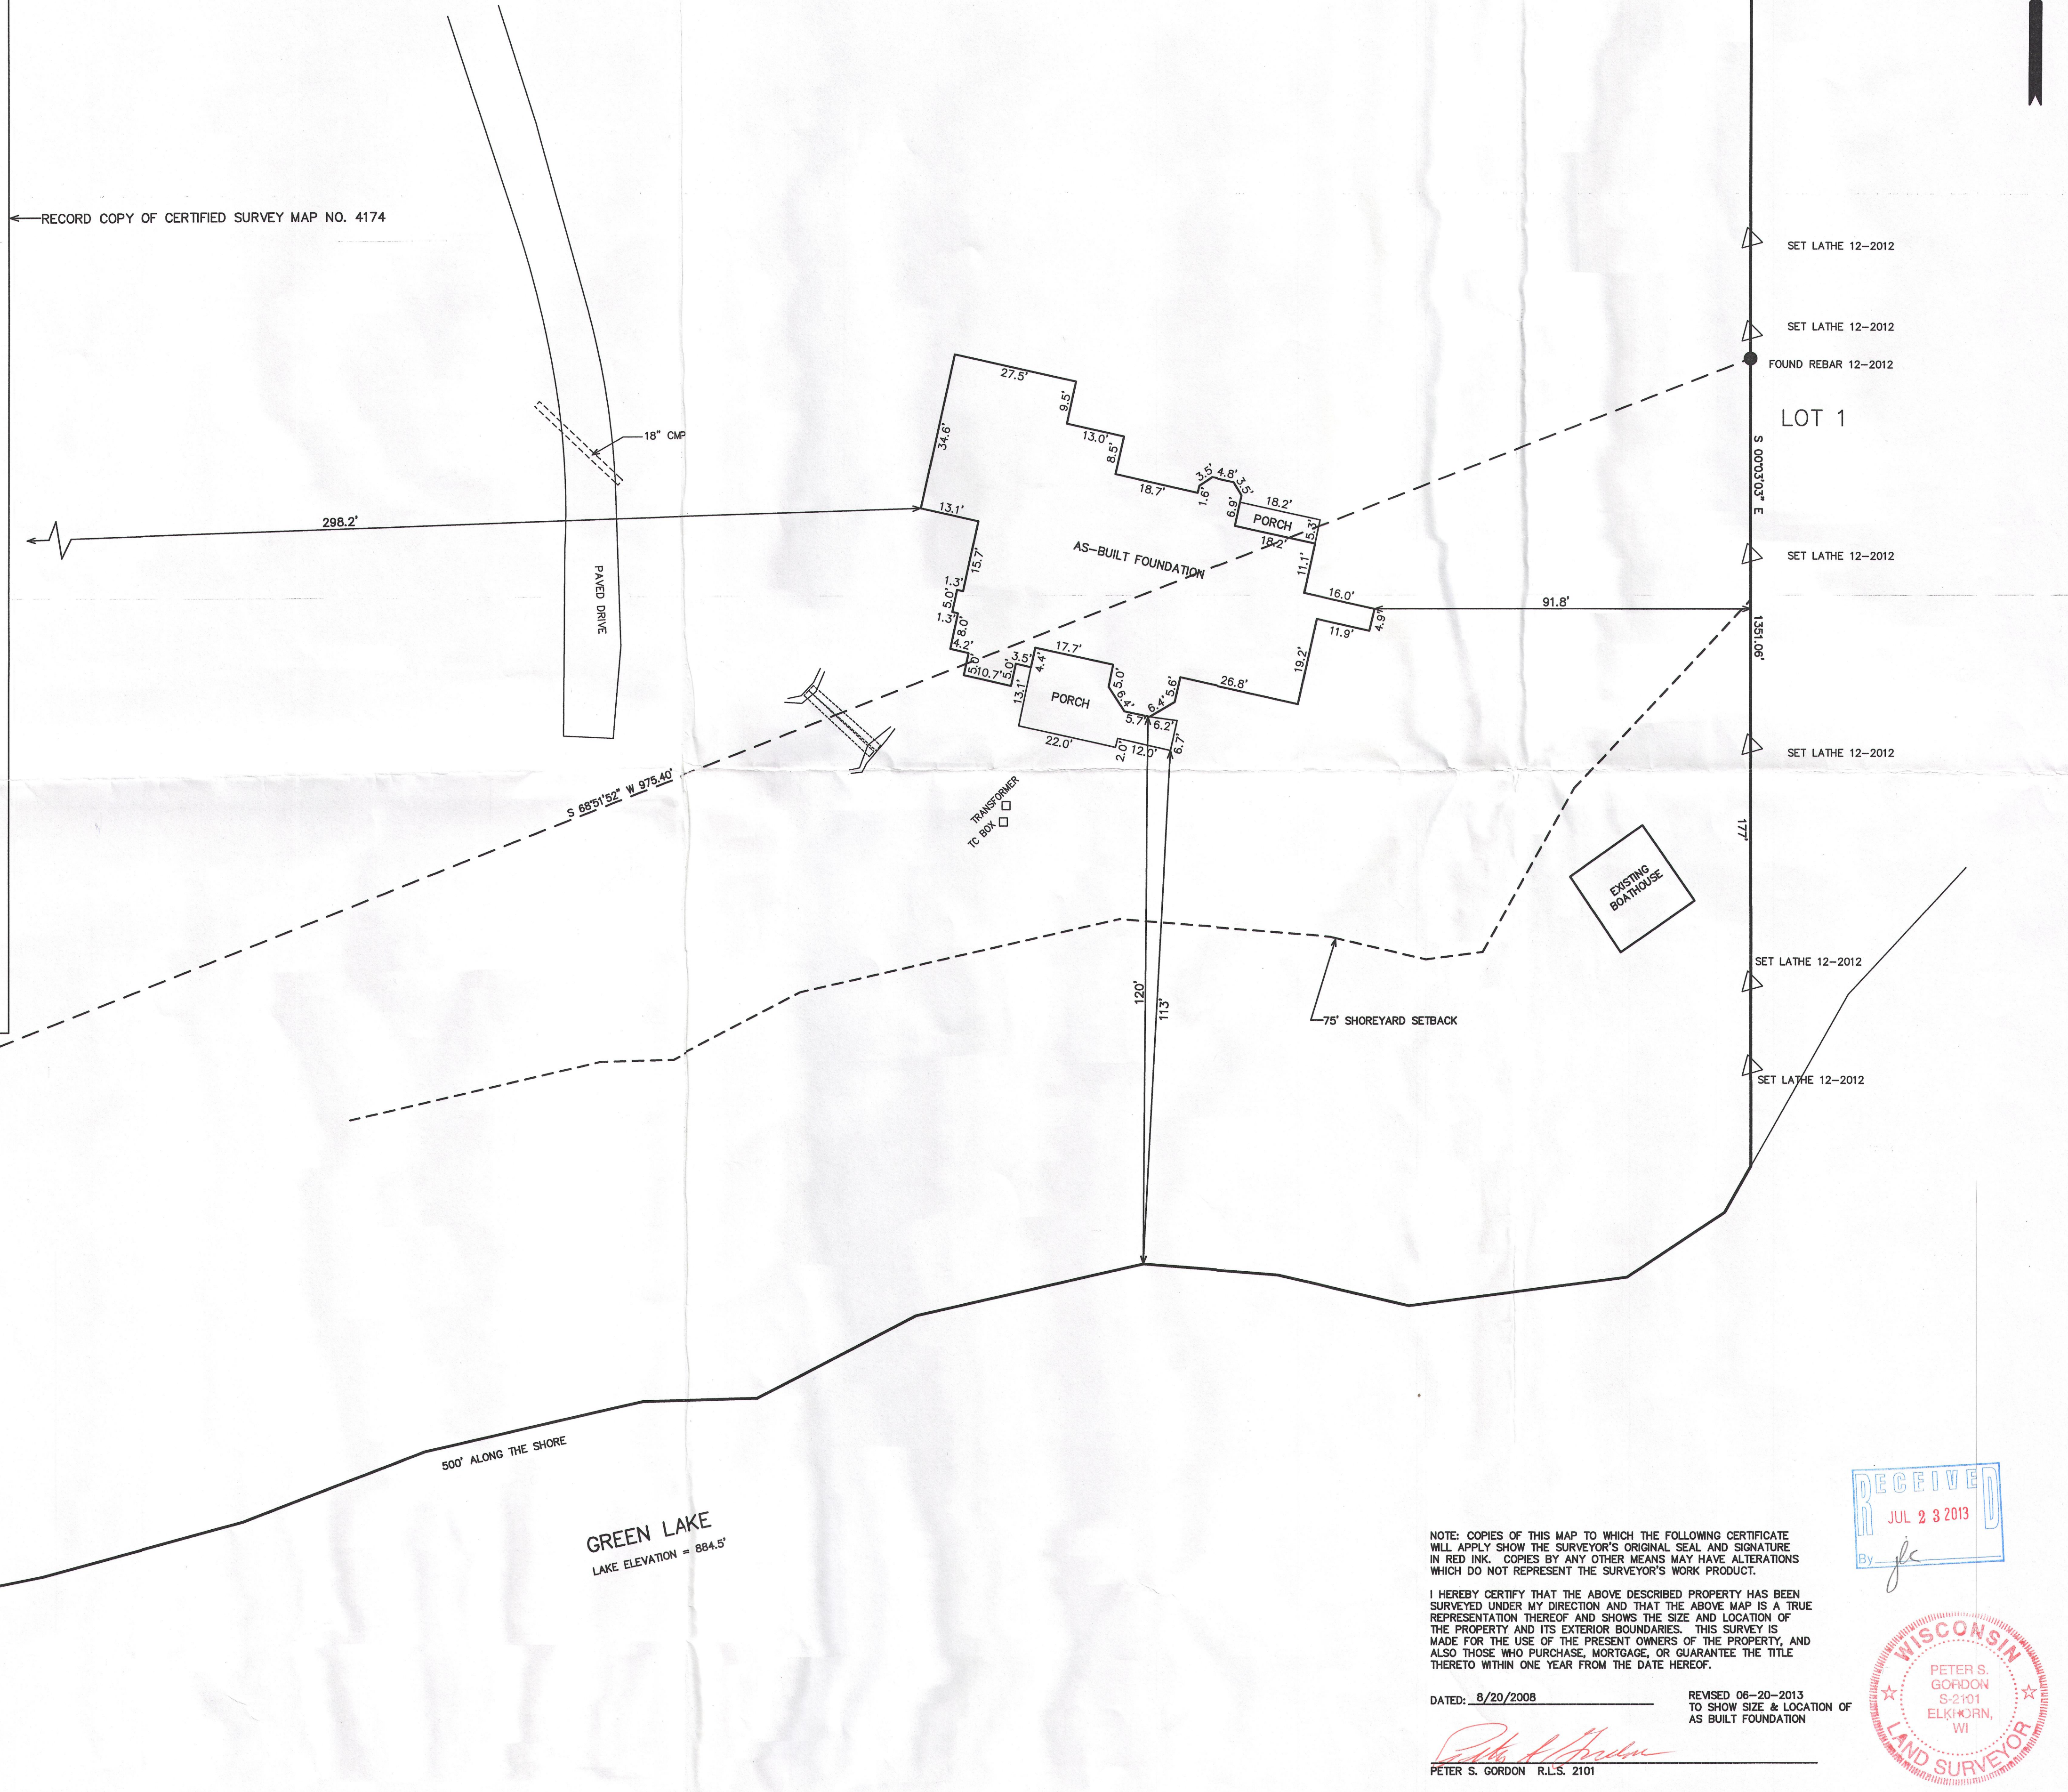


NOTE: COPIES OF THIS MAP TO WHICH THE FOLLOWING CERTIFICATE WILL APPLY SHALL SHOW THE SURVEYOR'S ORIGINAL SEAL AND SIGNATURE IN RED INK. COPIES BY ANY OTHER MEANS MAY HAVE ALTERATIONS WHICH DO NOT REPRESENT THE SURVEYOR'S WORK PRODUCT.

I HEREBY CERTIFY THAT THE ABOVE DESCRIBED PROPERTY HAS BEEN SURVEYED UNDER MY DIRECTION AND THAT THE ABOVE MAP IS A TRUE REPRESENTATION THEREOF AND SHOWS THE SIZE AND LOCATION OF THE PROPERTY AND ITS EXTERIOR BOUNDARIES. THIS SURVEY IS MADE FOR THE USE OF THE PRESENT OWNERS OF THE PROPERTY, AND ALSO THOSE WHO PURCHASE, MORTGAGE, OR GUARANTEE THE TITLE THERETO WITHIN ONE YEAR FROM THE DATE HEREOF.

DATED: 8/20/2008
PETER S. GORDON R.L.S. 2101

REVISED 08-20-2013
TO SHOW SIZE & LOCATION OF
AS BUILT FOUNDATION

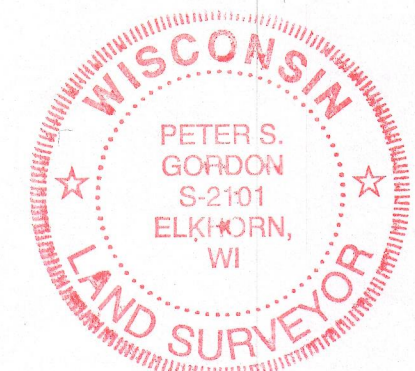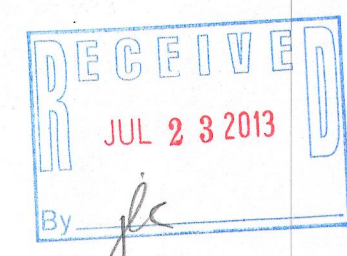

HA4174-2 416-2658