





PLAT OF SURVEY LOT 11 ARROWHEAD PARK ADDITION NO. 1

LOCATED IN SECTION 35
TOWN 4 NORTH, RANGE 16 EAST
WALWORTH COUNTY, WISCONSIN

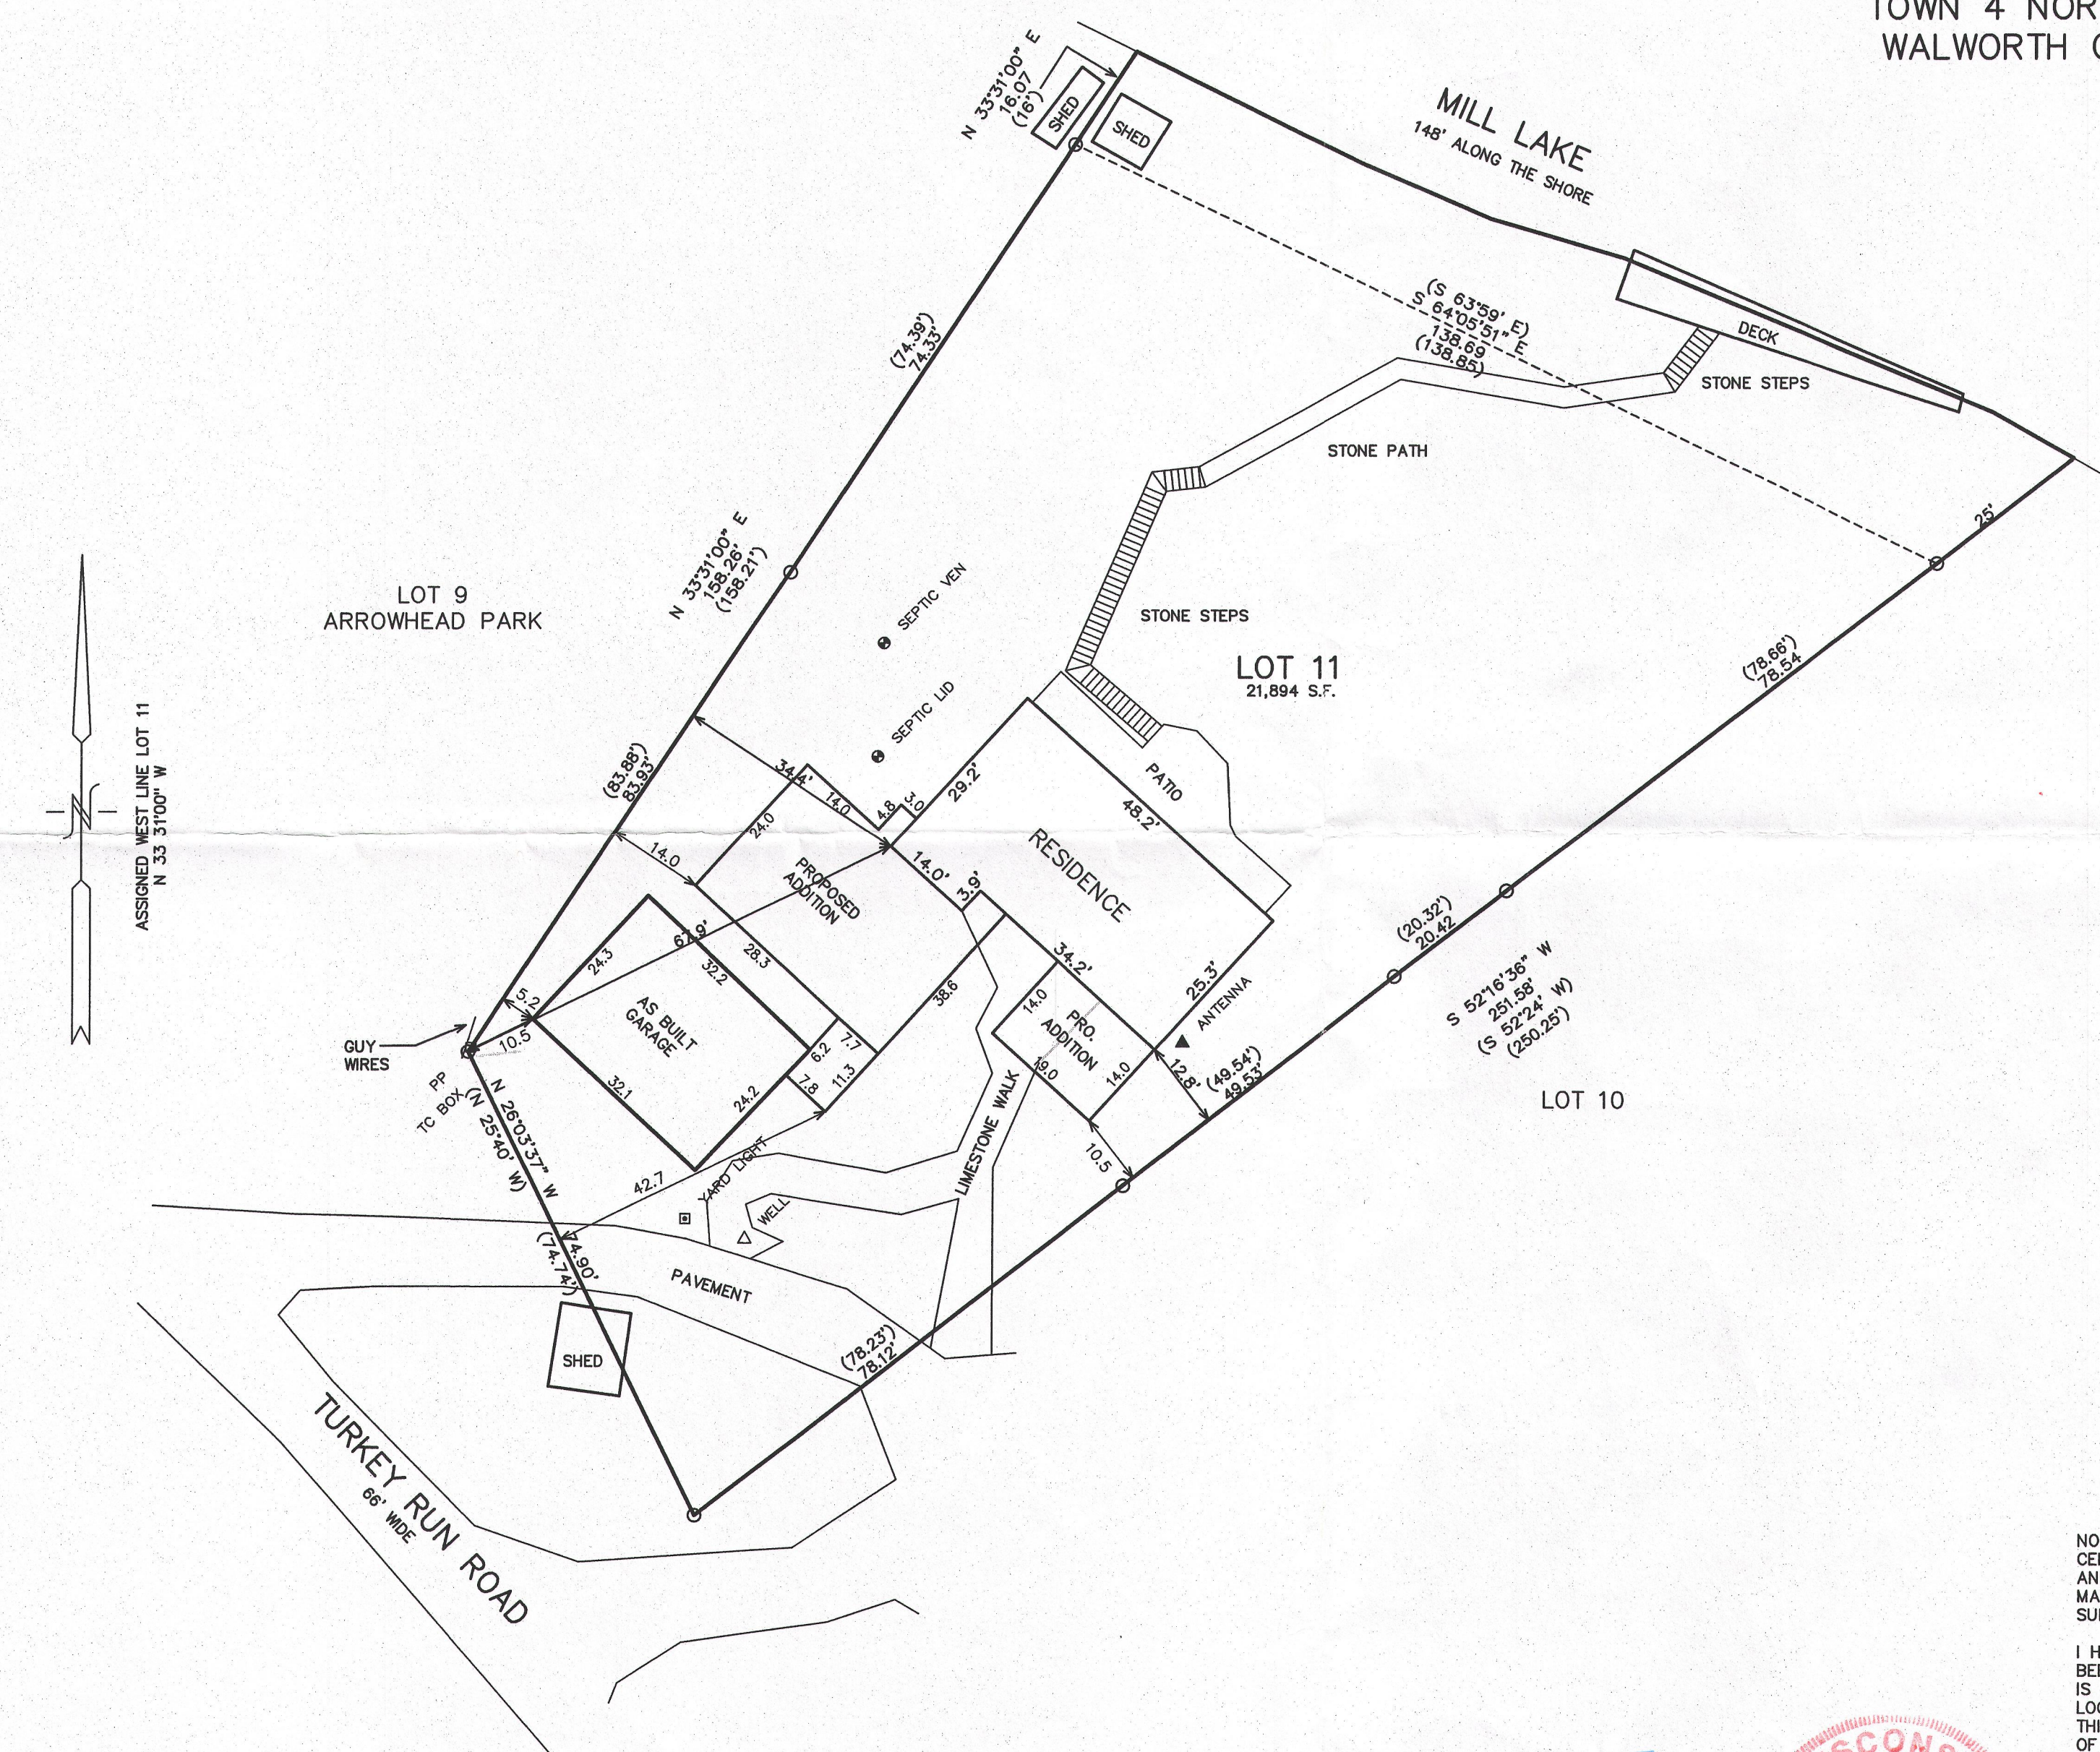


- LEGEND
- = FOUND IRON PIPE STAKE
 - = POWER POLE
 - (xxx) = RECORDED AS

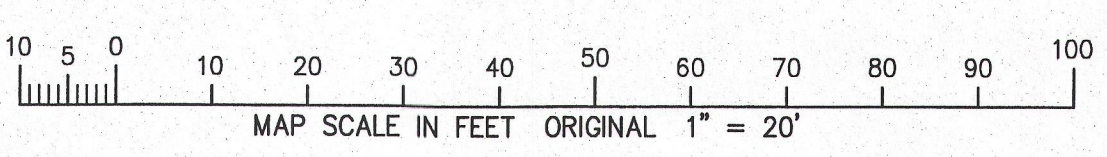

NOTE: COPIES OF THIS MAP TO WHICH THE FOLLOWING
CERTIFICATE WILL APPLY SHOW SURVEYOR'S ORIGINAL SEAL
AND SIGNATURE IN RED INK. COPIES BY ANY OTHER MEANS
MAY HAVE ALTERATIONS WHICH DO NOT REPRESENT THE
SURVEYOR'S WORK PRODUCT.

I HEREBY CERTIFY THAT THE ABOVE DESCRIBED PROPERTY HAS
BEEN SURVEYED UNDER MY DIRECTION AND THAT THE ABOVE MAP
IS A TRUE REPRESENTATION THEREOF AND SHOWS THE SIZE AND
LOCATION OF THE PROPERTY AND ITS EXTERIOR BOUNDARIES.
THIS SURVEY IS MADE FOR THE USE OF THE PRESENT OWNERS
OF THE PROPERTY, AND ALSO THOSE WHO PURCHASE, MORTGAGE,
OR GUARANTEE THE TITLE THERETO WITHIN ONE YEAR FROM THE
DATE HEREOF.

RECEIVED
OCT 18 2013
By *jc*

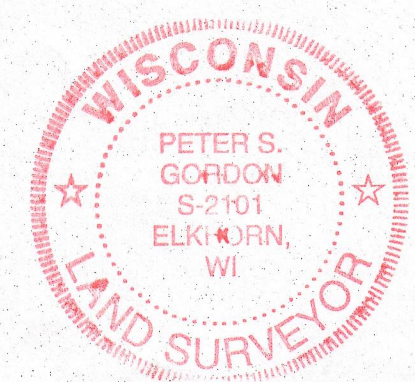

DATED: JAN. 2, 2002
Peter S. Gordon
PETER S. GORDON R.L.S. 2101

REVISED 10-07-2013
TO SHOW AS BUILT GARAGE &
PROPOSED ADDITIONS

WORK ORDERED BY:
DAVID ZIMMERMAN
430 FAIR OAKS DRIVE
WILLIAMS BAY, WI. 53191

FARRIS, HANSEN & ASSOCIATES, INC.
Engineering, Architecture, Surveying
7 Ridgeway Court P.O. Box 437
ELKHORN, WISCONSIN 53121
Office: (262) 723-2098
Fax: (262) 723-5886

REVISIONS	
PROJECT NO.	5948
DATE:	01-02-02
SHEET NO.	1 OF 1

HAPA - 1 416-2674