

Plat Of Survey


Property Address: W5245 Lauderdale Drive, Elkhorn, Wisconsin

Property Description: Lot 13 and the West 15 feet of Lot 14 in the FIRST ADDITION TO LAUDERDALE PARK, being a subdivision of part of the Southwest 1/4 of Section 25, Town 4 North, Range 16 East, Town of Lagrange, Walworth County, Wisconsin. Excepting therefrom a 20 foot wide roadway as described in Volume 641 at Pages 179 and 180, Walworth County records.

August 16, 2013



Prepared For: John Shemroske

Survey No. 13110

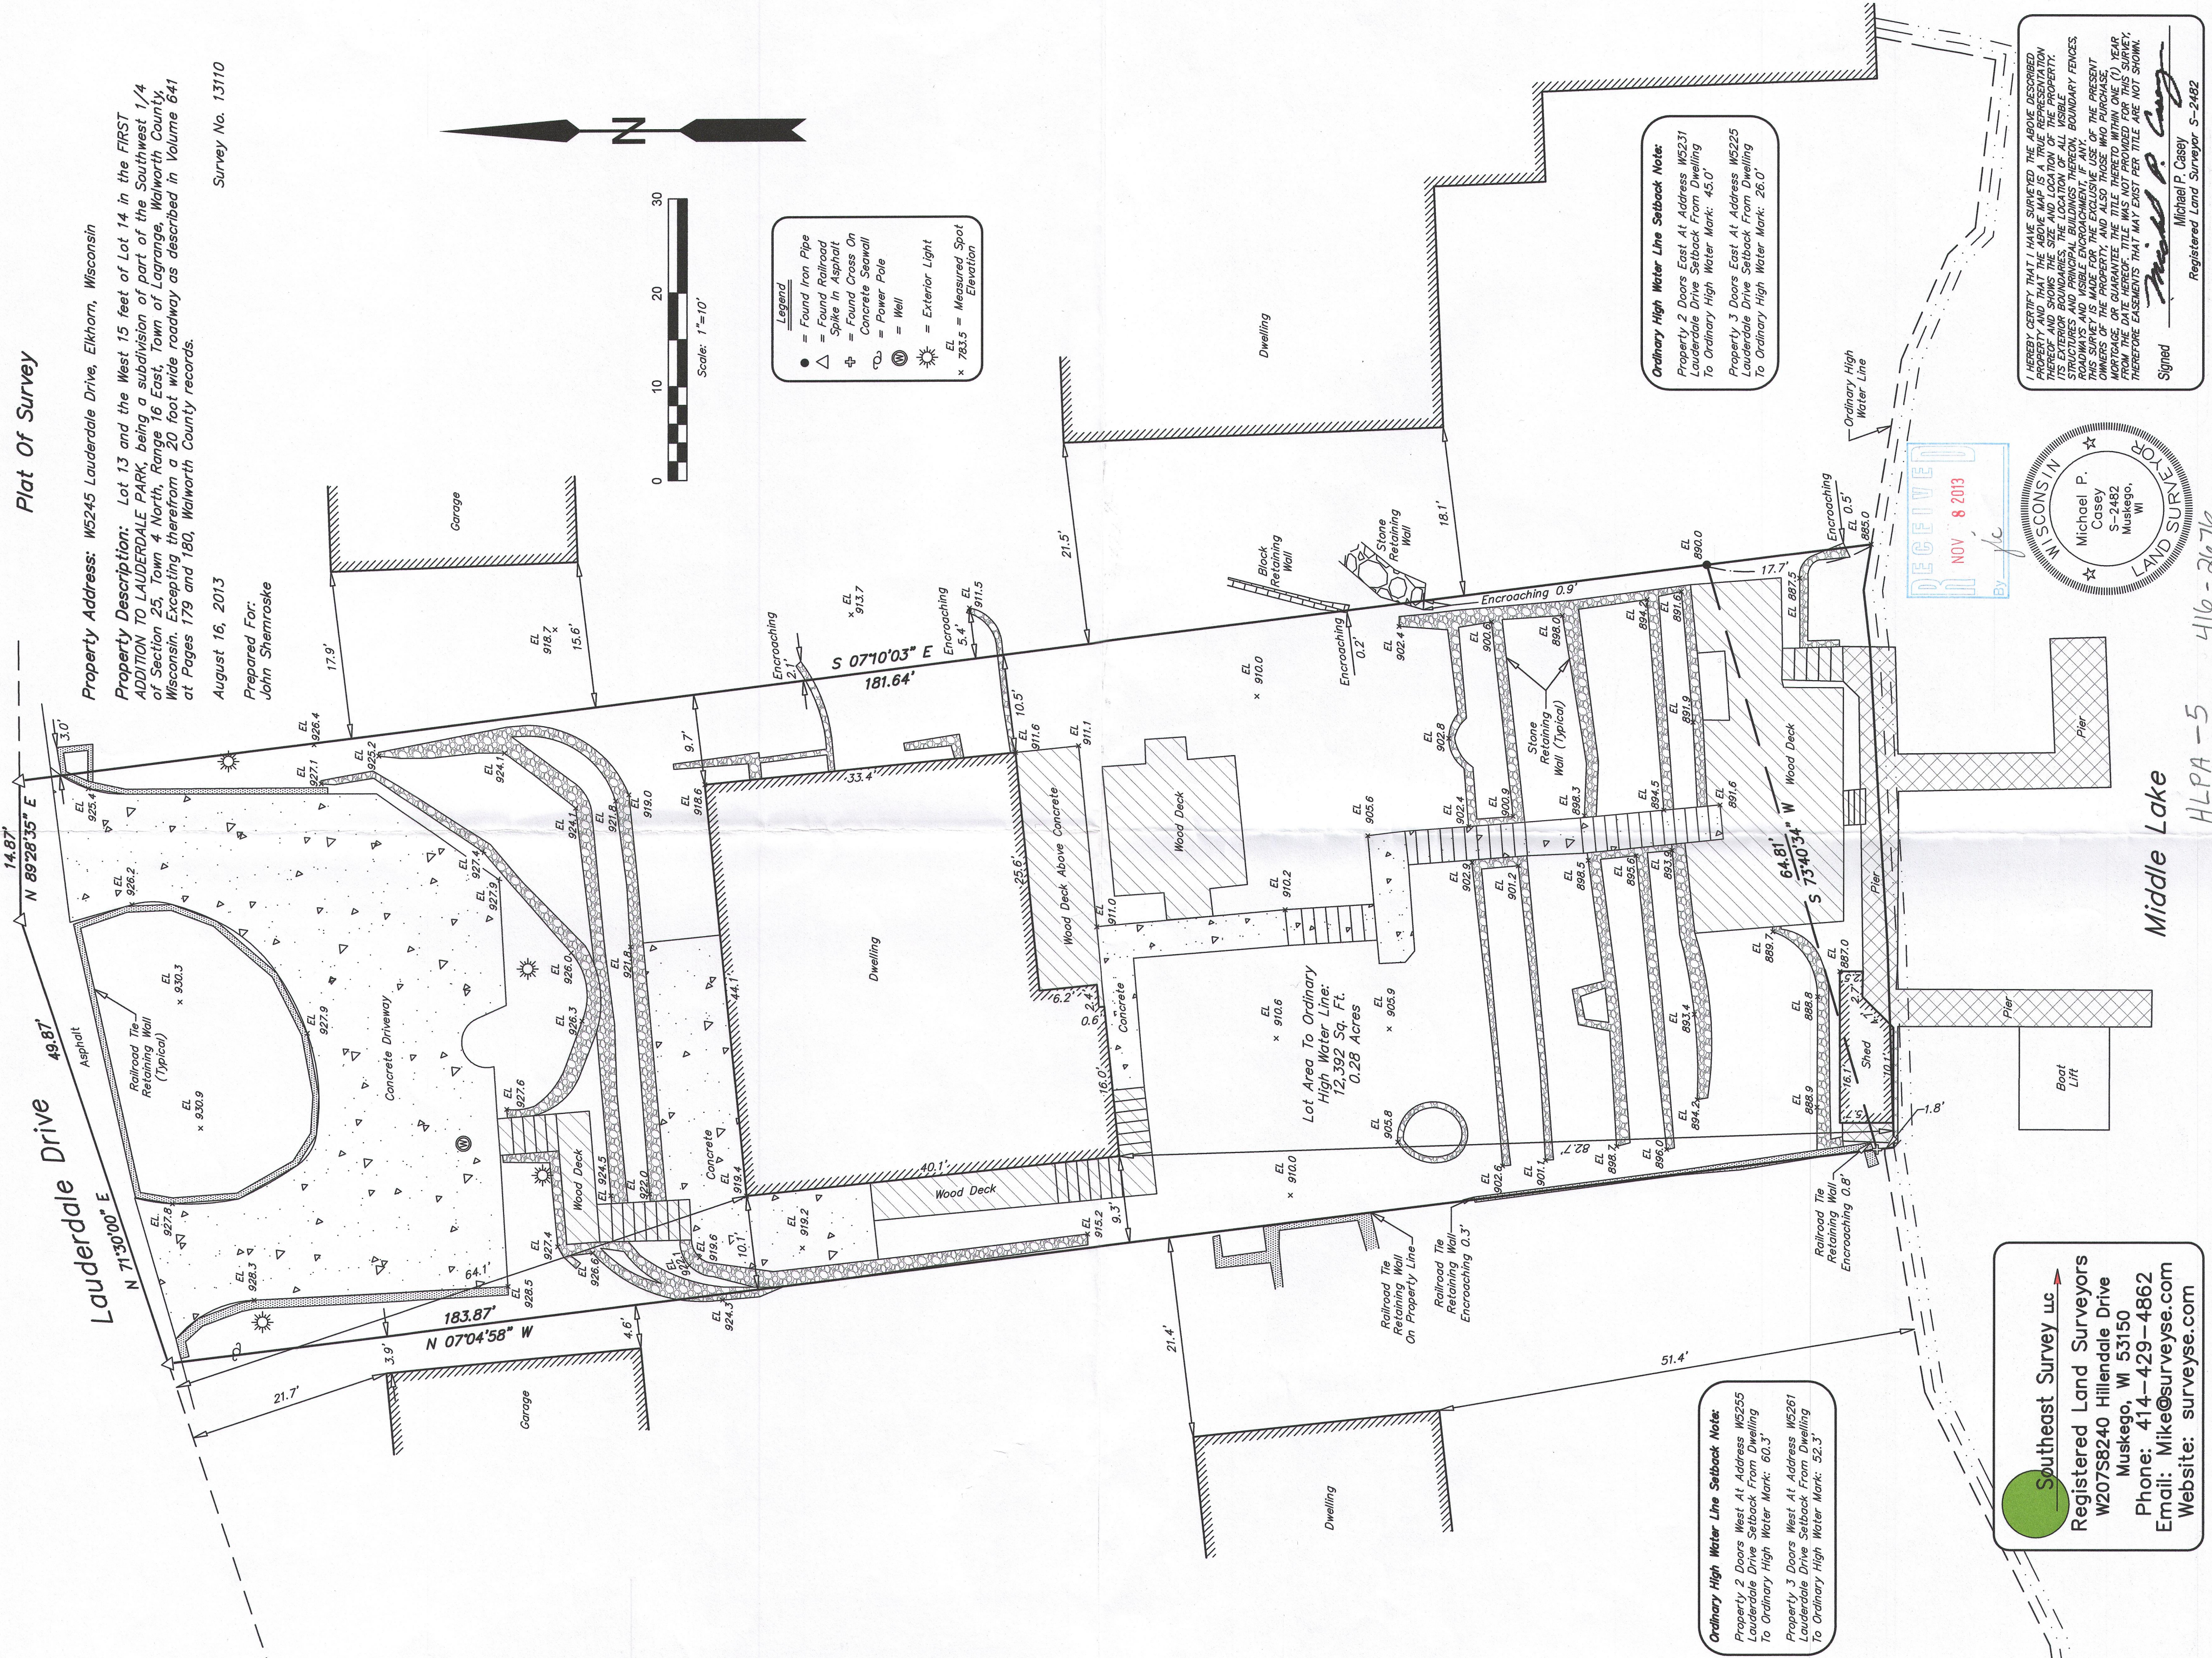

Ordinary High Water Line Setback Note:
Property 2 Doors East At Address W5231 Lauderdale Drive Setback From Dwelling To Ordinary High Water Mark: 45.0'
Property 3 Doors East At Address W5225 Lauderdale Drive Setback From Dwelling To Ordinary High Water Mark: 26.0'

Ordinary High Water Line Setback Note:
Property 2 Doors West At Address W5255 Lauderdale Drive Setback From Dwelling To Ordinary High Water Mark: 60.3'
Property 3 Doors West At Address W5261 Lauderdale Drive Setback From Dwelling To Ordinary High Water Mark: 52.3'

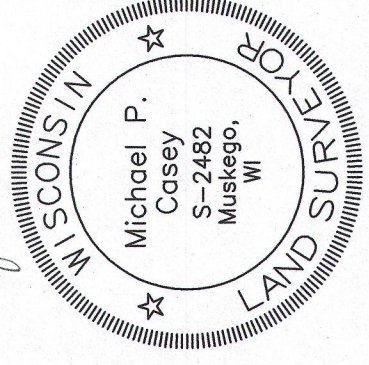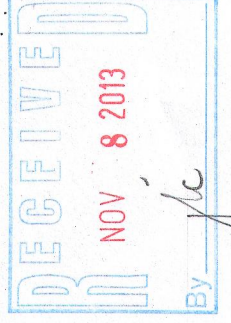

Southeast Survey LLC
Registered Land Surveyors
W207S8240 Hillendale Drive
Muskego, WI 53150
Phone: 414-429-4862
Email: Mike@surveyse.com
Website: surveyse.com

I HEREBY CERTIFY THAT I HAVE SURVEYED THE ABOVE DESCRIBED PROPERTY AND THAT THE ABOVE MAP IS A TRUE REPRESENTATION THEREOF AND SHOWS THE SIZE AND LOCATION OF THE PROPERTY, ITS EXTERIOR BOUNDARIES, THE LOCATION OF ALL VISIBLE EASEMENTS, ENCROACHMENTS, AND ALL VISIBLE BOUNDARY FEENCES, ROADS AND VISIBLE ENCROACHMENT, IF ANY.
THIS SURVEY IS MADE FOR THE EXCLUSIVE USE OF THE PRESENT OWNERS OF THE PROPERTY, AND ALSO THOSE WHO PURCHASE MORTGAGE OR GUARANTEE THE TITLE THEREIN WITHIN ONE (1) YEAR FROM THE DATE HEREOF. TITLE WAS NOT PROVIDED FOR THIS SURVEY, THEREFORE EASEMENTS THAT MAY EXIST PER TITLE ARE NOT SHOWN.

Signed: *Michael P. Casey*
Michael P. Casey
Registered Land Surveyor S-2482

Middle Lake

HLPA-5 416-2676