

Plat Of Survey

Property Address: W5498 West Shore Drive, Elkhorn, Wisconsin

Property Description: Lot 1, Block 1, GREEN LAKE PARK, being a subdivision located in the Southwest 1/4 of Section 26, Township 4 North, Range 16 East, Lagrange Township, Walworth County, Wisconsin.

September 30, 2013

Prepared For:
Jonny Krubert

Survey No. 13137

Legend

●

= Found Iron Pipe

⊕

= Found Concrete Mon. With Brass Cap




⊞

= Septic Manhole

⊗

= Concrete Deck Piers (Only Two That Are Closest To The Septic Area Are Shown)

= Overhead Wires

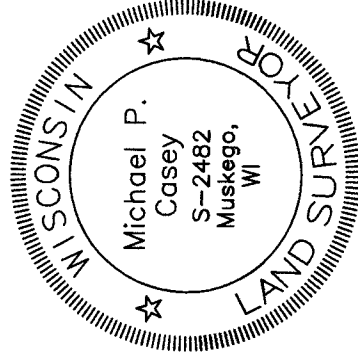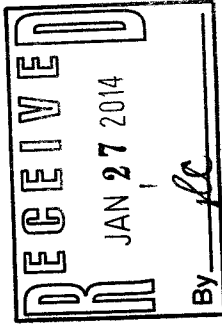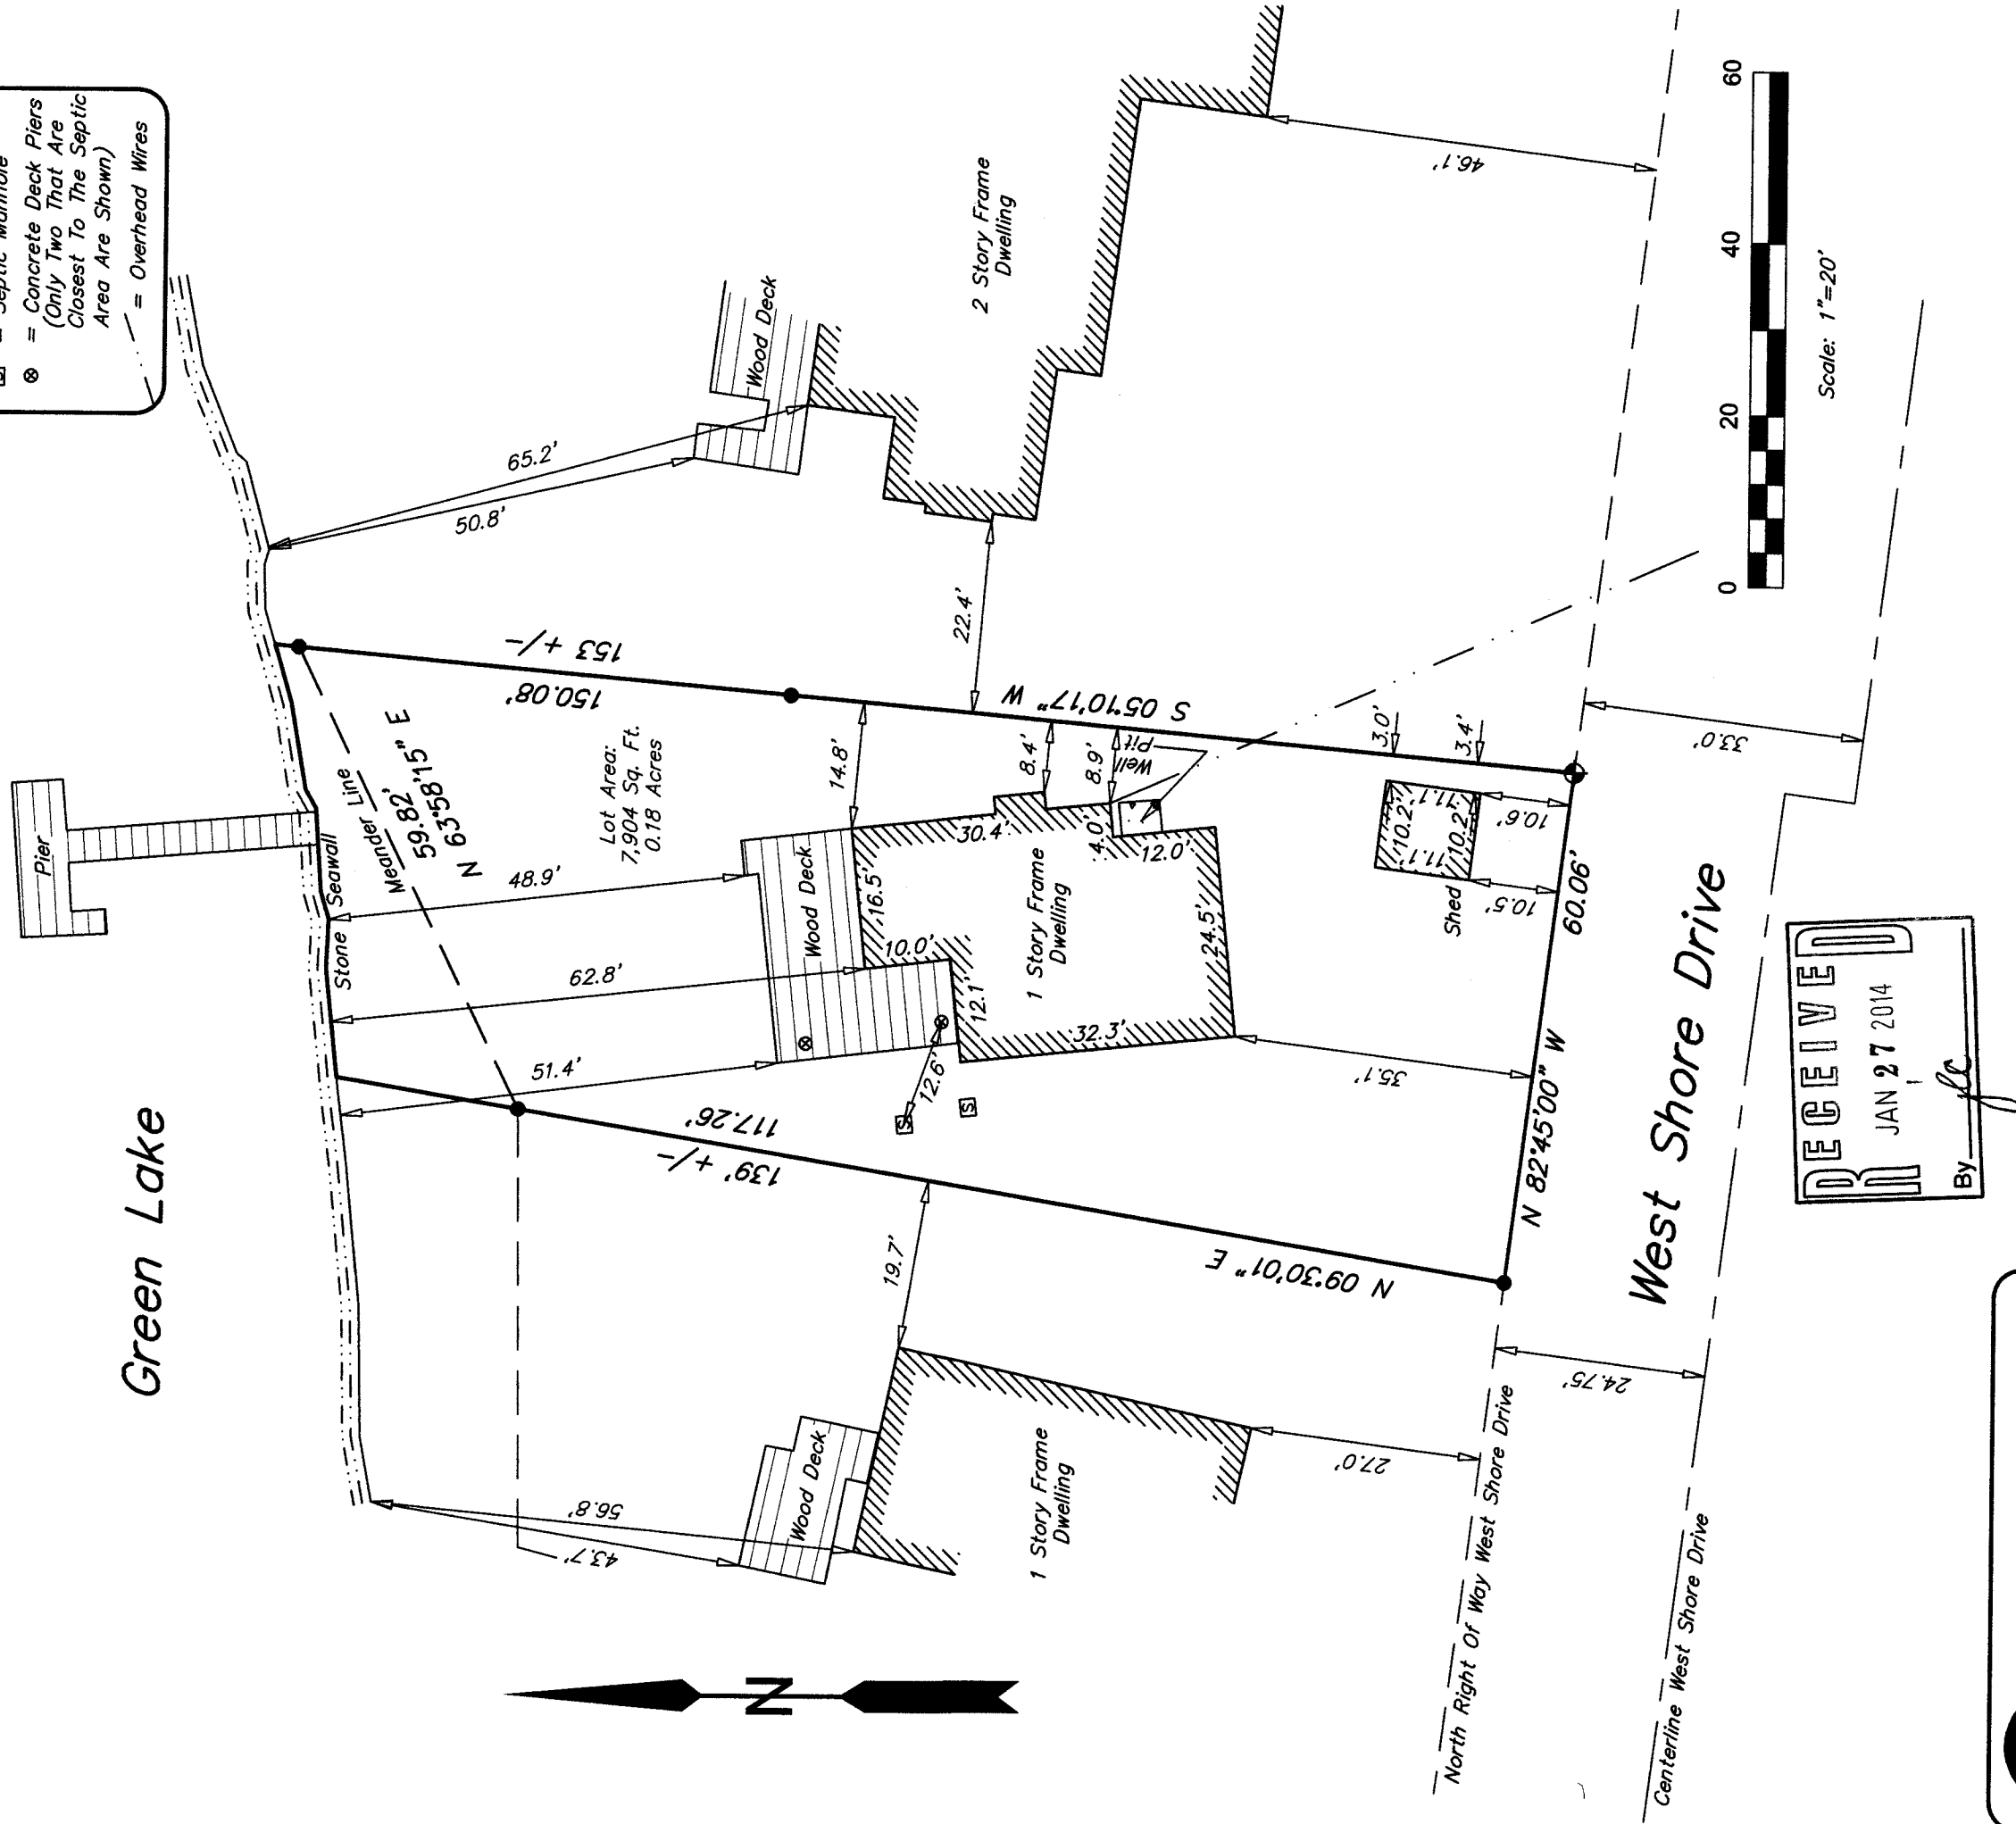

Southeast Survey LLC

Registered Land Surveyors
W207S8240 Hillendale Drive
Muskego, WI 53150
Phone: 414-429-4862
Email: Mike@surveyse.com
Website: surveyse.com

I HEREBY CERTIFY THAT I HAVE SURVEYED THE ABOVE DESCRIBED PROPERTY AND THAT THE ABOVE MAP IS A TRUE REPRESENTATION THEREOF AND SHOWS THE SIZE AND LOCATION OF THE PROPERTY, ITS EXTERIOR BOUNDARIES, THE LOCATION OF ALL VISIBLE STRUCTURES AND PRINCIPAL BUILDINGS THEREON, BOUNDARY FENCES, ROADWAYS AND VISIBLE ENCROACHMENT, IF ANY.
THIS SURVEY IS MADE FOR THE EXCLUSIVE USE OF THE PRESENT OWNERS OF THE PROPERTY, AND ALSO THOSE WHO PURCHASE, MORTGAGE, OR GUARANTEE THE TITLE THERETO WITHIN ONE (1) YEAR FROM THE DATE HEREOF. TITLE WAS NOT PROVIDED FOR THIS SURVEY, THEREFORE EASEMENTS THAT MAY EXIST PER TITLE ARE NOT SHOWN.

Signed

Michael P. Casey
Michael P. Casey
Registered Land Surveyor S-2482

HGP -1 416-2689