

A parcel of land described in Volume 192, Page 721 at the Walworth County Register of Deeds, being Lot 8 and Part of Lot 9 of LaSelva Subdivision, located in Section 26, T4N, R16E, Town of LaGrange, Walworth County, Wisconsin.

A parcel of land described in Volume 192, Page 721 at the Walworth County Register of Deeds, being Lot 8 and Part of Lot 9 of LaSelva Subdivision, located in Section 26, T4N, R16E, Town of LaGrange, Walworth County, Wisconsin.




Northerly line of Solid Comfort
Drive Assumed to Bear N62-15E
As Previously Platted.

SURVEYOR'S CERTIFICATE

I, William A. Shearman, Registered Land Surveyor, do hereby certify that the plat shown hereon is a true and accurate survey and a true representation thereof and the exterior boundary lines and all divisions of said property have been surveyed under my direction and to the best of my knowledge and belief.

William A. Shearman Dated this 27th day of Sept, 1977.
S-1378
Registered Land Surveyor

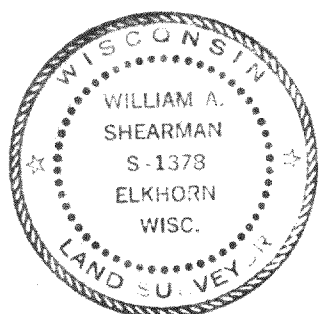

LEGEND

- - 3/4" x 24 Iron Rod weighing 1.50 lbs/lin. ft. set.
- o - Iron rod or pipe found (Size and Type Noted)

Surveyed for David Nordentoft

1658.212

416-269