

PLAT OF SURVEY

Parcel in Block 4, Green Lake Park Subdivision, located in the SE $\frac{1}{4}$ of the SW $\frac{1}{4}$ of Sec. 26, T4N, R16E, Town of LeGrange, Walworth County, Wisconsin.

Commencing at an angle point in the Easterly line of Lot 12 of Block 2, of the Green Lake Park Subdivision; thence S 74°-04' E, 50.50' to a point on the Easterly side of West Shore Drive; thence along the R.O.W. of said road, S 4°-30' W, along said R.O.W. 277.23'; thence S 10°-30' E, 26.88' along said R.O.W.; thence S 14°-00' E, 27.50' to the point of beginning; thence S 39°-18'-20" E, 24.75' along said R.O.W.; thence S 48°-36'-57" E, 28.63' along said R.O.W.; thence S 66°-02'-42" E, 27.52' along said R.O.W.; thence N 58°-22' E, 140.00'; thence N 58°-23' W, 30.00'; thence S 75°-38'-02" W, 160.93' to the point of beginning.


Parcel contains 0.167 acres more or less.

LEGEND

- - IRON PIPE FOUND (size noted).
- - 3/4" IRON ROD FOUND.
- - 1"x 24" IRON PIPE WEIGHING 1.13 LBS/LIN FOOT SET.

SCALE: 1" = 20'


Bearings referenced to the southerly line of parcel assumed N58°-22'E.

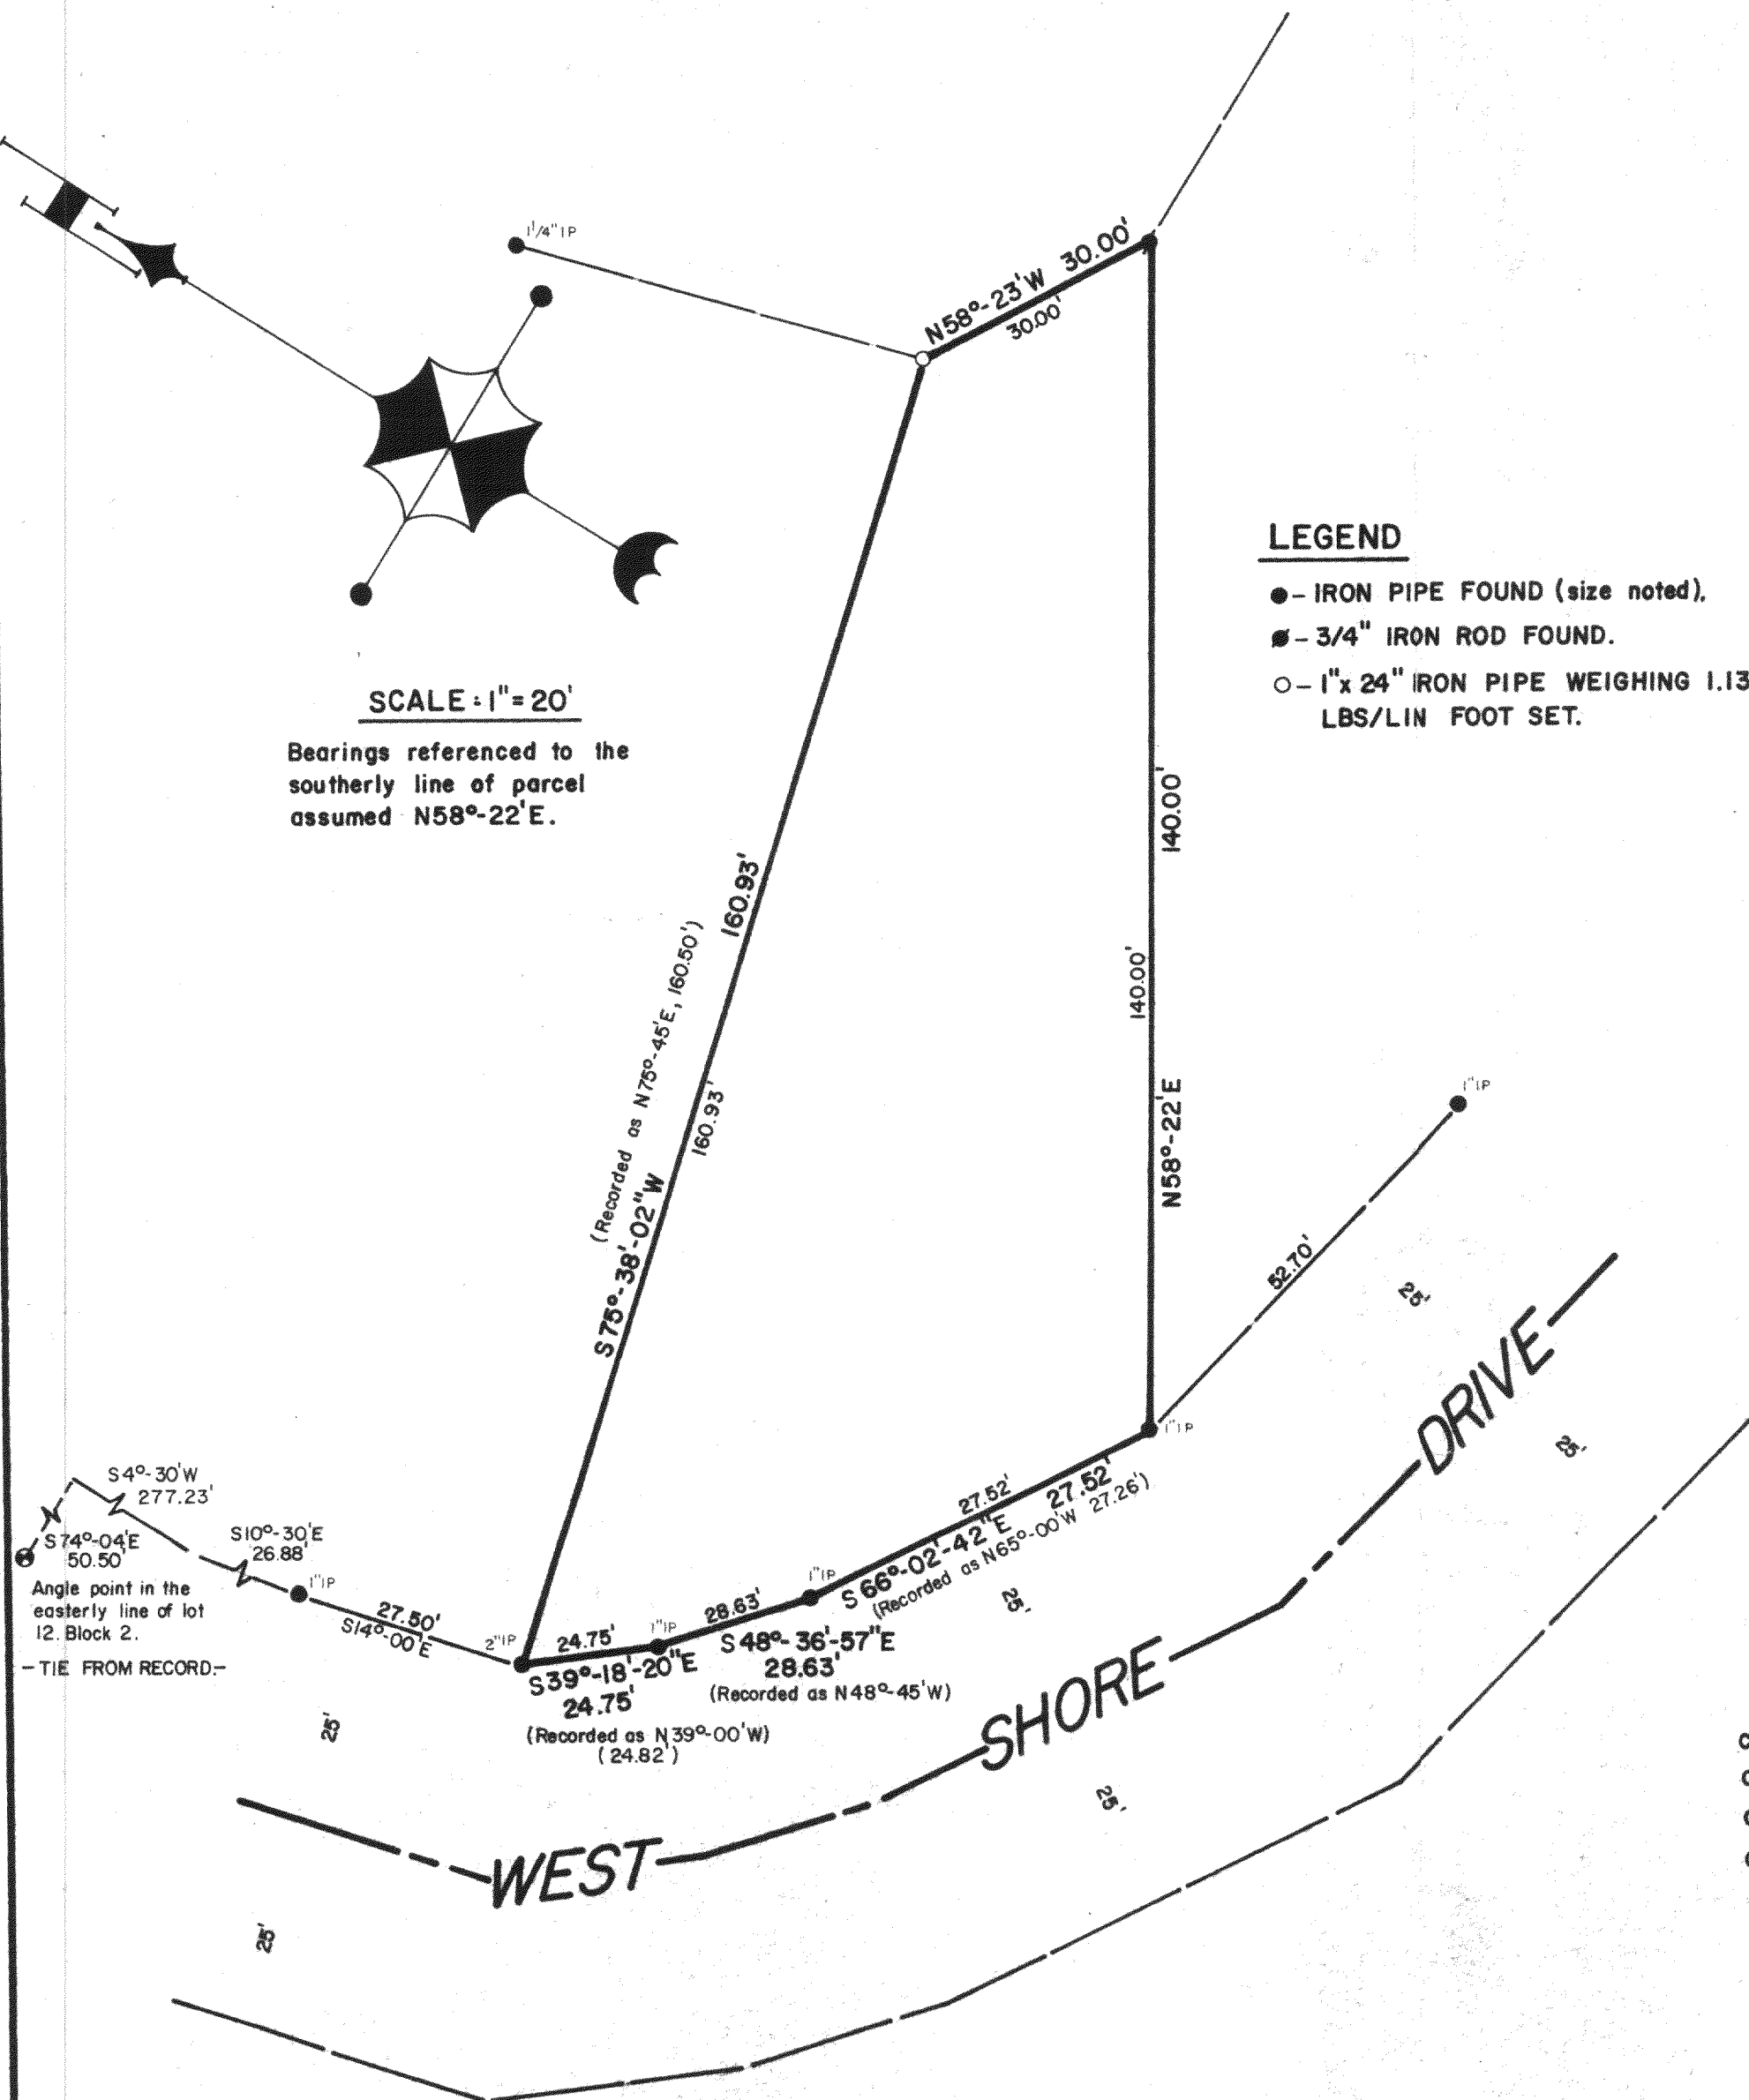

I, William A. Shearman Registered Land Surveyor do hereby certify that the plat shown hereon is a true and accurate survey and a true representation thereof and the exterior boundary lines and all divisions of said property have been surveyed under my direction and to the best of my knowledge and belief.

William A. Shearman
William A. Shearman S-1378
Registered Land Surveyor

Dated this 19th day of April 1977.

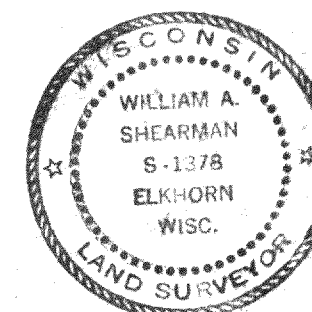

Jensen & Johnson
Engineers & Surveyors
Elkhorn, Wisc.
414-723-3204