


PLAT OF SURVEY & TOPOGRAPHIC MAPPING
LOT 34 OF FROEDTERTS GREEN LAKE PARK

LOCATED IN PART OF SECTION 26, TOWN 4 NORTH, RANGE 16 EAST,
WALWORTH COUNTY, WISCONSIN

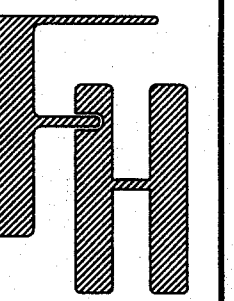

— WORK ORDERED BY —
SOUTHERN LAKES PLUMBING & HEATING, INC.
N5860 US HWY 12
ELKHORN, WI 53121

FARRIS, HANSEN & ASSOCIATES, INC.
ENGINEERING — ARCHITECTURE — SURVEYING
7 RIDGWAY COURT P.O. BOX 437
ELKHORN, WISCONSIN 53121
OFFICE: (262) 723-2098 FAX: (262) 723-5886

REVISIONS

PROJECT NO.
9086
DATE
07/23/2014
SHEET NO.
1 OF 1

SHORE YARD AVERAGING

H LG2600007B: 63'
H LG2600007A1: 80'
H LG2600007C: 70'
HFP 00026: 62'
HFP 00024: 47'
HFP 00023: 34'
HFP 00022: 59'
HFP 00019: 50'
TOTAL: 465'
 $465' / 8 = 58.13'$



- LEGEND
- = FOUND IRON PIPE STAKE
 - = FOUND PIN IN BRICK PATIO
 - ⊕ = FOUND NAIL IN CONCRETE SEAWALL
 - ⊙ = UTILITY POLE LOCATED
 - — — = OVERHEAD WIRES LOCATED
 - {XXX} = RECORDED AS

NOTE: COPIES OF THIS MAP TO WHICH THE FOLLOWING CERTIFICATE WILL APPLY SHOW THE SURVEYOR'S ORIGINAL SEAL AND SIGNATURE IN RED INK. COPIES BY ANY OTHER MEANS MAY HAVE ALTERATIONS WHICH DO NOT REPRESENT THE SURVEYOR'S WORK PRODUCT.

I HEREBY CERTIFY THAT THE ABOVE DESCRIBED PROPERTY HAS BEEN SURVEYED UNDER MY DIRECTION AND THAT THE ABOVE MAP IS A TRUE REPRESENTATION THEREOF AND SHOWS THE SIZE AND LOCATION OF THE PROPERTY AND ITS EXTERIOR BOUNDARIES. THIS SURVEY IS MADE FOR THE USE OF THE PRESENT OWNERS OF THE PROPERTY, AND ALSO THOSE WHO PURCHASE, MORTGAGE, OR GUARANTEE THE TITLE THERETO WITHIN ONE YEAR FROM THE DATE HEREOF.


DATED: 7/23/2014

PETER S. GORDON R.L.S. 2101

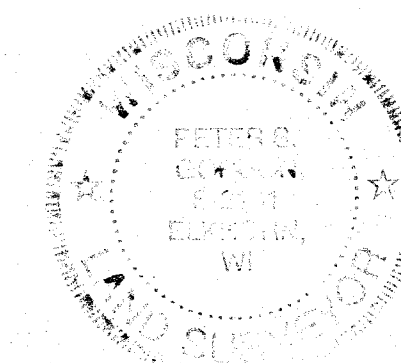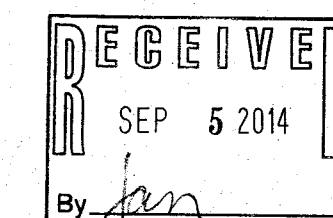

HFP-25

416-2729

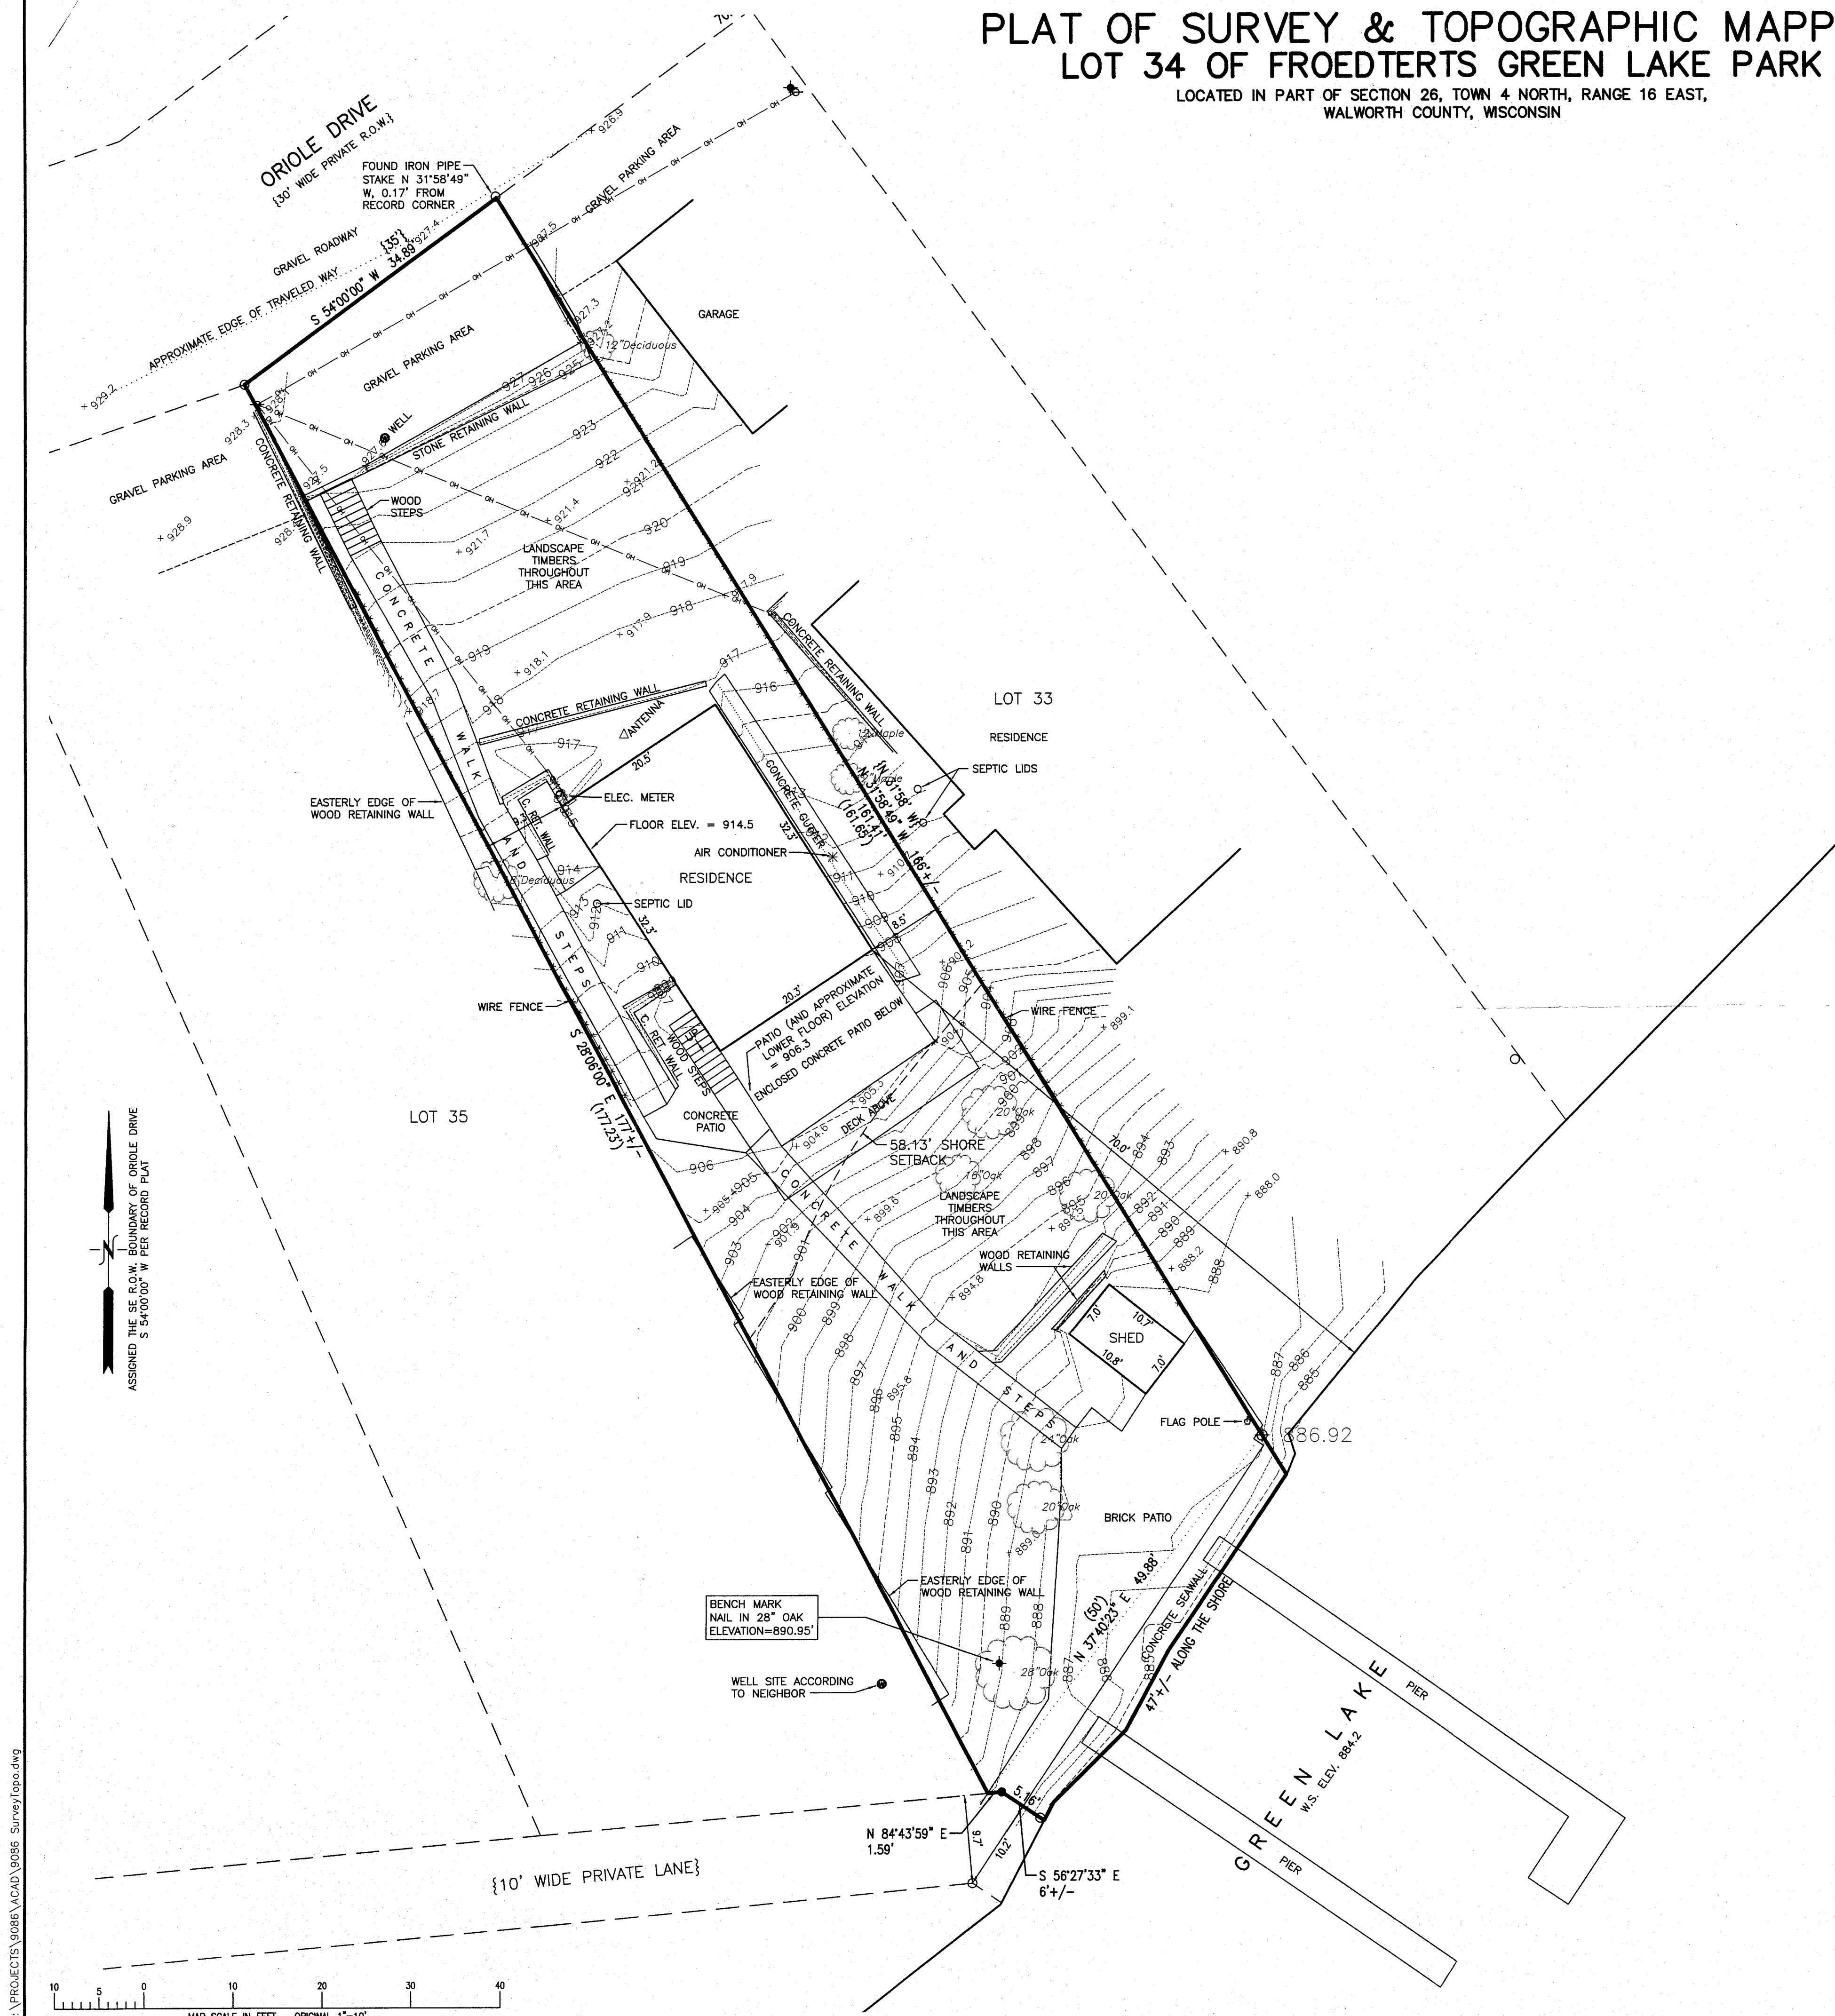

JUL 24 2014