
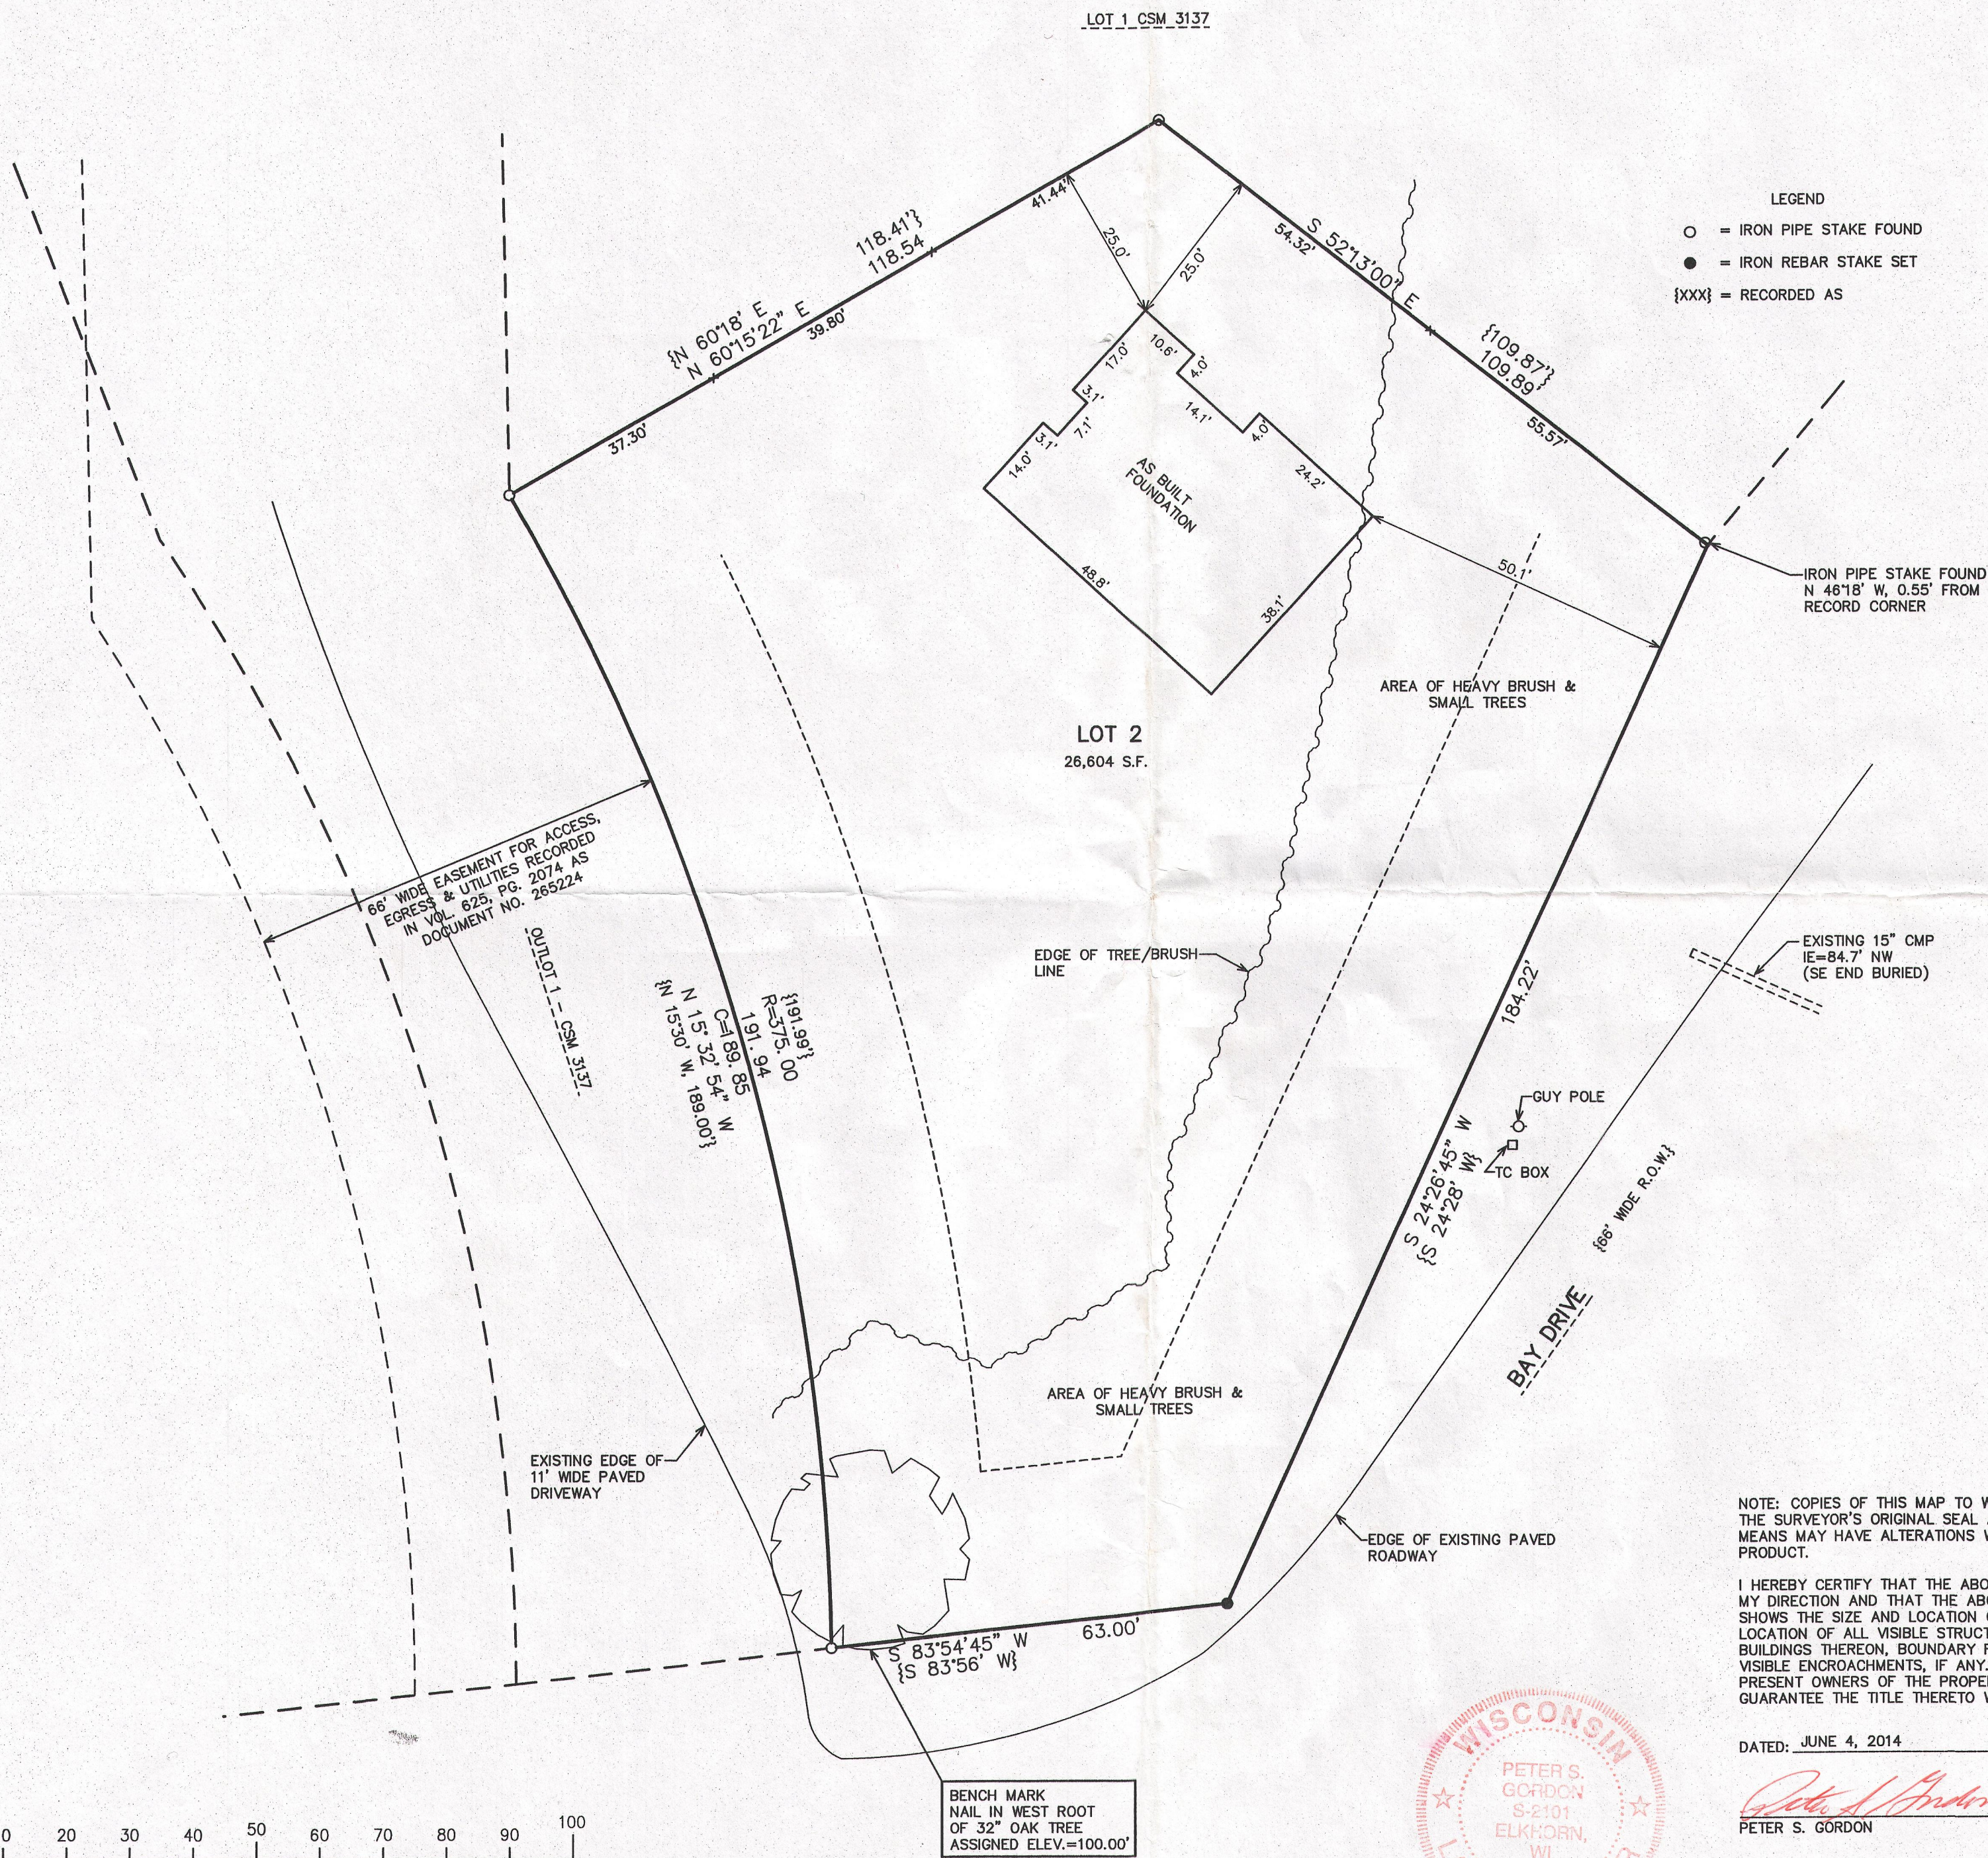
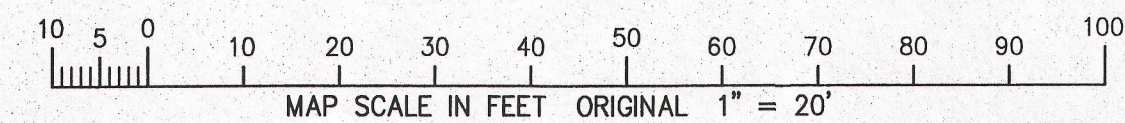


JAN 07 2015

1/7/2015 X:\Projects\1955\1955_14\Drawn\ASBUILT

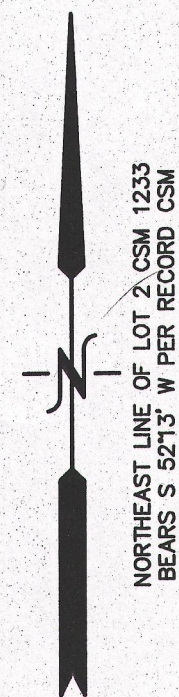

PLAT OF SURVEY

LOT 2 OF CERTIFIED SURVEY MAP NO. 1233
LOCATED IN PART OF THE SE 1/4 OF SECTION 34, TOWN 4 NORTH,
RANGE 16 EAST, WALWORTH COUNTY, WISCONSIN

- LEGEND
- = IRON PIPE STAKE FOUND
 - = IRON REBAR STAKE SET
 - {xxx} = RECORDED AS

WORK ORDERED BY -
CINDY ALCOCK-ZINAVEAH
PO BOX 633
ANTIOCH, IL 60002

FARRIS, HANSEN & ASSOCIATES, INC.
ENGINEERING - ARCHITECTURE - SURVEYING
7 RIDGWAY COURT P.O. BOX 437
ELKHORN, WISCONSIN 53121
OFFICE: (262) 723-2098 FAX: (262) 723-5886

REVISIONS

PROJECT NO.
1955.14
DATE:
6/3/2014
SHEET NO.
1 OF 1

HA1233-2 416-2748