
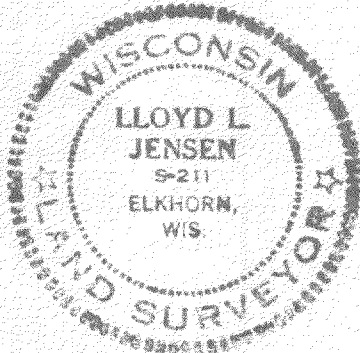


PLAT OF SURVEY

OF

LOT 12 - FROEDTER'S GREEN LAKE PARK
NW 1/4 SECTION 26 T4N-R16E
WALNORTH COUNTY, WISCONSIN

BLUE JAY DRIVE

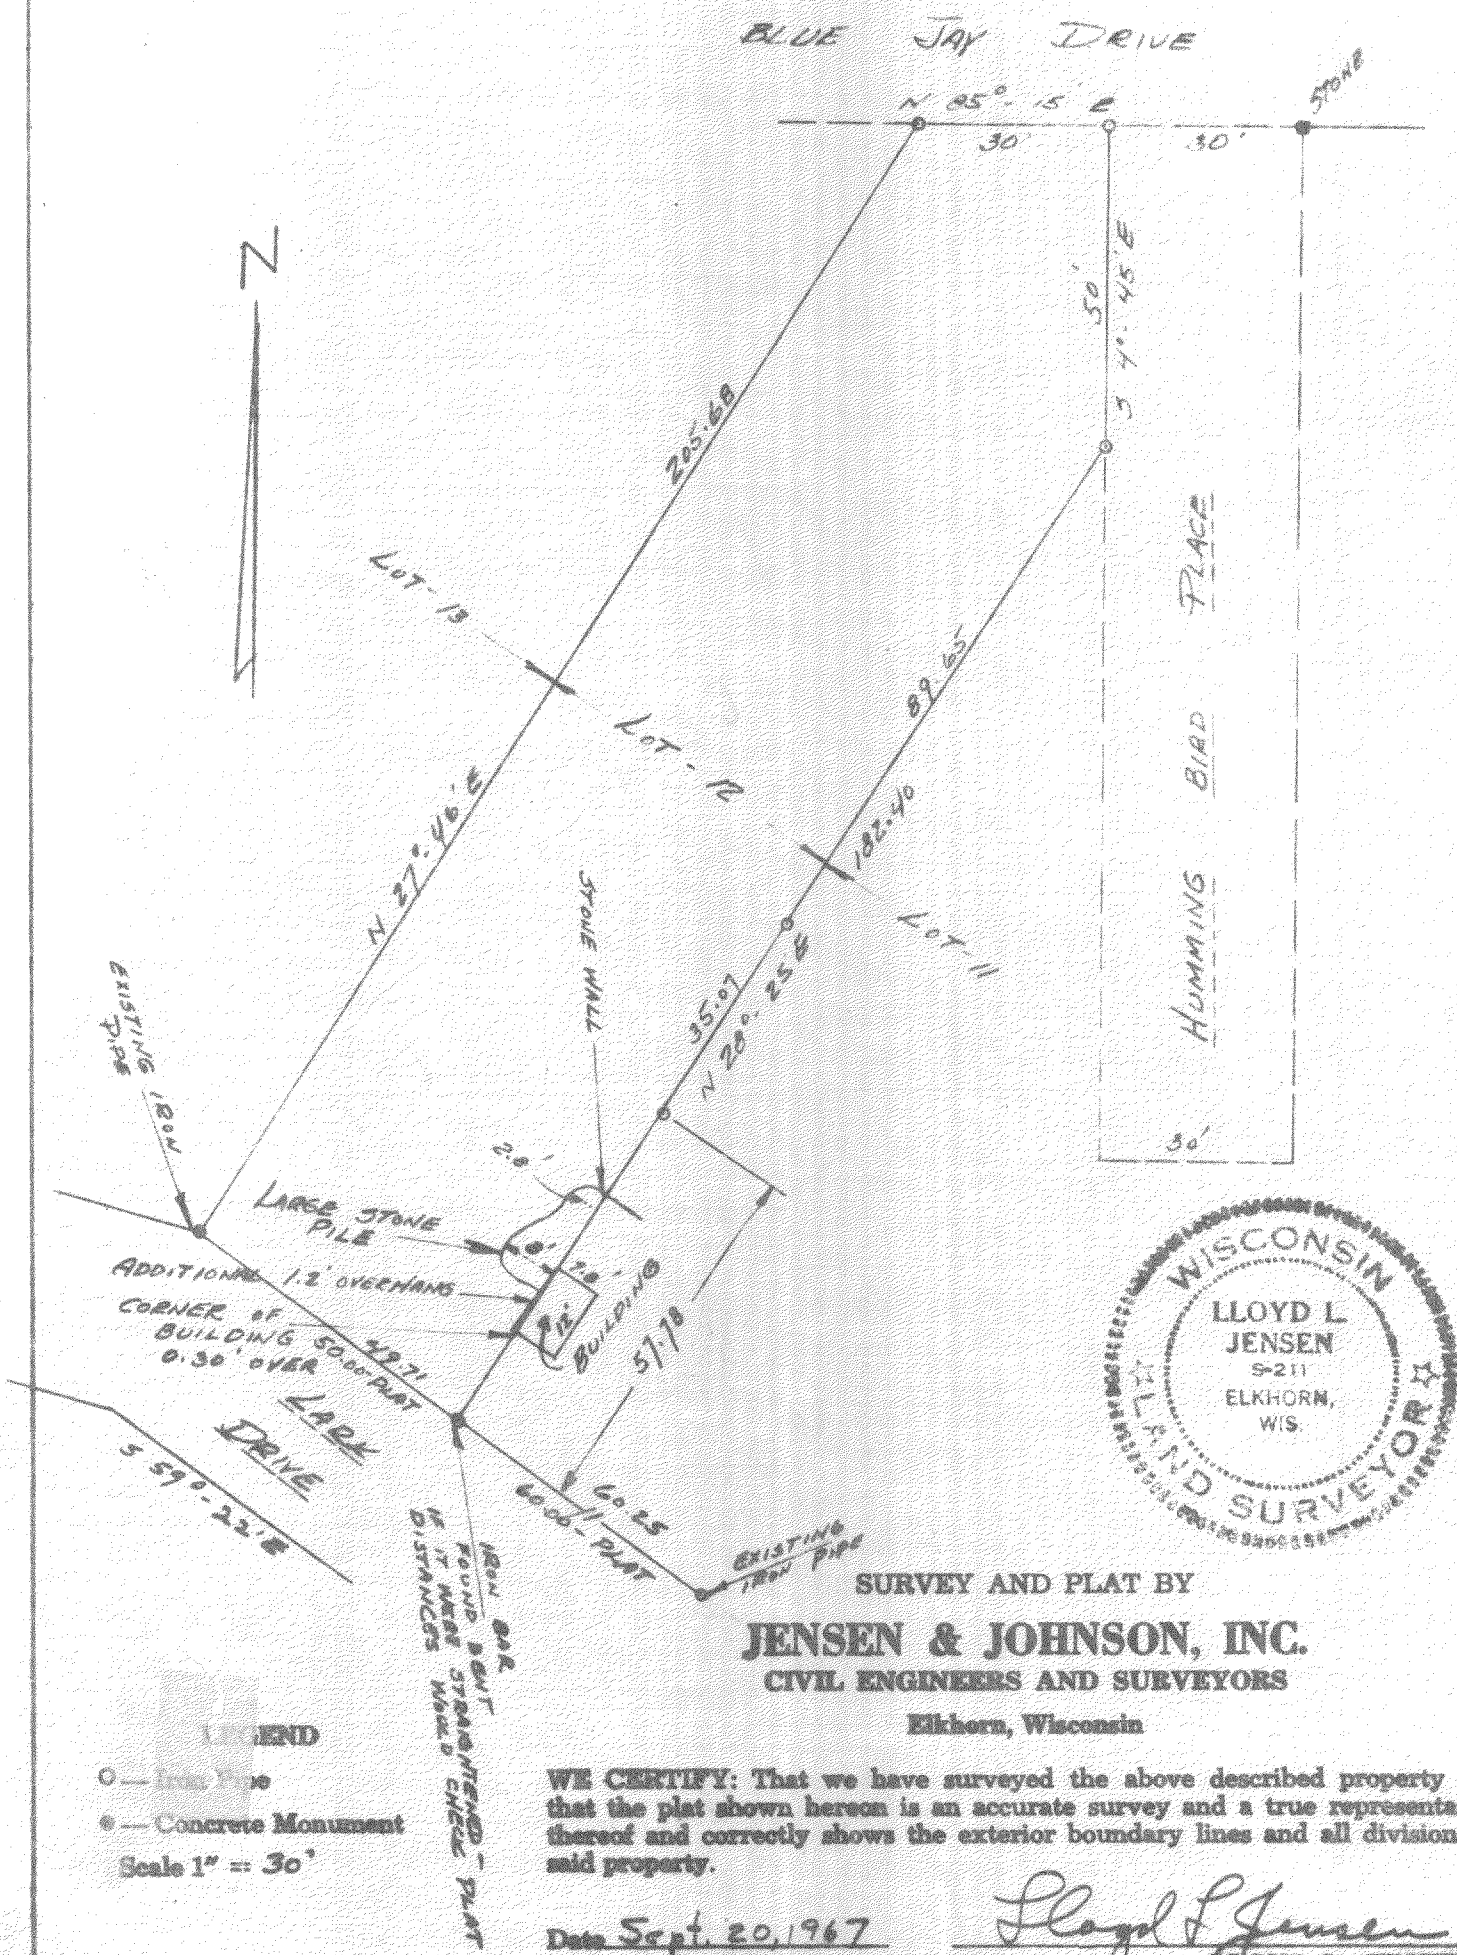

SURVEY AND PLAT BY
JENSEN & JOHNSON, INC.
CIVIL ENGINEERS AND SURVEYORS
Elkhorn, Wisconsin

WE CERTIFY: That we have surveyed the above described property and that the plat shown hereon is an accurate survey and a true representation thereof and correctly shows the exterior boundary lines and all divisions of said property.

Date Sept. 20, 1967

Lloyd L. Jensen
LLOYD L. JENSEN,

Wisconsin Registered Land Surveyor, No. S-211

HFP-9
GHP-9

416-275J