


GEORGE T. DUNHAM
SURVEYING & SUBDIVIDING
DELAVAN, WISCONSIN

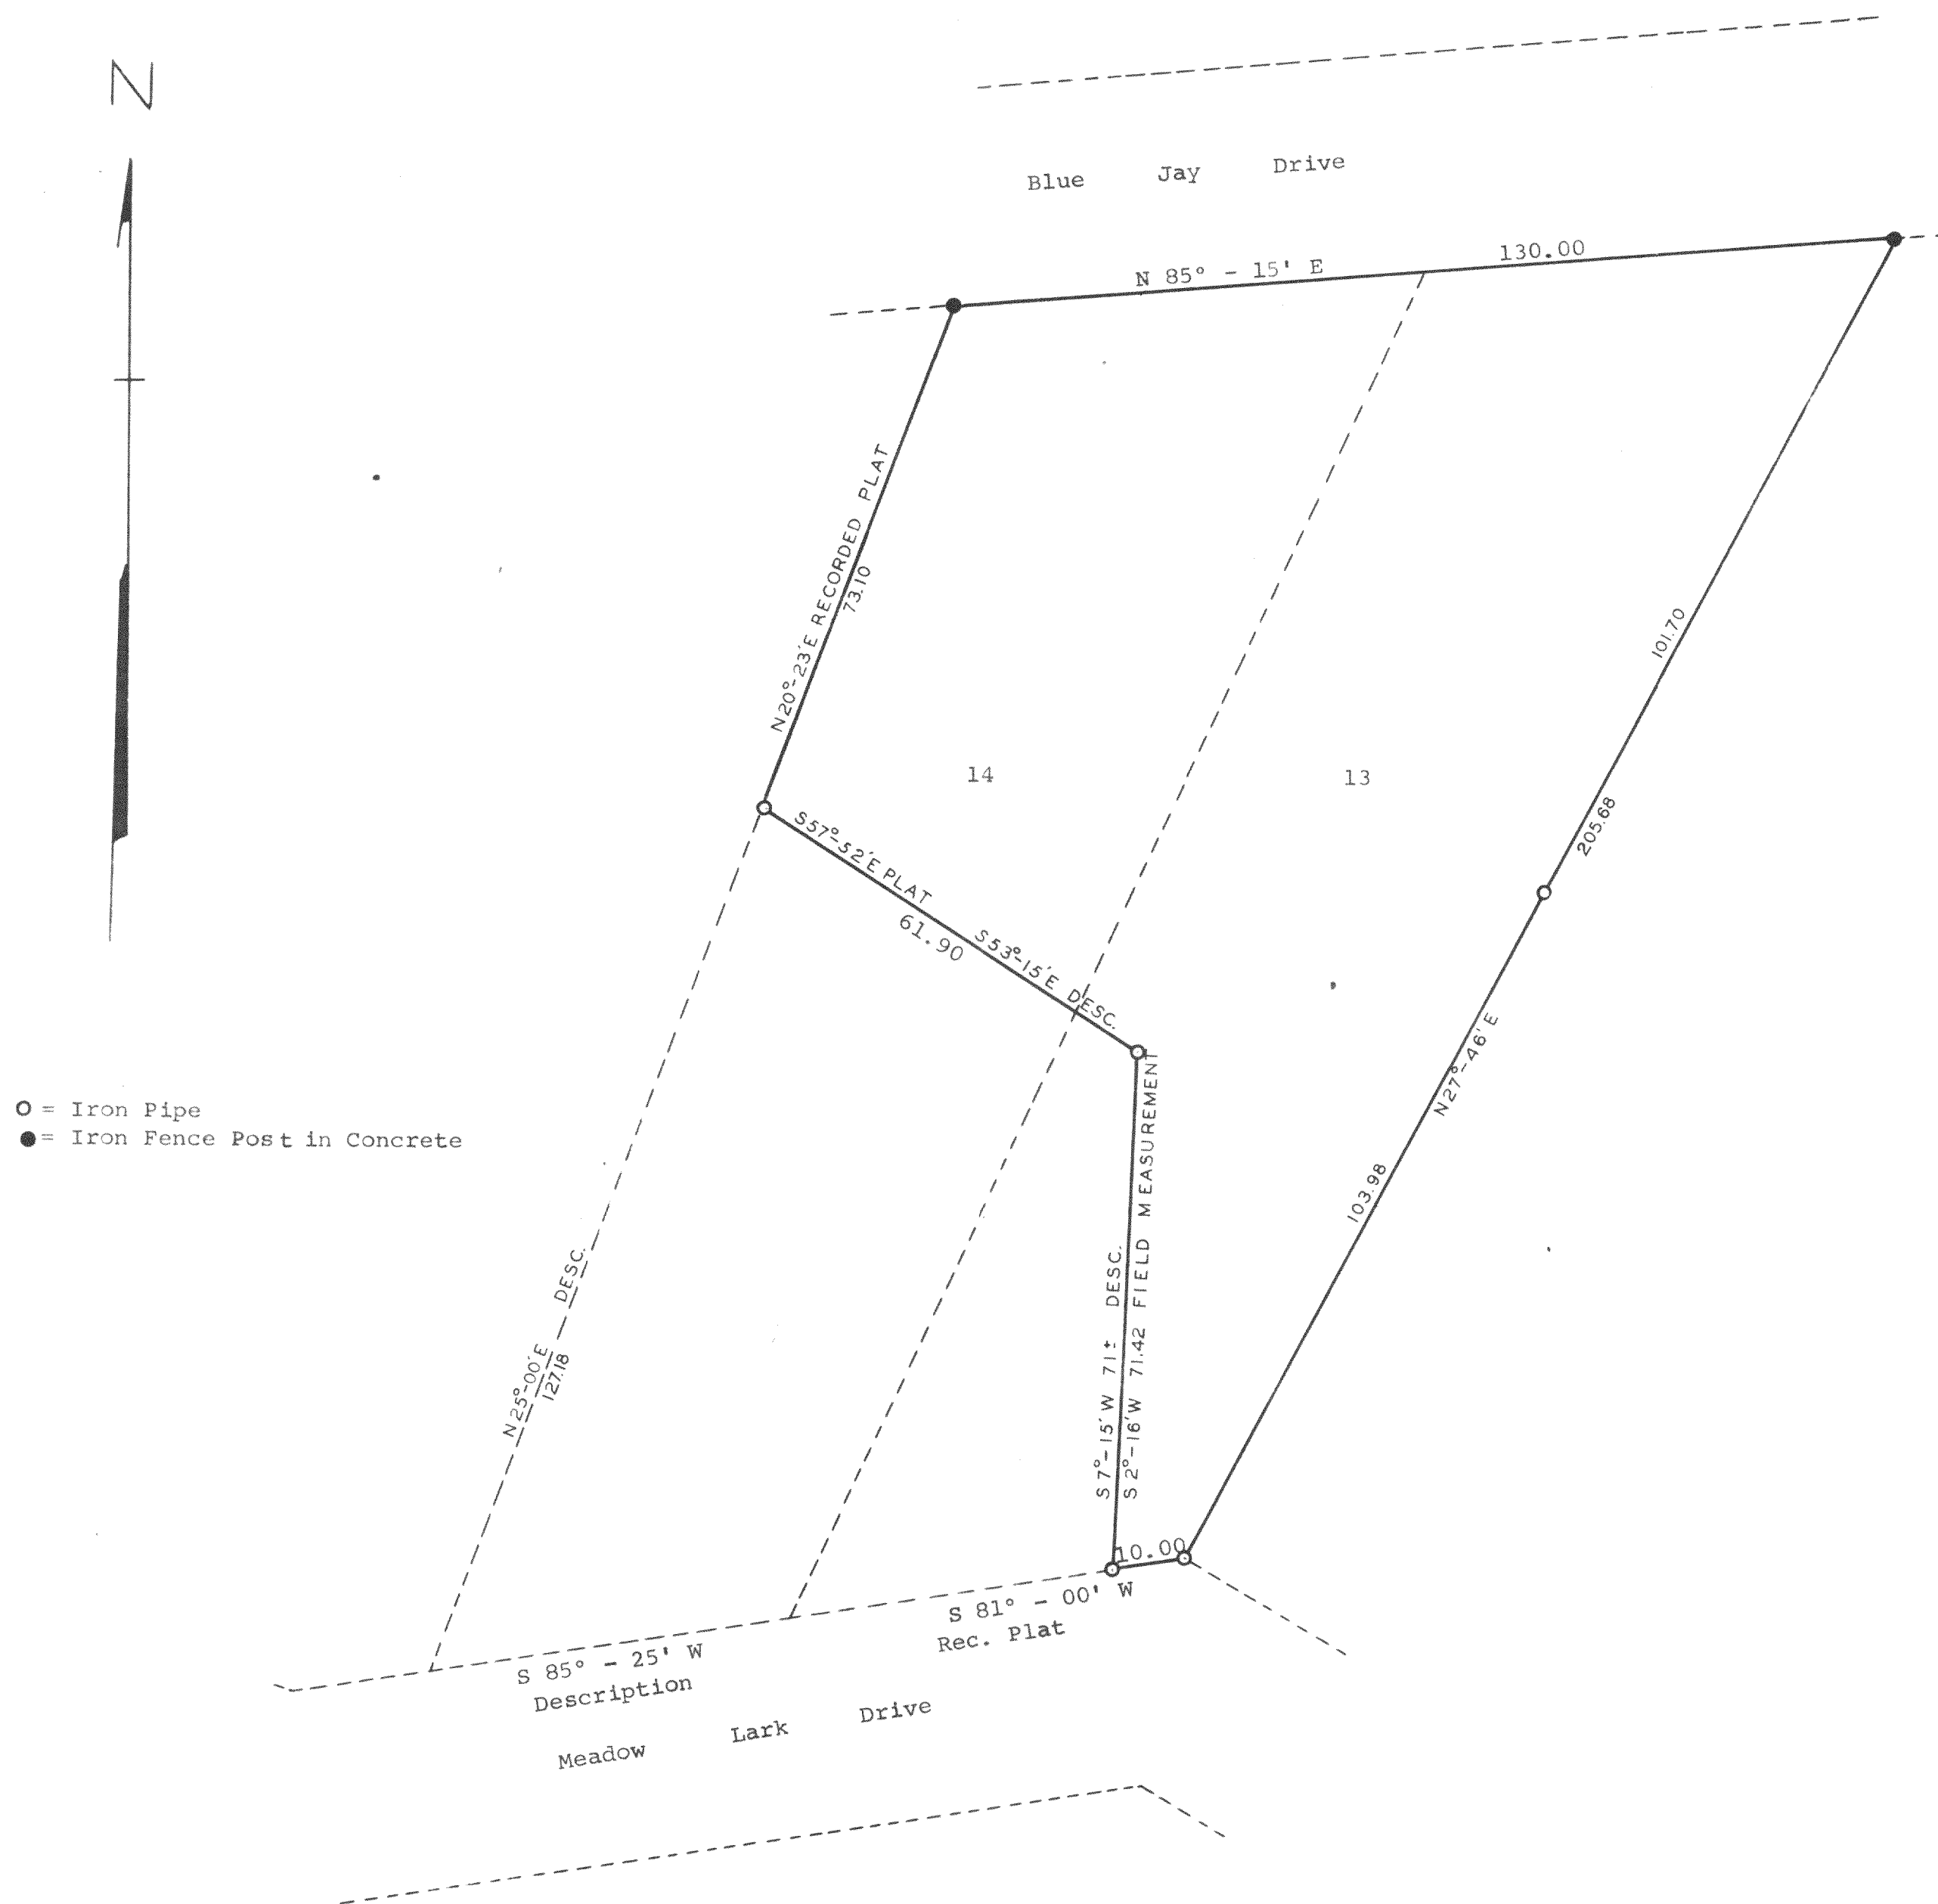

Plat of survey of part of Lots 13 & 14 in Froedert's Green Lake Park located in the NW $\frac{1}{4}$ of Section 26, T 4 N R 16 E of Walworth County, Wisconsin
August, 1963

George T. Dunham
George T. Dunham, Surveyor