

FARRIS, HANSEN & COOPER, INC.  
ENGINEERING, SURVEYING AND LAND PLANNING  
715 W. WALWORTH ST. - P.O. BOX 487 - ELKHORN, WI 53121

PLAT OF SURVEY OF

Part of Lots 10 and 11, La Selva sub-division, Section 26, Town 4 North, Range 16 East, Town of LaGrange, Walworth County, Wisconsin.

EXISTING DESCRIPTION: Begin at the Northeast corner of Lot 10; thence Southwesterly along the shore 10 feet; thence Southeast to a point 15 feet Southwest of the East corner of Lot 10; thence Northeast along the lot lines of Lots 10 and 11--42 feet; thence Northwesterly to the shore; thence Southwesterly along said shore 12 feet to the place of beginning.



ORDERED BY: Mrs. Angie Stenstrom  
Colony Realty

OWNER: Peter Palmer

I HEREBY CERTIFY that I have surveyed the lands described hereon and that this Plat of Survey is a true and accurate representation of the lot lines and building thereon to the best of my professional knowledge and belief.

*Robert A. Farris*  
Robert A. Farris, RLS No. 1293  
Dated this 29 day of May 1979. SCALE IN FEET  
1"=20'

MAGNETIC NORTH

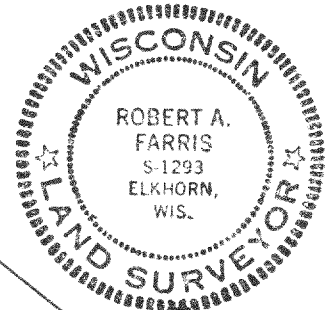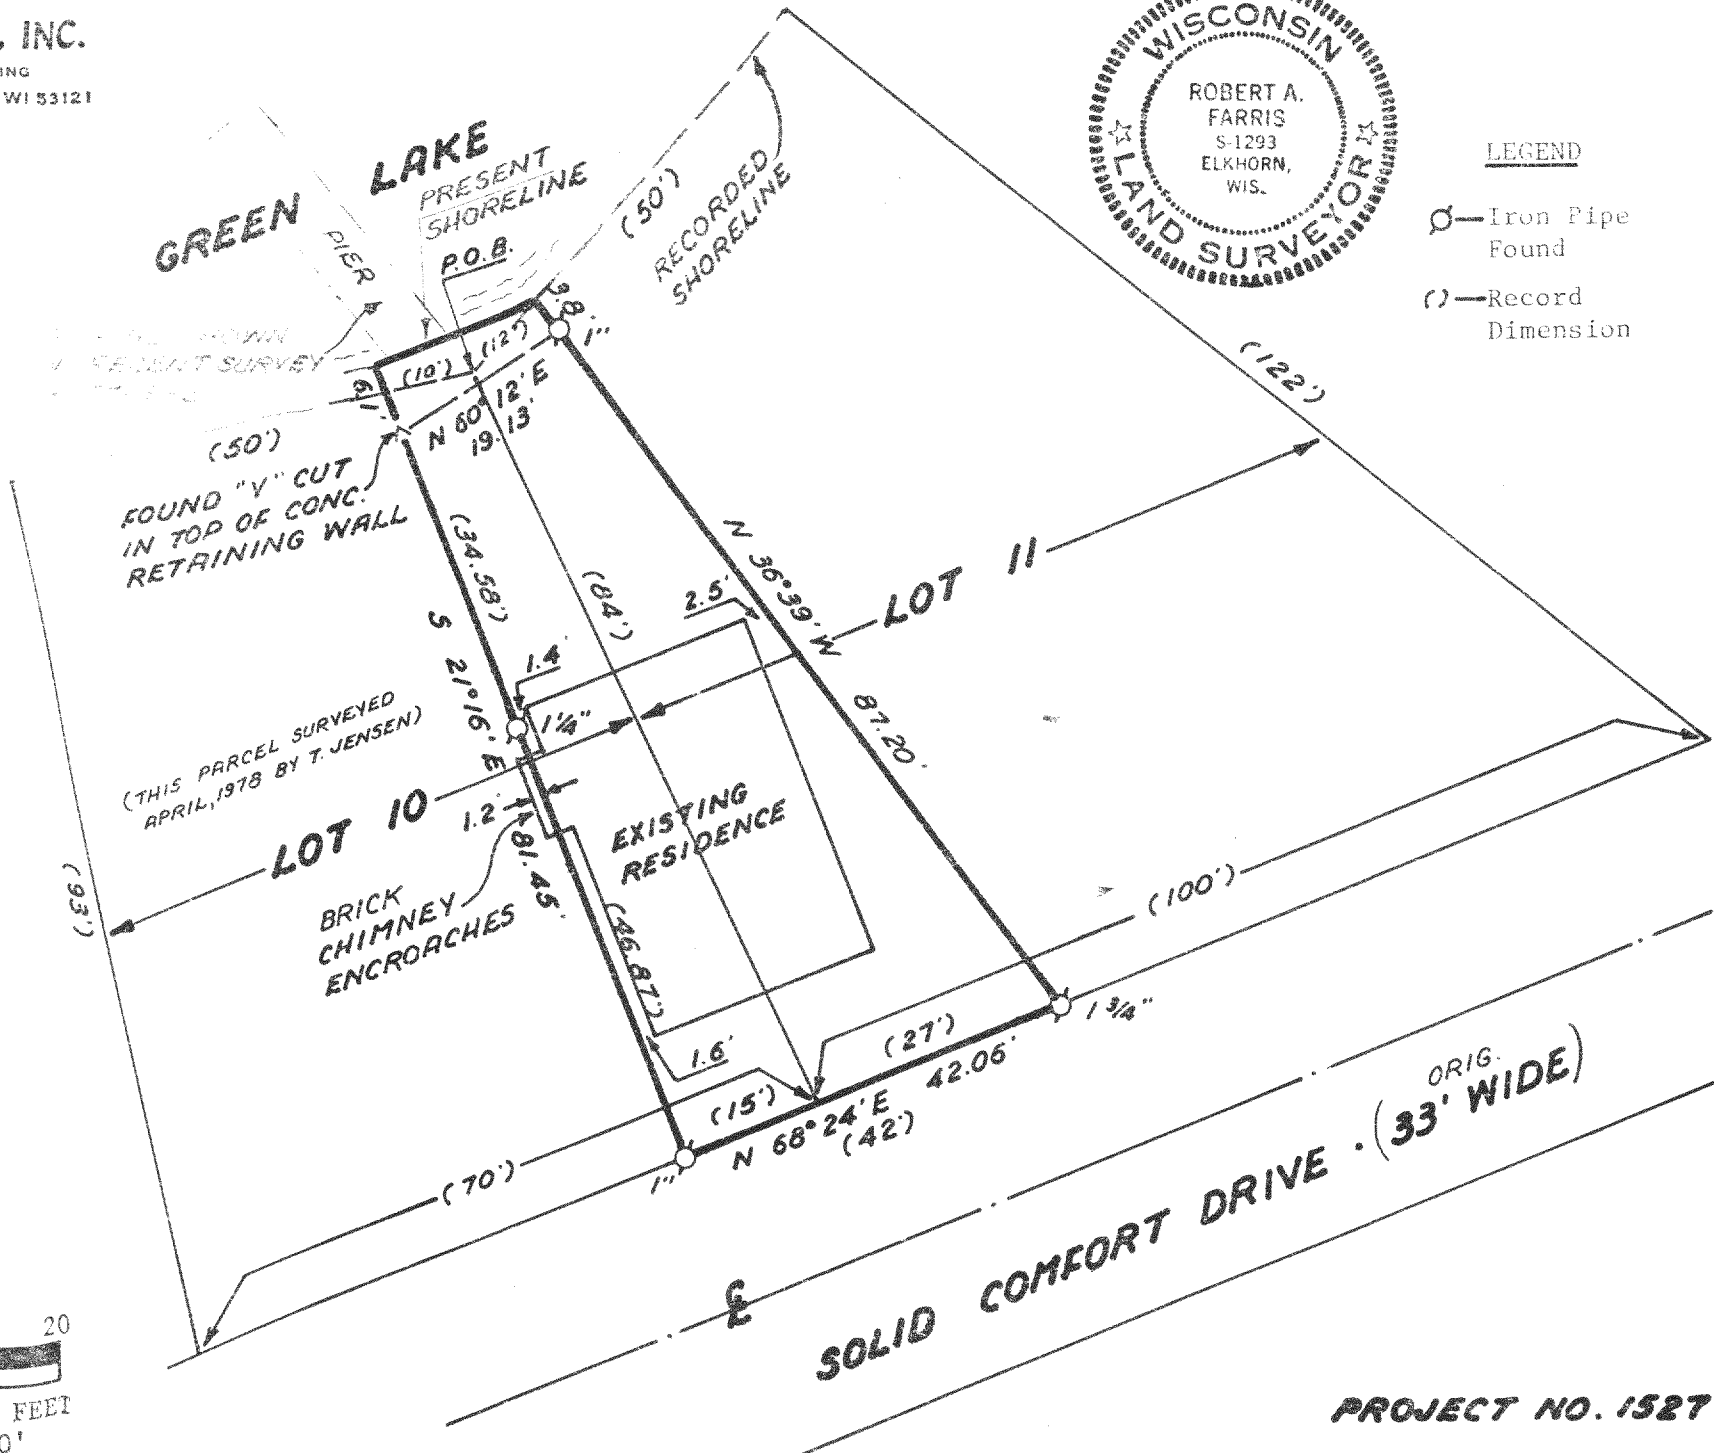

LEGEND  
Ø—Iron Pipe Found  
( )—Record Dimension

PROJECT NO. 1527

HL-8

416-281FV