


Work Ordered by: *Greenwald Builders Inc.*

Scale 1" = 30'

51.47' Measured Dimension
(51.26') Record Dimension

Plat of Survey of Lot 2
of Block 7 of Cool Hill
Park Add. No. 1, Town of
La Grange, Walworth Co.
Wisconsin

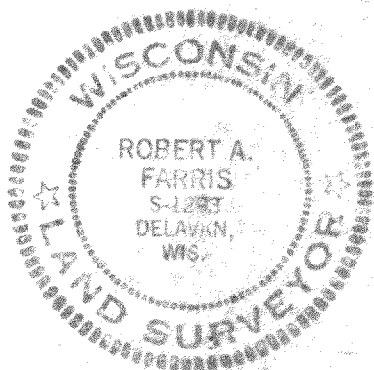

I hereby certify that I have surveyed the Feet Wide Highways Drive property described hereon and that this Plat is a correct representation of the exterior boundary and the foundation located thereon to the best of my knowledge and belief.

Robert A. Farris

ROBERT A. FARRIS RLS

DATED THIS 11th DAY OF March 1978

715 W. WALWORTH AVE. P.O. BOX 487
ELKHORN, WISCONSIN 53121
TELEPHONE 414-723-2098

DRAWING NO. 1317

ACH-2

416-285